

Cannon Land Surveying


7945 Twp. Rd. 114 NE
New Lexington, Ohio 43764
(740) 342-2835

Bearings Shown Hereon are to an Assumed Meridian and Are Used to Denote Angles Only.


Data References: U.S.G.S. Maps, Tax Maps, Deed Descriptions, and Existing Monumentation.

This Survey is Subject to any Facts That May be Disclosed by a Full and Accurate Title Search.

Scale 1" = 500'

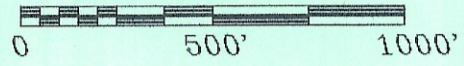

PERRY COUNTY

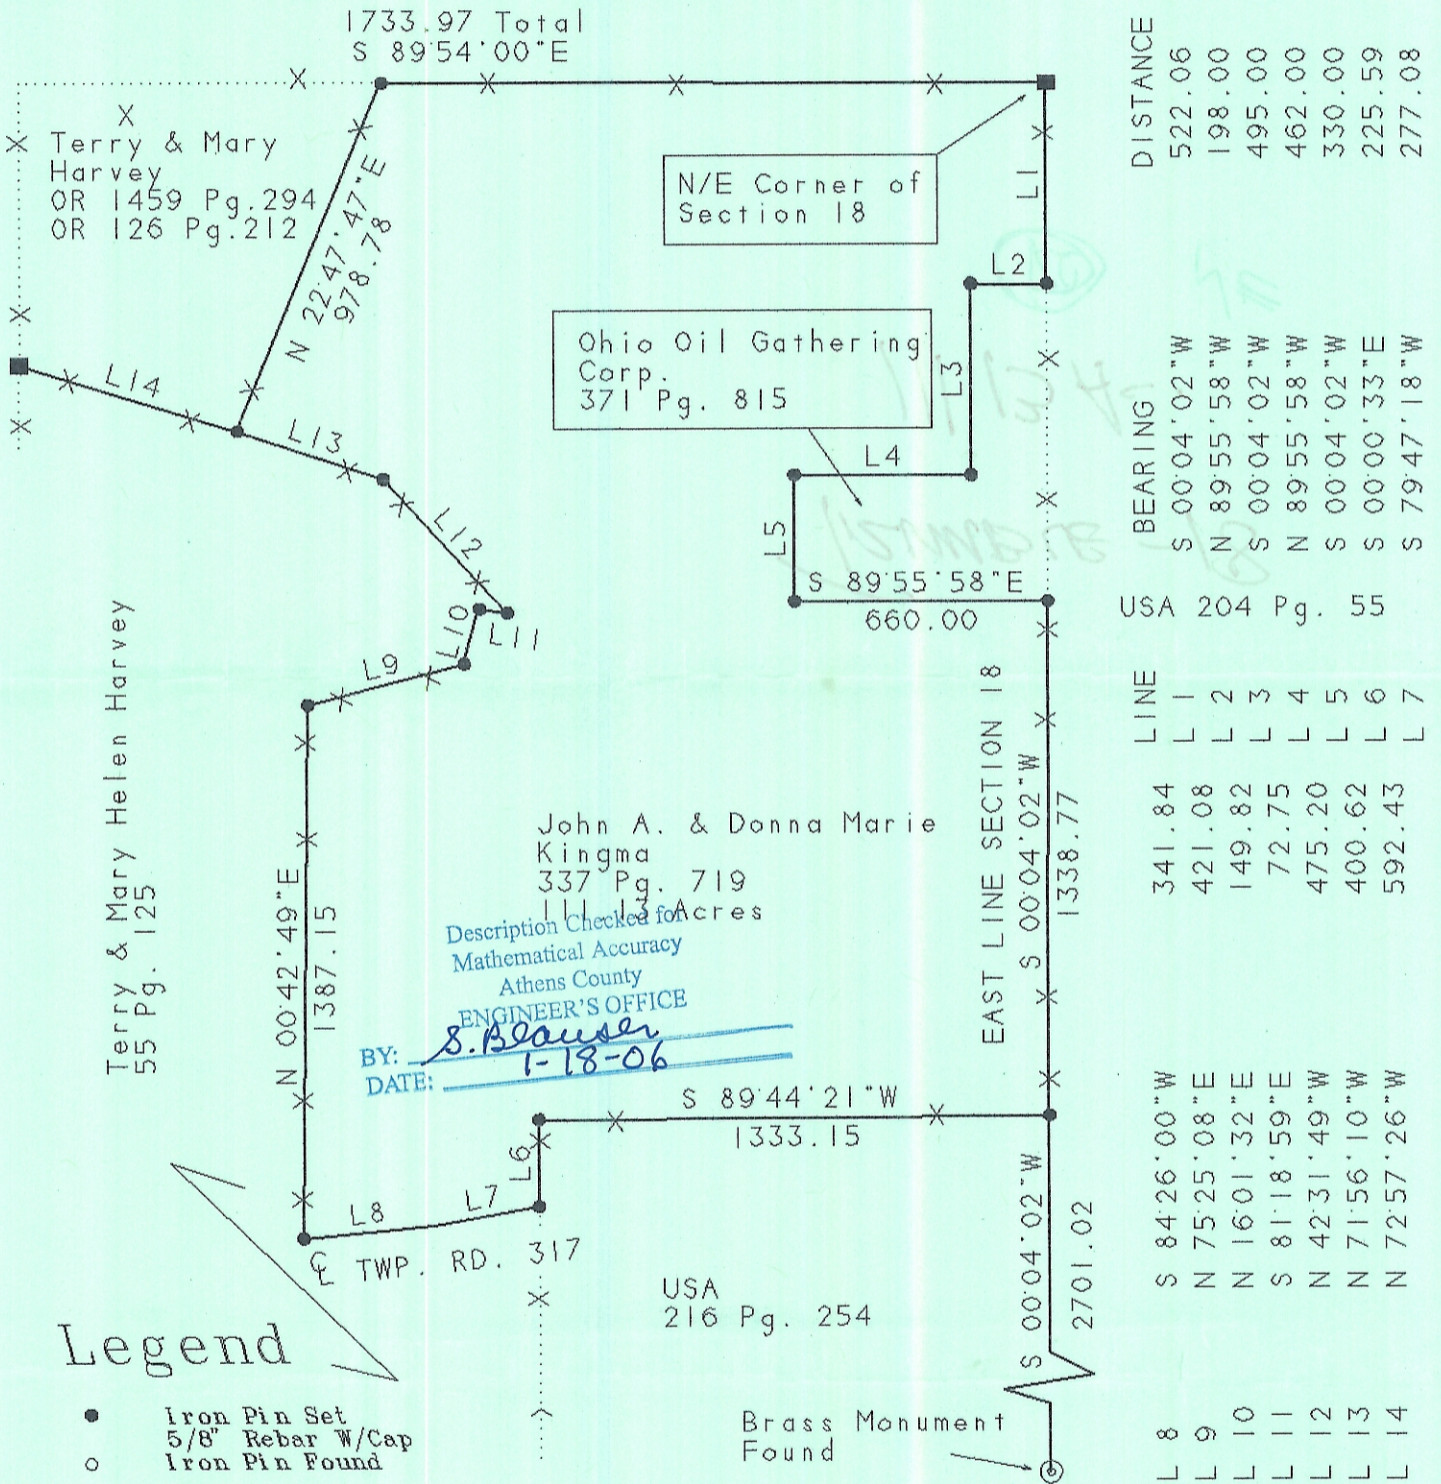

Kevin Cannon
Reg. # 7224

1/13/06
Date

Survey For: Terry Harvey
State: Ohio
County: Athens
Township: Trimble
T- 11 R- 14 Lot: N/A
Section: 18
City or Village: N/A
Subdivision: N/A
Parcel #: N/A