

Cannon Land Surveying


7945 Twp. Rd. 114 NE
New Lexington, Ohio 43764
(740) 342-2835

N

Bearings Shown Hereon are to an Assumed Meridian and Are Used to Denote Angles Only.
Data References: U.S.G.S. Maps, Tax Maps, Deed Descriptions, and Existing Monumentation.

This Survey is Subject to any Facts That May be Disclosed by a Full and Accurate Title Search.

Scale 1" = 100'

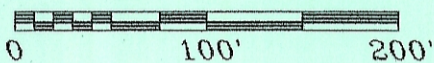


USA VOL. 301 PG. 202

LINE	BEARING	DISTANCE
L 1	S 55°49'58"E	48.19
L 2	S 56°00'35"E	89.31
L 3	S 73°37'33"E	68.23

26.34' Offset

TWP. RD. 611
MESAROS ROAD

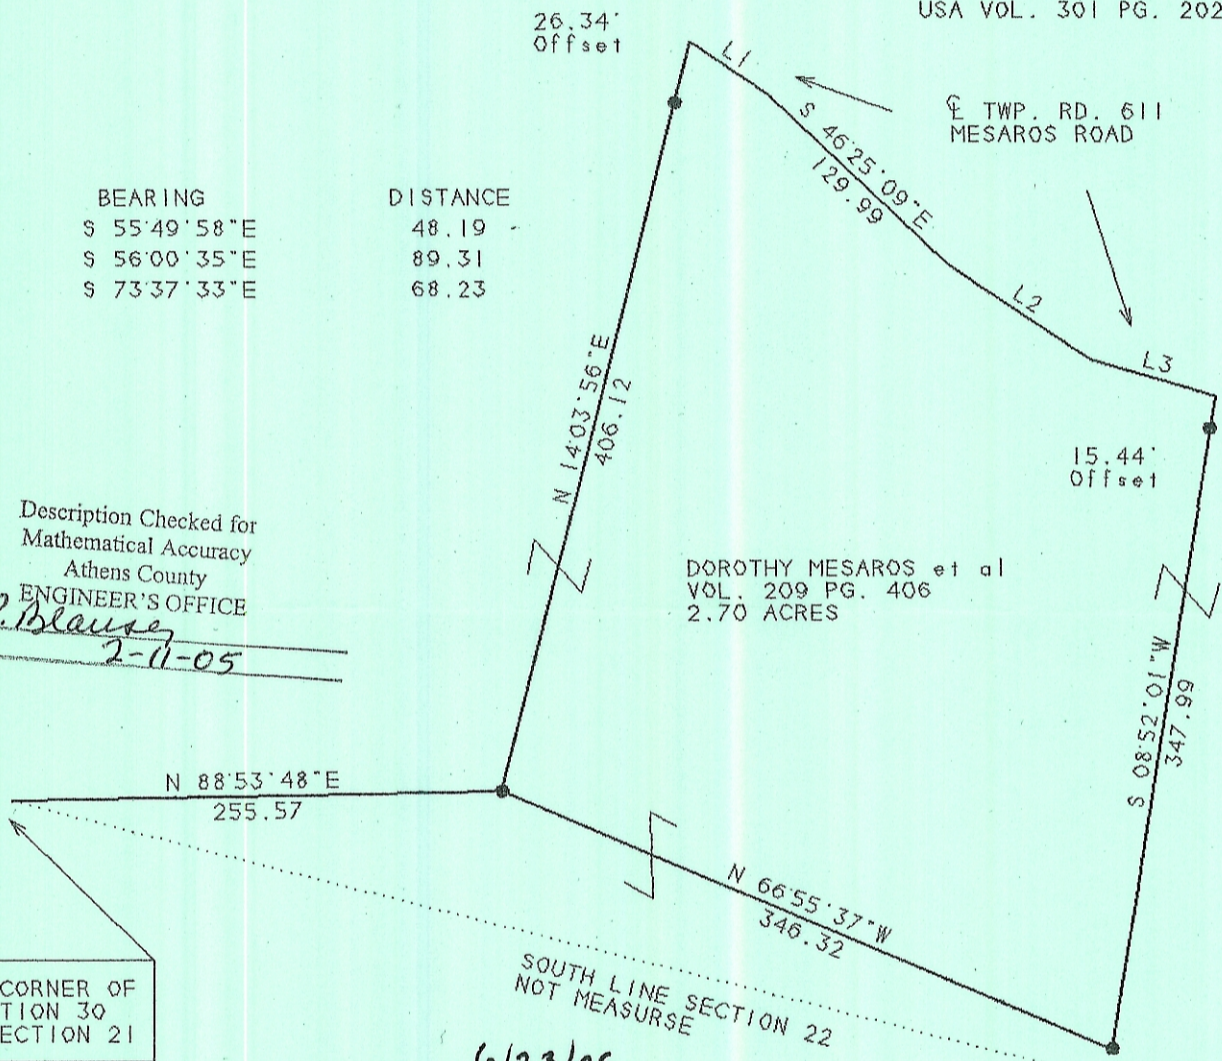

Description Checked for
Mathematical Accuracy
Athens County
ENGINEER'S OFFICE
BY: S. Blaise
DATE: 2-11-05

N/W CORNER OF
FRACTION 30
OF SECTION 21

"Approved by the Athens
County Regional Planning
Commission; No plat
Required"

Bob Eckman 6-23-05
Planning Director Date

County Engineer approval required.

Kevin Cannon
Reg. # 7224

6/23/05
"NO NEW BUILDING LOT INTENDED"
OK. to transfer per Athens City, Co.
Health Dept
C. H. Cannon, R.S.

2/10/05
Date

Legend

- Iron Pin Set
- 5/8" Rebar W/Cap
- Iron Pin Found
- ⊗ Post
- ▲ R.R. Spike Set
- △ R.R. Spike Found
- ⊙ Drilled Hole 5/8"
- Stone Found
- PK Nail Set
- ⊙ PK Nail Found
- ✕✕ Fence
- ➔ Basis Of Bearings



Survey For: Mr. Mesaros
State: Ohio
County: Athens
Township: Trimble
T-11 R-14 Lot: N/A
Section: 22 FRACTION 18
City or Village: N/A
Subdivision: N/A
Parcel #: N/A