HIGHLAND SURVEYING **80 FAYETTE STREET NELSONVILLE OHIO 45764** 614-753-1264

Description of a 5.164 Acre Tract

Situate in Section 19, T-5,R-11, Troy Township, Athens County, State of Ohio and being a part of a 39.5 acre tract as described in Volume 305, Page 873 of the Deed Records of Athens County and being more particularly described as follows:

Commencing at the Northwest corner of Section 19, thence South 2°40'42"West, 10.00 Chains (deed), thence South 87°19'18"East, 12.00 Chains (deed), thence continuing South 87°19'18"East, 549.18 feet, thence South 2°40'55"West, 736.78 feet to an iron pin set at the point of beginning of this tract

THENCE along grantors north line South 86°30'22"East, 389.61 feet to an iron pin set,

THENCE along new lines the following three courses;

South 2°40'55"West, 370.00 feet to an iron pin set, North 86°30'22"West, 210.70 feet to an iron pin set, South 2°40'55"West, 446.91 feet to a point in the center of Twp-163 (passing an iron pin set at 416.91 feet,


THENCE along the center of said road North 89°36'10"West, 179.03 feet to a point,

THENCE along grantors East line North 2°40'55"East, 826.58 feet to the point of beginning (passing an iron pin set by previous survey at 30.00 feet) and containing 5.164 acres.

Subject to all Easements and Rights of Way of Record

Bearings are to an assumed meridian and are for angular determination only

eth L KENN E. HIGHLAN S-7581 S-7581 CVAL LAND Kenneth E. Highland S-7581

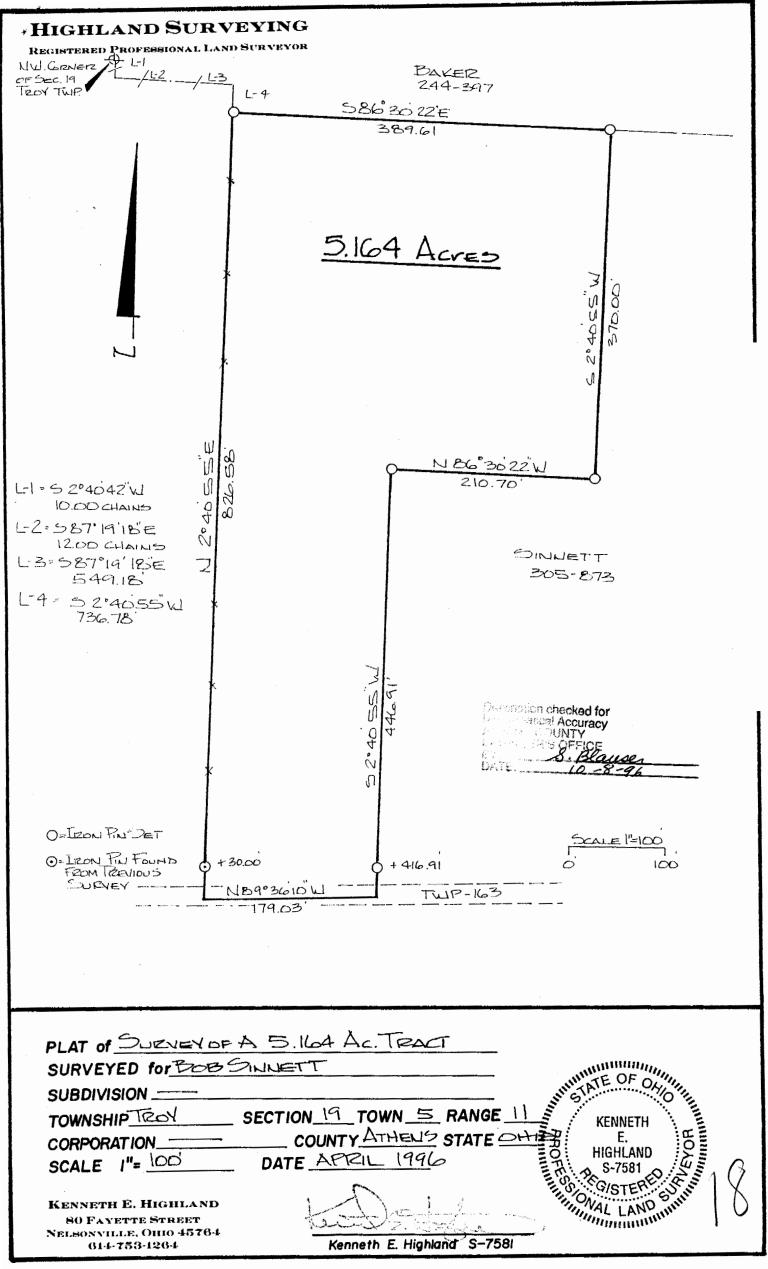

KENNETH E. HIGHLAND 80 FAYETTE STREET Nelsonville, Ohio 45764 614-753-1264

Kenneth E. Highland S-7581