

FOR P. Howard E. Shanks

DATE: 7 June 1977

Situate in F.R. 23, Section 22, Town 5-N, Range 11-W, Troy Township, Athens County, State of Ohio and being more particularly described as follows:

Commencing at a stone in the Southeast corner of F.R. 23 (Section 22); thence N 86°08'20" W along the South line of said F.R. 23, 661.80 feet to a stone; thence N 02°18'40" E along a line, 523.20 feet to a mine spike set in the centerline intersection of Troy Township Road No. 175 and Athens County Road No. 59; thence N 11°22'40" E along the centerline of said Athens County Road No. 59, 395.63 feet to a railroad spike set in the Grantor's Southeast corner, said railroad spike set also being the real point of beginning of the parcel herein described:

Thence N 86°03'43" W along the Grantor's South line, 374.85 feet to an iron set; thence N 52°26'24" E along a random line, 405.05 feet to an iron set, passing through an additional iron set at 146.25 feet; thence S 85°59'42" E along a random line that is parallel to the Grantor's North line, 105.77 feet to a railroad spike set in the said centerline of Athens County Road No. 59 and the Grantor's East line, said railroad spike bearing S 11°40'27" W, 63.63 feet from a railroad spike set in the Grantor's Northeast corner, passing through an iron set at 85.77 feet; thence the following courses and distances along said centerline of Athens County Road No. 59 and said Grantor's East line:


S 11°40'27" W, 80.75 feet to a mine spike set;
S 11°00'05" W, 173.45 feet to a mine spike set;
S 11°22'40" W, 16.13 feet to the point of beginning and containing 1.4786 acres.

Subject to all legal highways and easements of record.

Grantor claims title for the above described parcel by Deed Book 174, Page L26 as recorded in the Athens County Recorder's Office, Athens County, Ohio.

The above description is based on a survey by Gerald W. Bayha, Registered Professional Surveyor No. S-6139 (Job No. 577-02), completed on 7 June 1977.

23

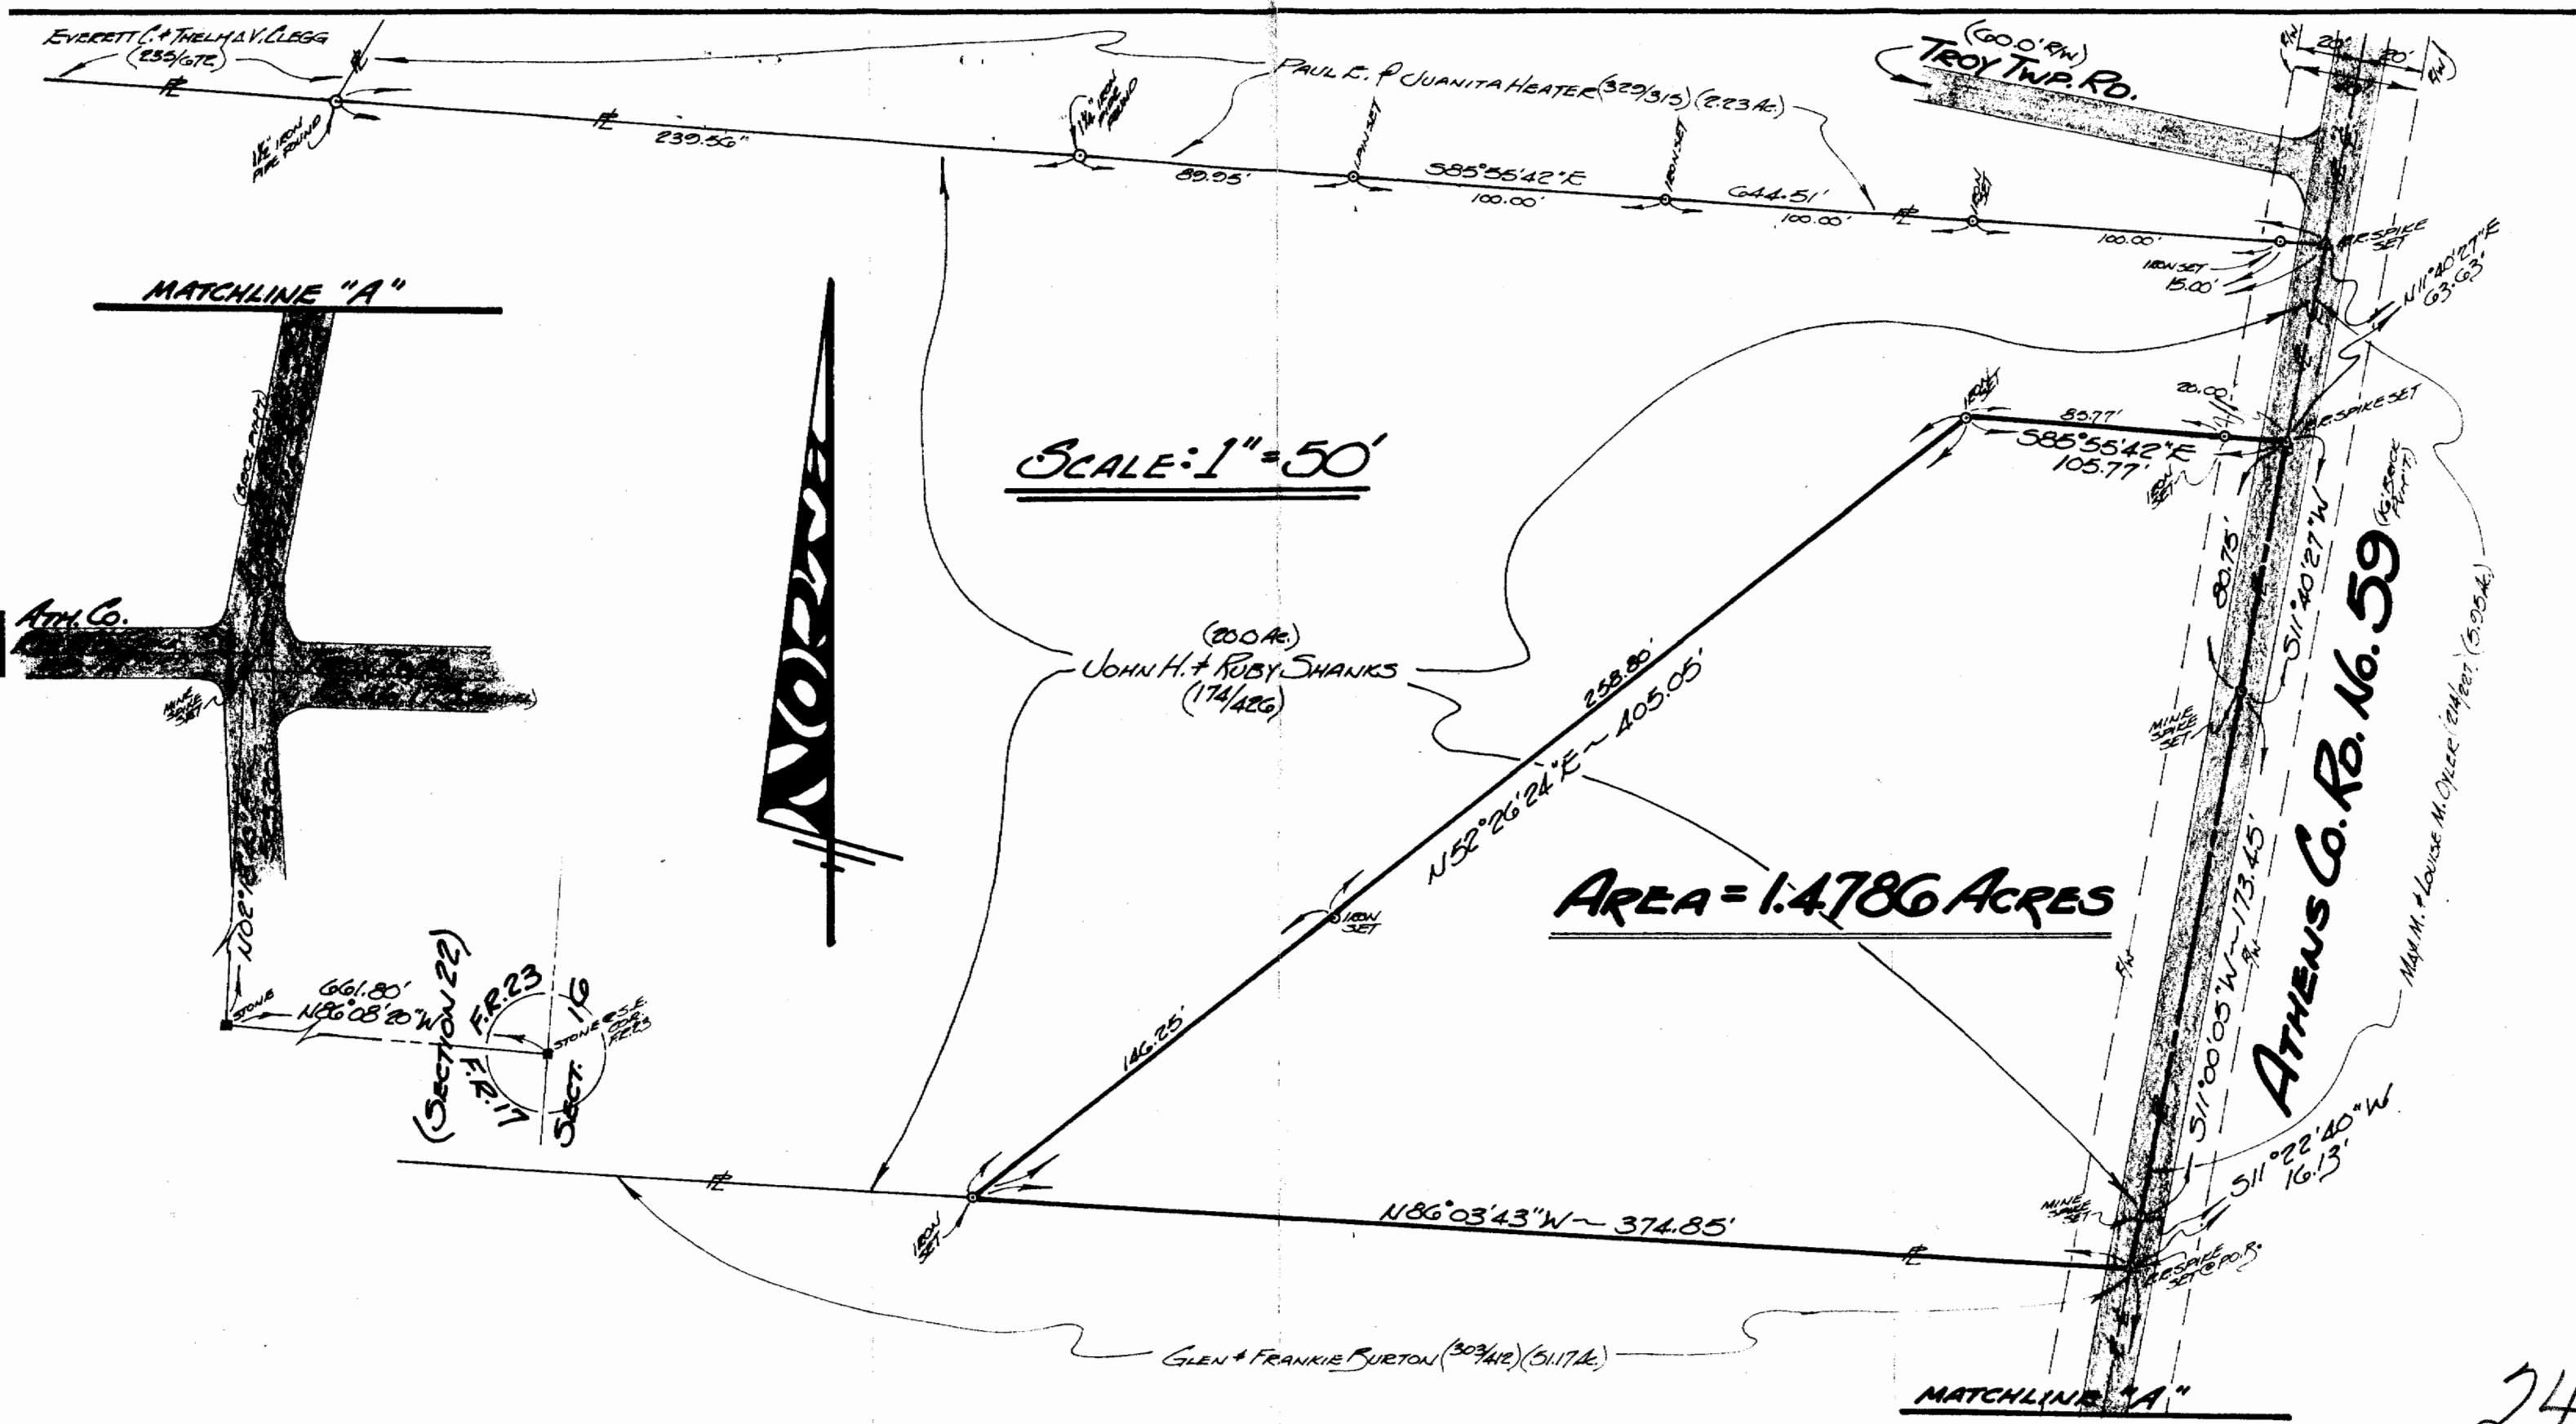

FOR:	PLAT OF SURVEY				
BY:	OF A 1.4786 ACRE PARCEL SITUATE IN F.R. 23 ~ SECTION 22 ~ TOWN 5-N ~ RANGE 11-W ~ TROY TOWNSHIP ~ ATHENS COUNTY ~ OHIO ~ U.S.A.				
	DRAWN	CHECKED	REVISIONS	DATE	DEBT.
	S	S		7 JUNE '77	#577-02
	SHEET NO. 1				