

NE Quarter  
SE Quarter

OK Joe Fasler, R.S.  
Athens City - County  
Health Dept.  
10/21/82


Arnold N. & Frances H.  
Spencer

Volume 362 Page 949  
Sec. 19, Town 5, Range 11

Addie B. Jackson  
Vol. 226 Pg. 33

3.50 Ac.  
System installed  
May 11, 1982

102

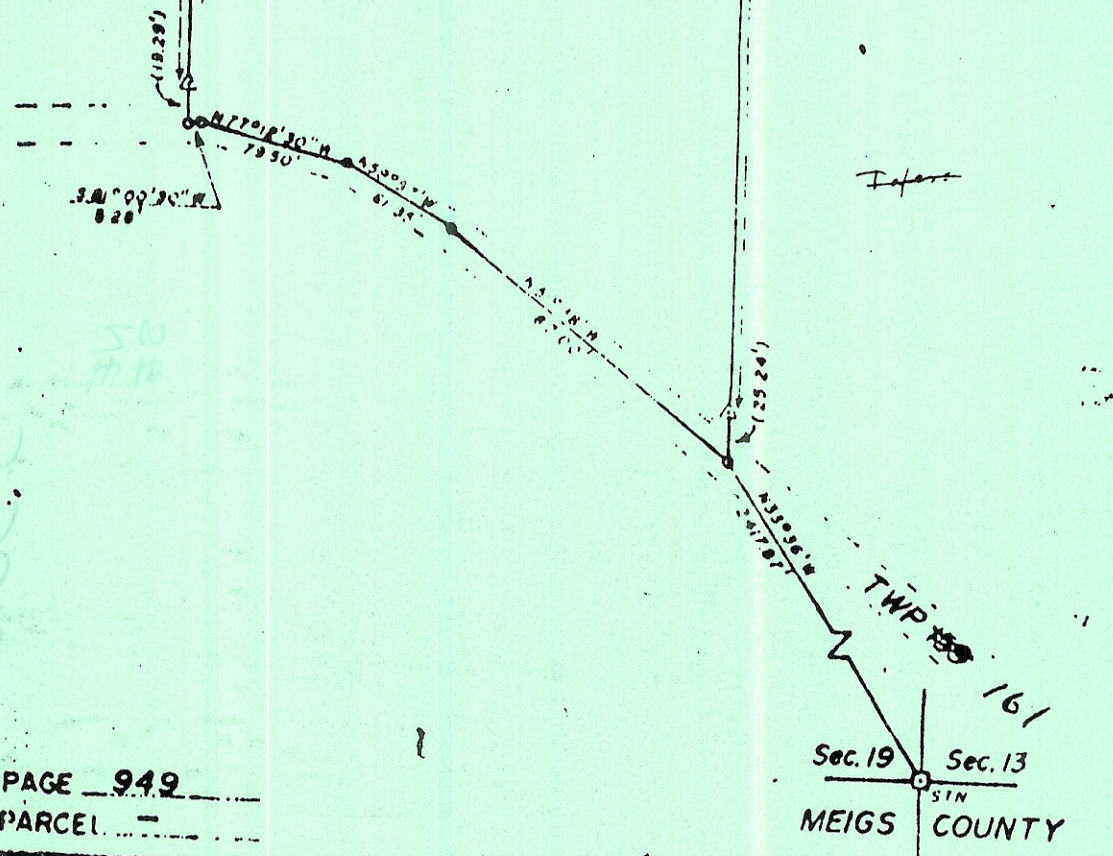

KEY

- Nail in E Road
- Iron Pin

BOOK 362 PAGE 949  
SHEET - PARCEL -

TWP 161  
Sec. 19 Sec. 13  
STN  
MEIGS COUNTY

PLAT OF SURVEY OF

Part of Parcel Owned by Arnold N & Frances H. Spencer  
Section - 19

