
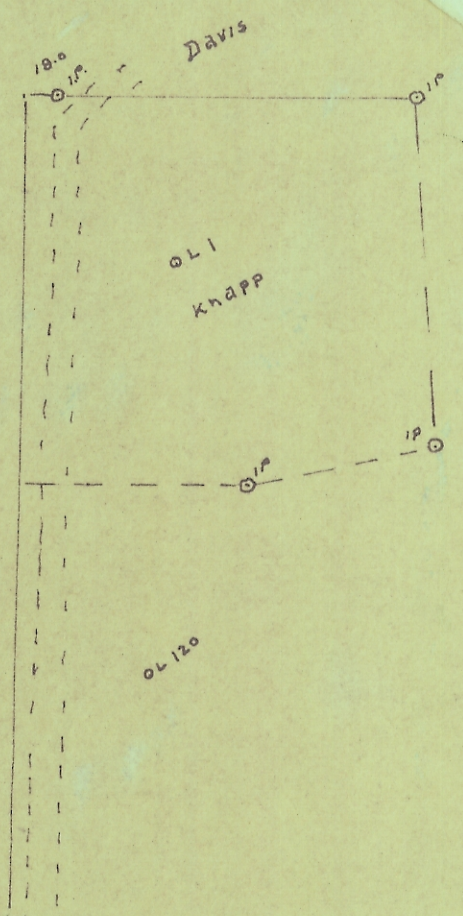


Coolville

JOE GALVIN SURVEY OF TRACT IN

COOLVILLE

SCALE 1" = 100'

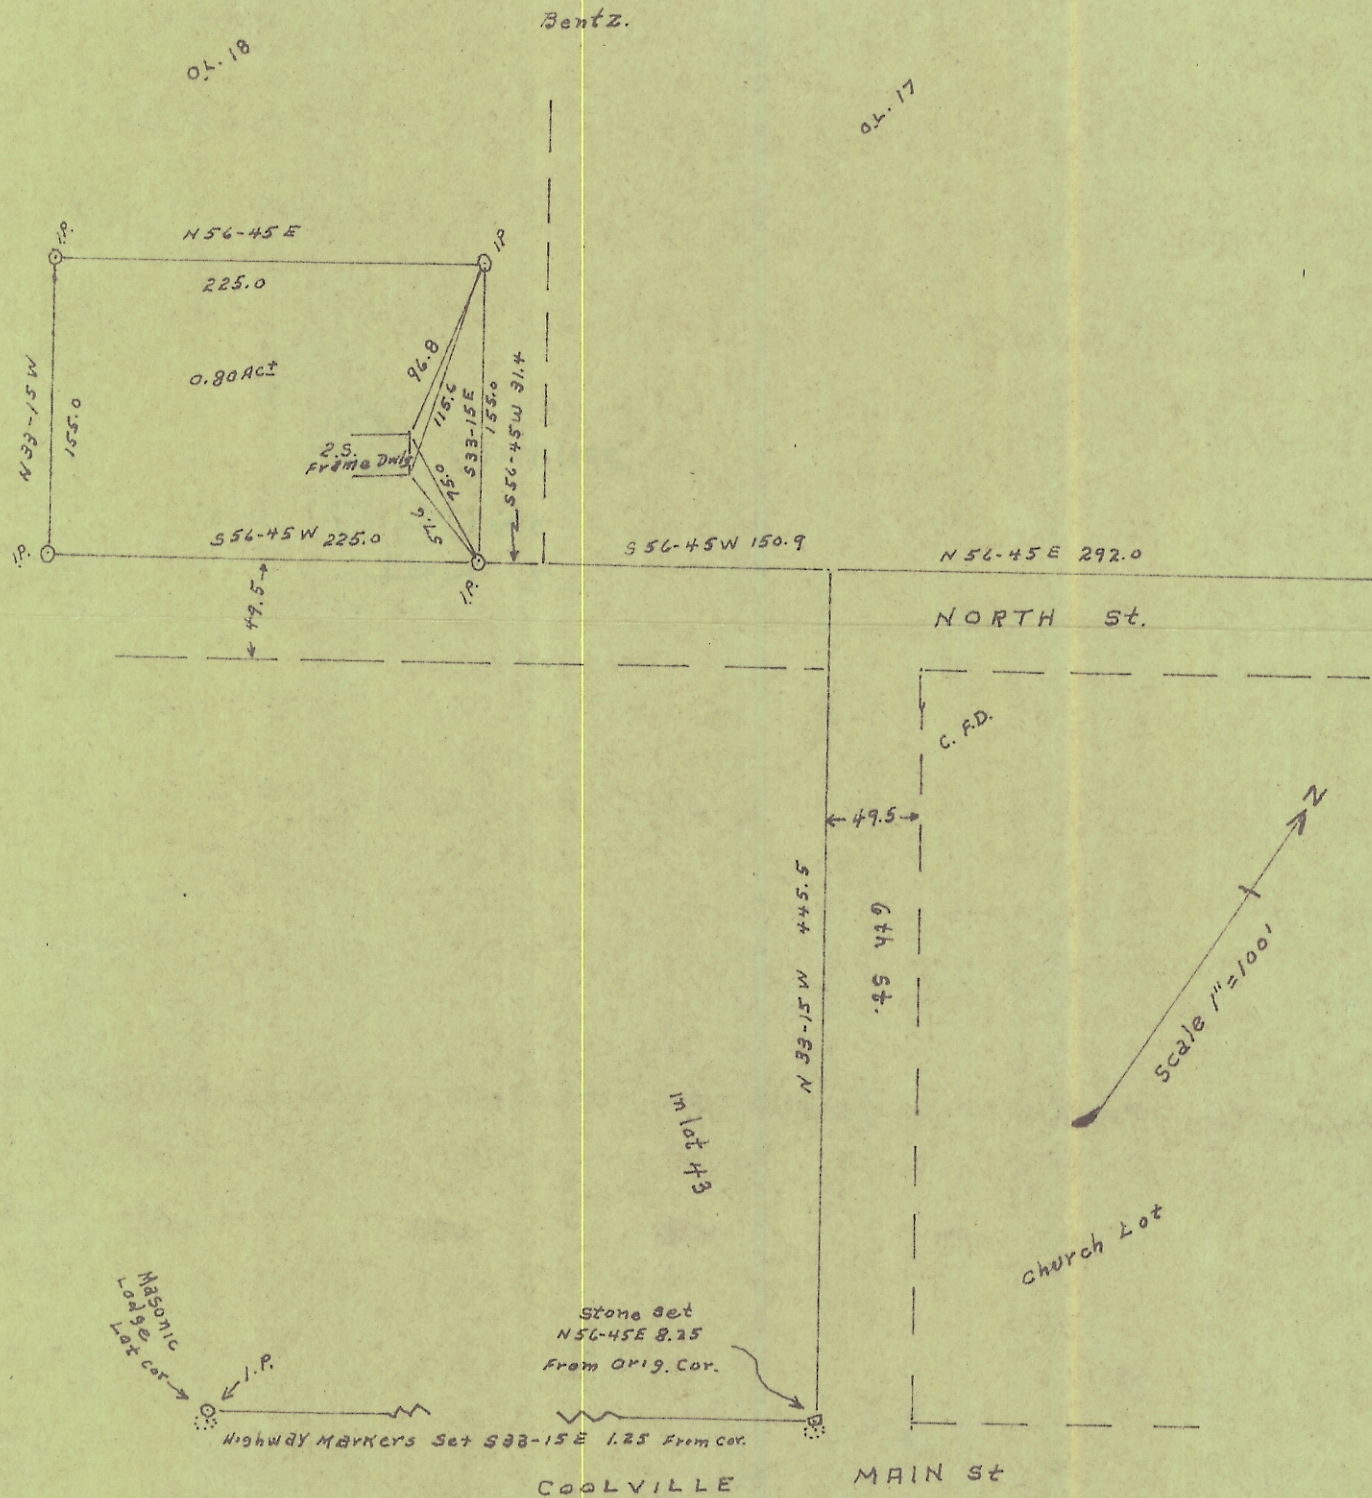

PLAT
 of 0.80 Act Tract
 in Out Lot 18 in Village
 of Coolville Ohio
 Sit. in Fr 18 Sec 22
 Troy Twp. Athens Co. O.
 surveyed 3-31-59
 For C.M. Bentz.
 By Joe L. Galvin
 Reg. Sur. 1694