


THIS PROPERTY APPEARS TO BE IN FLOOD ZONE _____ AS SHOWN ON F.E.M.A. FLOOD MAP;
 COMMUNITY NUMBER 390760 PANEL NUMBER 0006A DATED 12-9-77

CERTIFICATION: WE HEREBY CERTIFY THAT THE FOREGOING MORTGAGE LOCATION SURVEY WAS PREPARED FROM ACTUAL FIELD MEASUREMENTS IN ACCORDANCE WITH CHAPTER 4733-38, OHIO ADMINISTRATIVE CODE, AND IS NOT A BOUNDARY SURVEY PURSUANT TO CHAPTER 4733-37 OF SAID CODE.

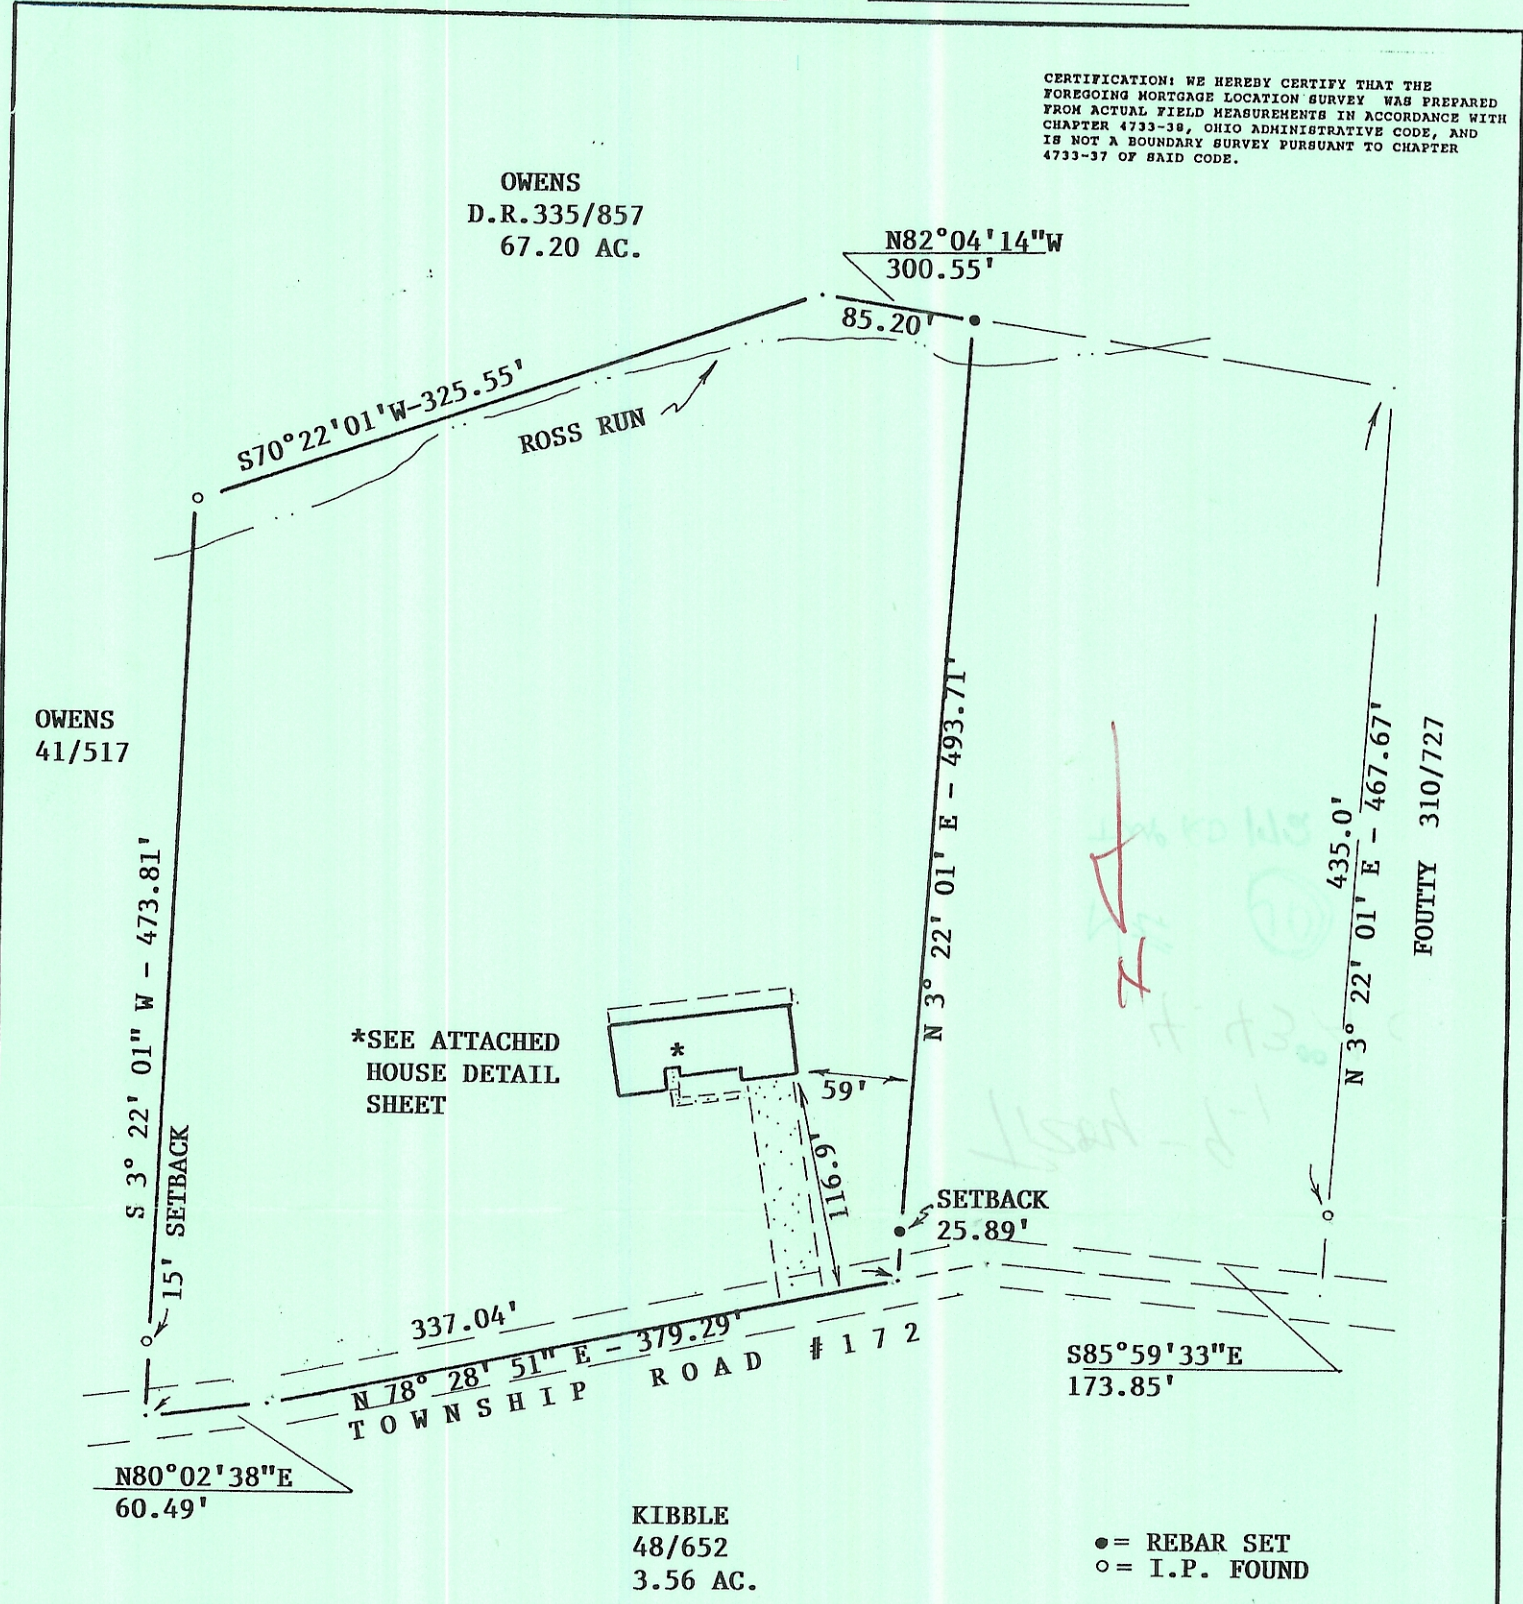


DATE: 09-26-92

SCALE 1" = 100'

PLAT OF	TOWNSHIP ROAD #172
MORTGAGE LOCATION SURVEY FOR	BENJAMIN BARNETT & LORRAINE BARNETT
SUBDIVISION	FRACTION #3
TOWNSHIP	TROY SECTION 9, TOWN 5, RANGE 11
CORPORATION	
COUNTY	WASHINGTON STATE OHIO

WATERMAN-DOUGLASS & ASSOCIATES

Nelson B. Douglass
NELSON B. DOUGLASS P.S. #7296
 2817 MURDOCH AVENUE
 P.O. BOX 126
 PARKERSBURG, WV 26102-0126
 1-304-428-5715

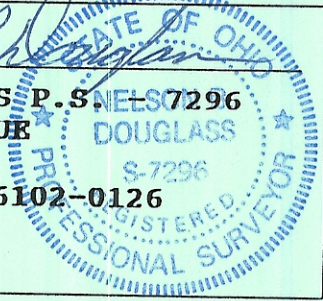

REFERENCES

OFFICIAL RECORD 46, PAGE 368
TAX MAP #TROY SECTION 9

PROJECT NUMBER - 92-811