

HAROLD D. ("DALE") WHALEY

REGISTERED SURVEYOR NO. 4986

ALBANY, OHIO 45710

Lots, Farms, Subdivisions and Construction Staking

15.004 Acres
Frank Hutchinson

Situated in Section No. 10 & Section No. 11, T. 11, R. 15, Waterloo Township, Athens County, Ohio, and being more particularly described as follows:

Beginning at a point on the line between Sec. 10 & Sec. 11, N. 83° 05' 40" W., 548.82 feet from the Southeast corner of the Northwest Quarter of Sec. No. 11;

Thence S. 16° 50' 30" W., 331.98 feet to an iron pin;

Thence N. 83° 05' 40" W., 742.54 feet to an iron pin;

Thence N. 6° 44' 56" E., 327.00 feet to an iron pin on the line between Section 10 & Section 11;

Thence along said Section line, N. 83° 05' 40" W., 336.50 feet to an iron pin;

Thence N. 6° 44' 56" E., 330.00 feet to an iron pin in T. R. No. 259;

Thence along the centerline of T. R. No. 259, S. 83° 05' 40" E., 336.50 feet to an iron pin;

Thence N. 74° 50' 01" E., 183.70 feet to an iron pin;

Thence S. 89° 03' E., 90.89 feet to an iron pin;

Thence S. 73° 59' E., 117.50 feet to an iron pin;

Thence S. 67° 23' 51" E., 326.43 feet to an iron pin;

Thence S. 64° 09' 30" E., 162.70 feet to an iron pin;

Thence leaving the highway, S. 16° 50' 30" W., 252.52 feet to the point of beginning, containing 15.004 acres, of which 5.7911 acres are in Sec. No. 10 and 9.2129 acres are in Section 11 and being all of a 2.55 acre tract described in Vol. 269, Page 652 and part of the 10 acre tract, and part of the 20 acre tract described in Vol. 269, Page 652 of the Athens County Deed Records.

Surveyed July, 1975 by HAROLD D. WHALEY

Harold D. Whaley
Reg. Surveyor No. 4786

Description checked for

Mathematical Accuracy


ATHENS COUNTY

ENGINEER'S OFFICE

BY *Bruce D. McPherson*

DATE: *August 18, 1975*

WATERLOO SEPT. 1975
16

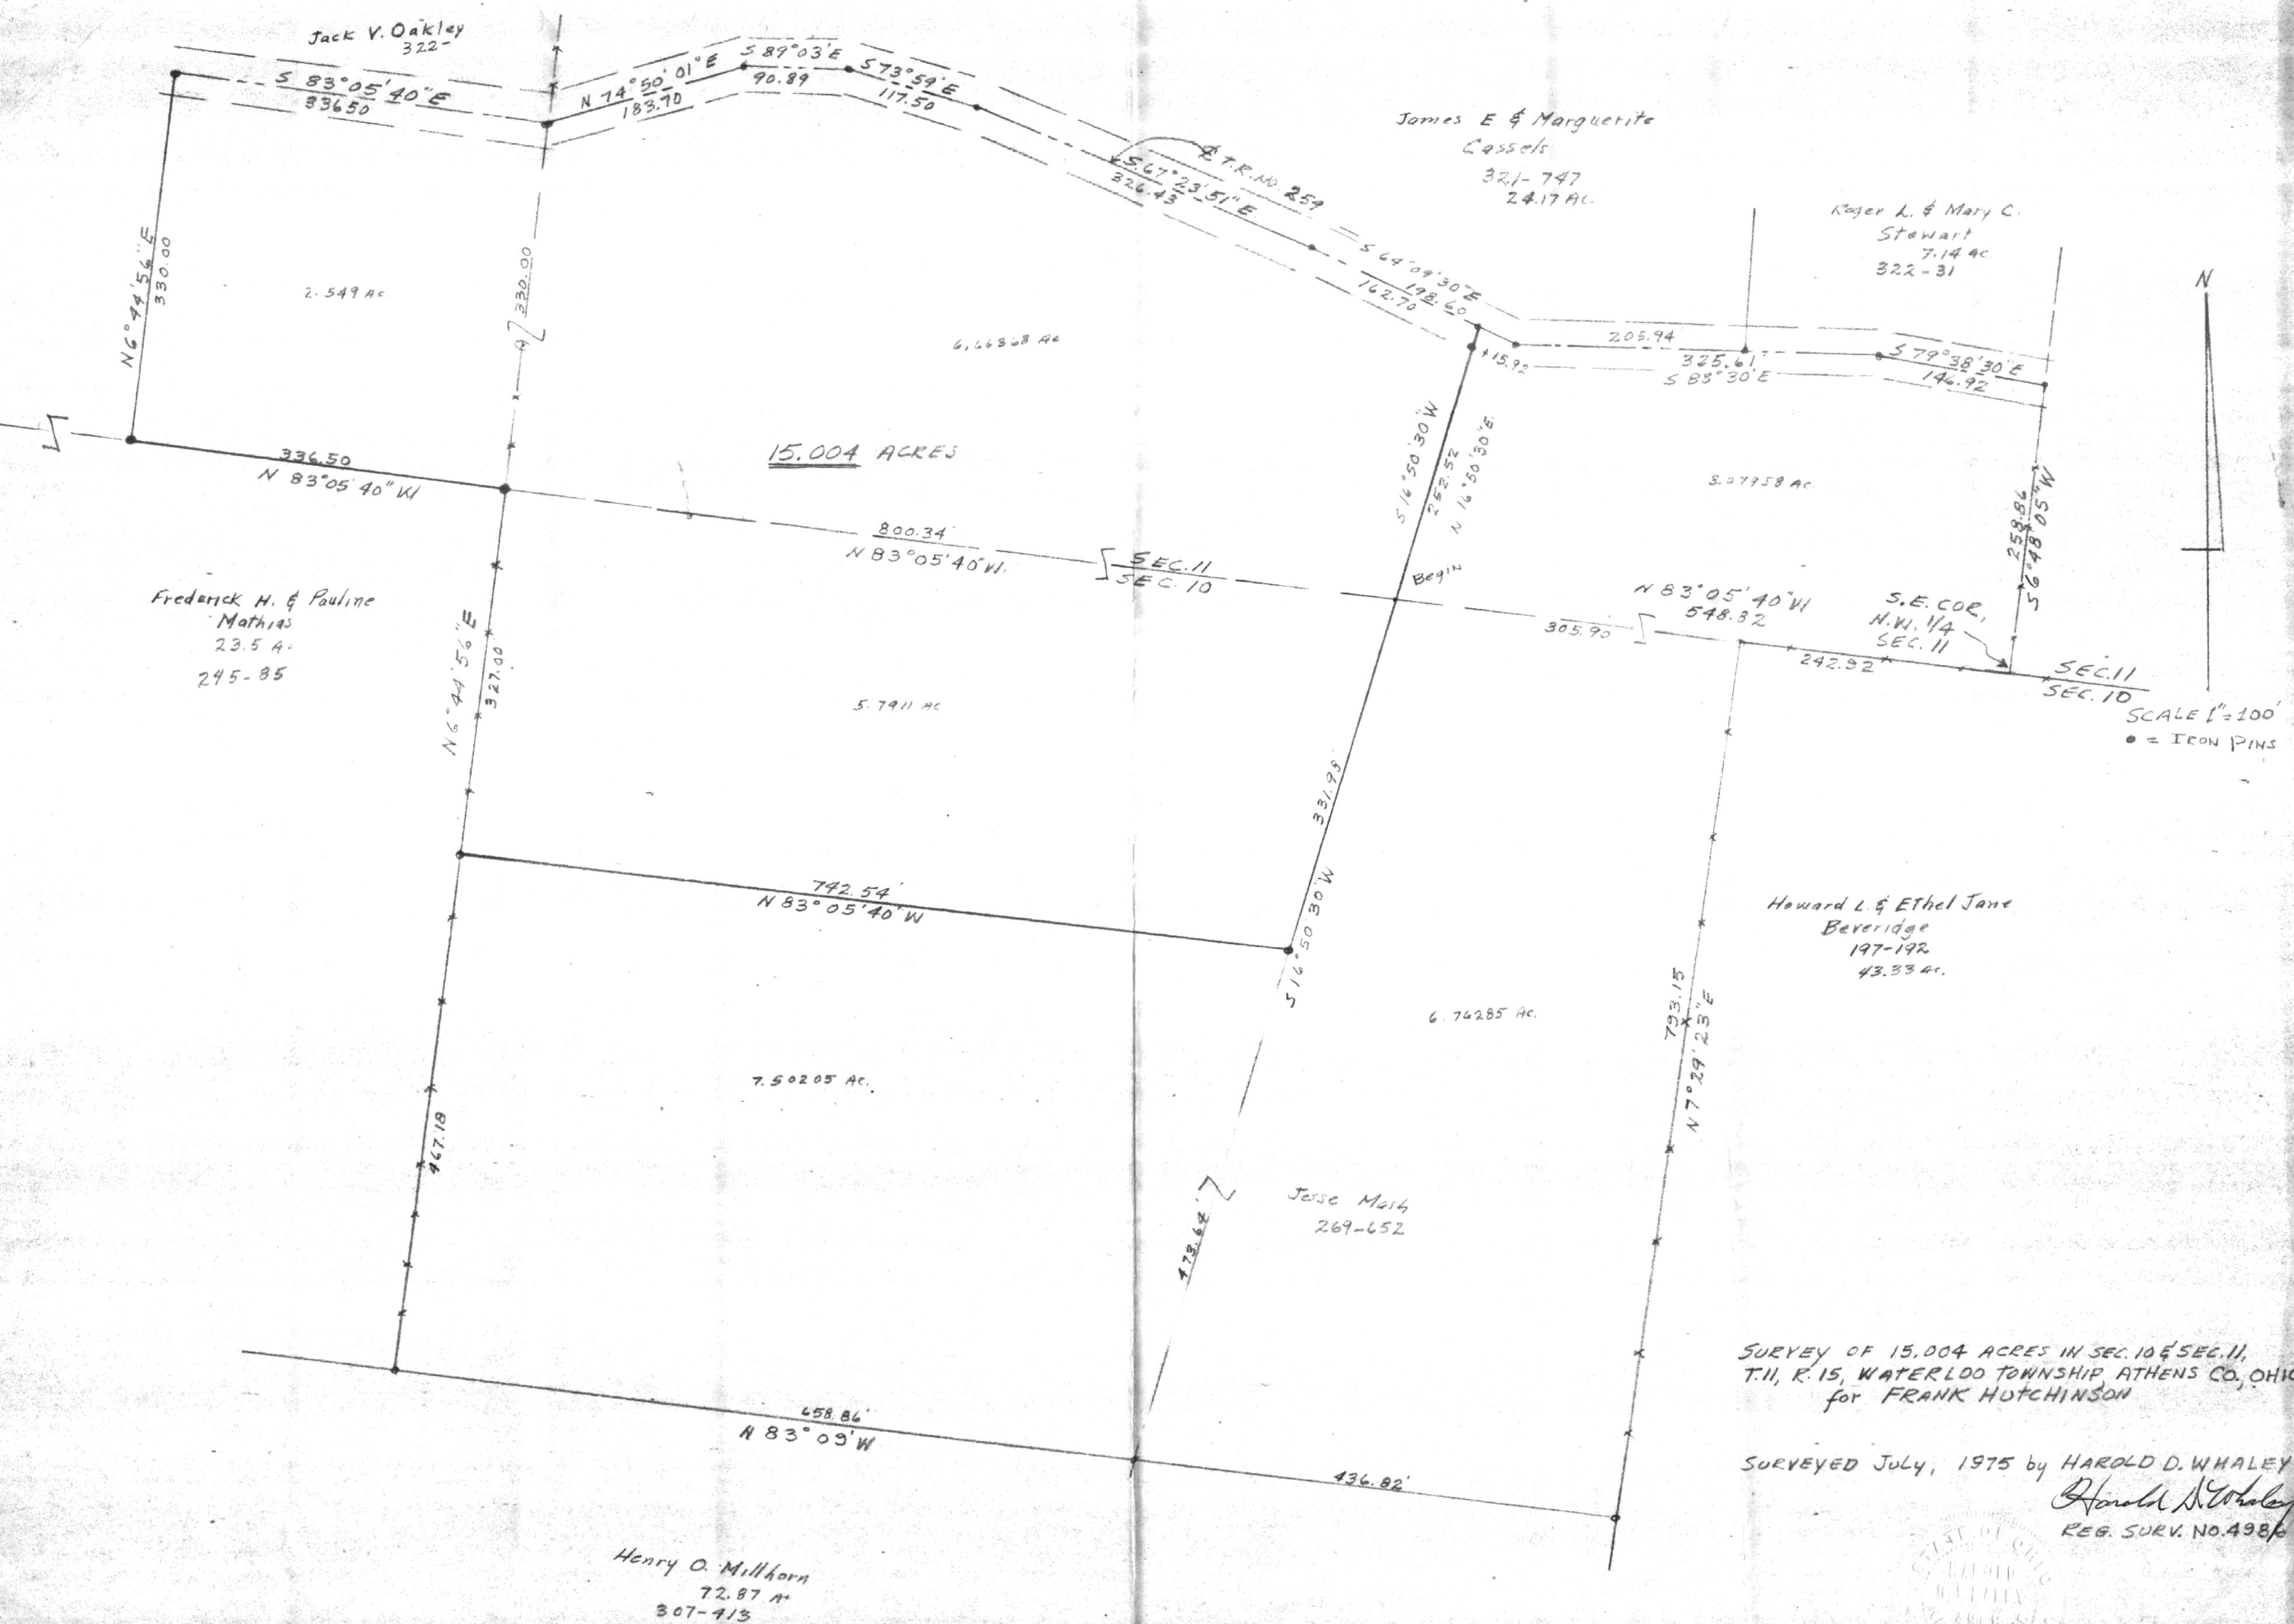

SURVEY OF 15,004 ACRES IN SEC. 10 & SEC. 11,
T. 11, R. 15, WATERLOO TOWNSHIP ATHENS CO., OHIO
FOR FRANK HUTCHINSON

SURVEYED JULY, 1975 by HAROLD D. WHALEY

Harold S. Whaley
REG. SURV. NO. 4986