

SOUTHEASTERN LAND SURVEYS

LEONARD F. SWOYER REGISTERED PROFESSIONAL LAND SURVEYOR

3428 Pleasant Hill Road Athens, Ohio 45701 614/593-8701

TRACT 2

Situated in Fraction 1, Section 15, Waterloo Township, Town 11, Range 15, Athens County, Ohio.

Commencing at a railroad spike (calculated location) at the northeast corner of said Fraction 1; thence on an assumed bearing of South 73°55' 23" West 1,886.91 feet to a set P.K. nail in the centerline of Athens County Road 6, said P.K. nail is the northwest corner of the tract to be described and THE TRUE POINT OF BEGINNING; thence South 02°03'27" West (passing a set iron pin at 12.00 feet) for a total distance of 281.35 feet to a set iron pin on the north right of way line of the B.& O. Railr oad; thence along said right of way on a curve to the right 122.96 feet to a point, said curve has a radius of 2,924.42 feet and a chord which bears North 80°12'03" West 122.95 feet; thence along said right of way North 03°09'08" East 9.14 feet to a point; thence along said right of way on a curve to the right 233.80 feet to a point, said curve has a radius of 2,915.37 feet and a chord which bears North 76°40'30" West 233.73 feet; thence along said right of way on a curve to the right 57.64 feet to a set iron pin, said curve has a radius of 2,789.93 feet and a chord which bears North 73°47'07" West 57.64 feet; thence leaving said railroad right of way North 11°23'47" East (passing a set iron pin at 105.77 feet) for a total distance of 206.19 feet to a set railroad spike in the center of said Athens County Road 6; thence along the centerline of said road the following three bearings and distances:

- 1) South 82°02'35" East 40.96 feet to a point; thence
- 2) South 84°28'10" East 115.34 feet to a point; thence
- 3) South 87°45'28" East 139.28 feet to a point; thence
- 4) North 89°04'39" East 78.27 feet to the point of beginning containing 2.1744 acres and being a part of the first tract of land conveyed in Volume 282 Page 661 of the Athens County Deed Records.

Description checked for Mathematical Accuracy ATHENS COUNTY ENGINEER'S OFFICE BY:

BY: ____ DATE: ___

SUBDIVISIONS

CONSTRUCTION

PROPERTY



SOUTHEASTERN LAND SURVEYS

LEONARD F. SWOYER REGISTERED PROFESSIONAL LAND SURVEYOR

3428 Pleasant Hill Road Athens, Ohio 45701 614/593-8701

Note: Unless otherwise noted all set iron pins are 5/8 inch in diameter and 30 inches in length and capped with a plastic identification marker scribed Leonard F. Swoyer R.L.S. 6765.

The above description was prepared under the supervision of Leonard F. Swoyer Registered Professional Land Surveyor Number 6765 and based on a survey performed by Southeastern Land Surveys dated September 10,1990


Subject to all easements and right of ways of record.

37A

PROPERTY

CONSTRUCTION

SUBDIVISIONS

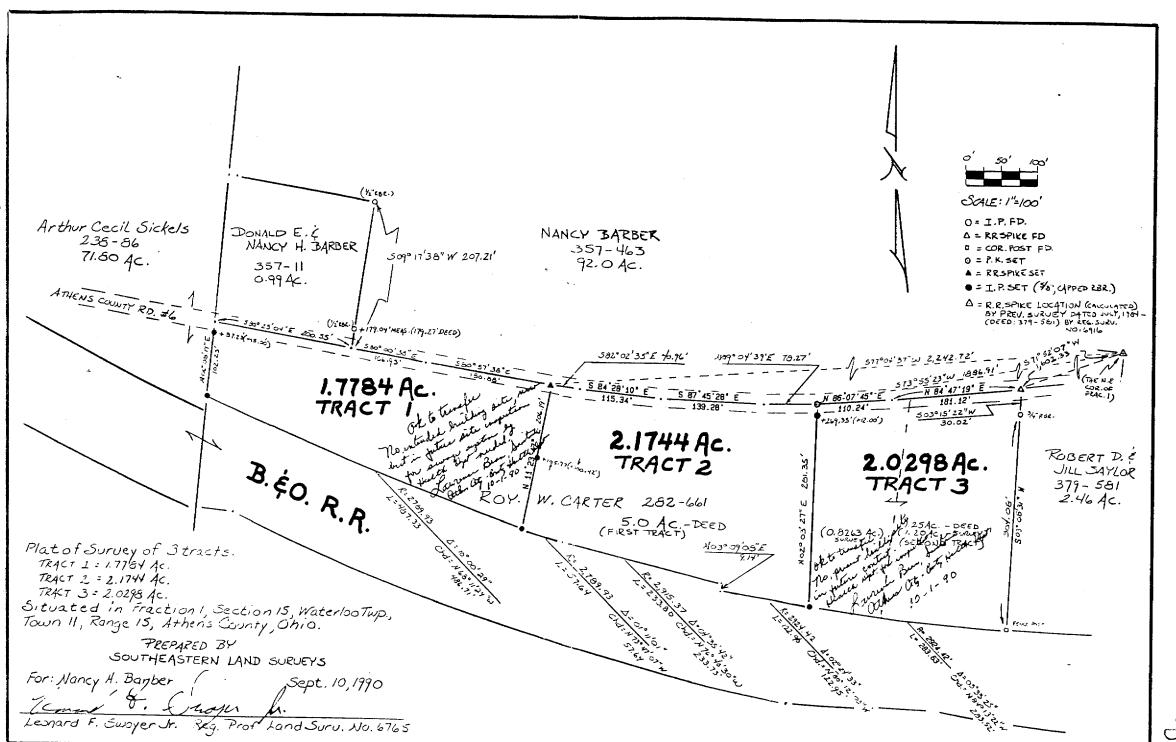

SINTOM

39