

*Waterloo  
see 24*

DESCRIPTION - 1.00 ACRES

Situated in the Township of Waterloo, County of Athens, State of Ohio and being a part of the northwest quarter of Section 24, Town 11, Range 15, more particularly described as follows:

Commencing at the center of section 24; thence north  $4^{\circ}30'$  east along the half section line 517.61 feet to an iron pin set, the place of beginning for the tract of land herein described, passing through an iron pin found at 104.07 feet; thence north  $85^{\circ}30'$  west 154.55 feet to an iron pin set; thence north  $4^{\circ}30'$  east 263.33 feet to a point in Waterloo Township Road 260, passing through an iron pin set at 241.54 feet; thence north  $81^{\circ}01'$  east along the center line of the Township Road 158.93 feet to a point at the intersection of the Township Road and Athens County Road 3; thence south  $4^{\circ}30'$  west along the half section line 300.39 feet to the place of beginning and containing one acre.

Subject to all legal rights of way and easements of record.


This description was prepared from an actual survey of the premises made by me in July, 1983.

William M. Watkins  
Registered Surveyor #S5216

Description checked for  
Mathematical Accuracy  
ATHENS COUNTY  
ENGINEER'S OFFICE

*Charles Murphy  
7-18-83*

25

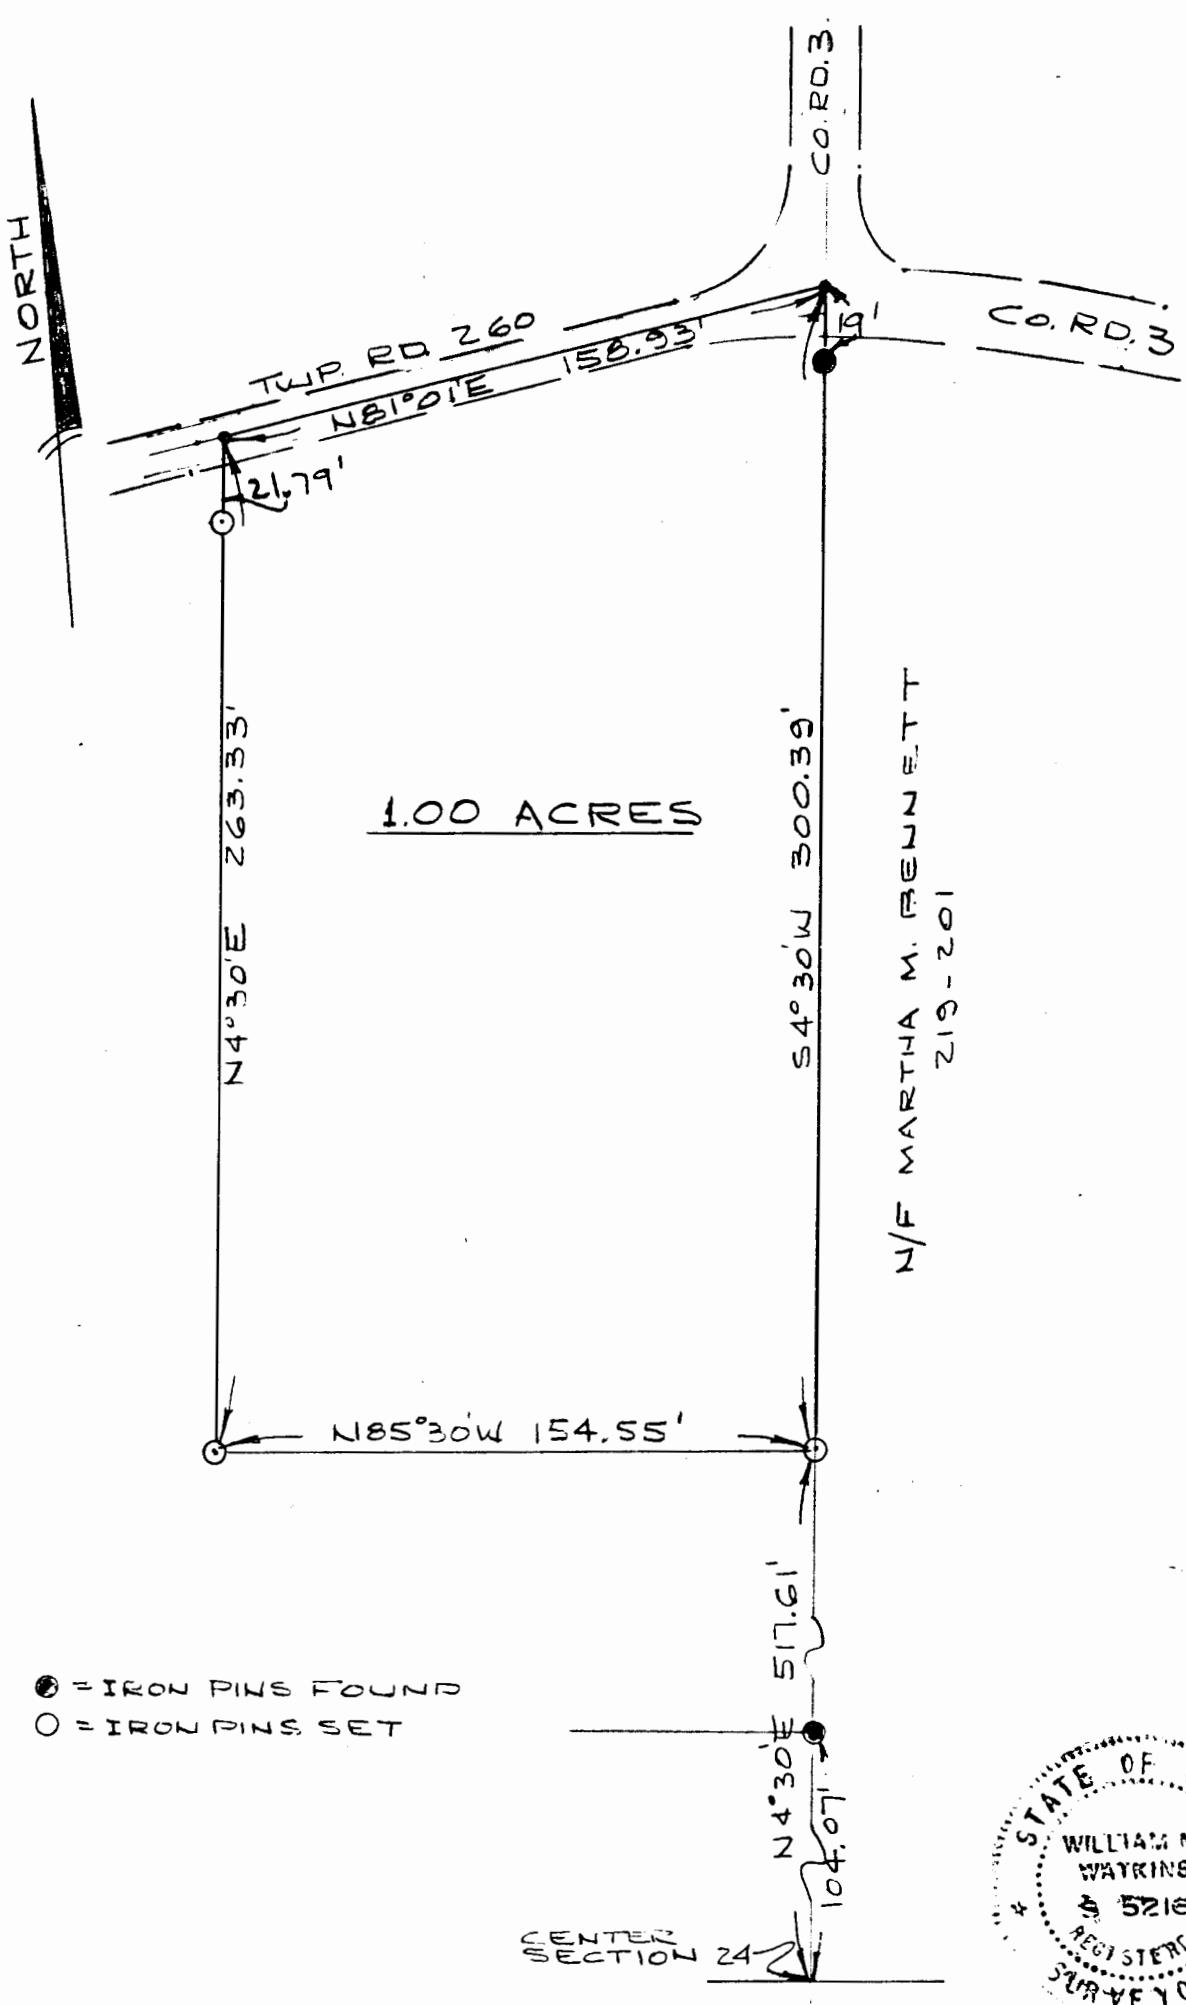

PLAT OF SURVEY - 1.00 ACRES  
PART OF

VOLUME , PAGE  
N.W.  $\frac{1}{4}$ , SECTION 24, TOWN 11, RANGE 15  
WATERLOO TWP., ATHENS CO., OHIO

SCALE: 1" = 50'

JULY 18, 1983

THIS PLAT WAS PREPARED FROM AN ACTUAL  
SURVEY OF THE PREMISES MADE BY ME IN  
JULY, 1983.

William M. Watkins  
REGISTERED SURVEYOR NO. S-5216

26