


STATE OF OHIO
ATHENS COUNTY

WATERLOO TOWNSHIP SECTION 5 T11 R15

PROPERTY OF CARL AND SHARON TOPE

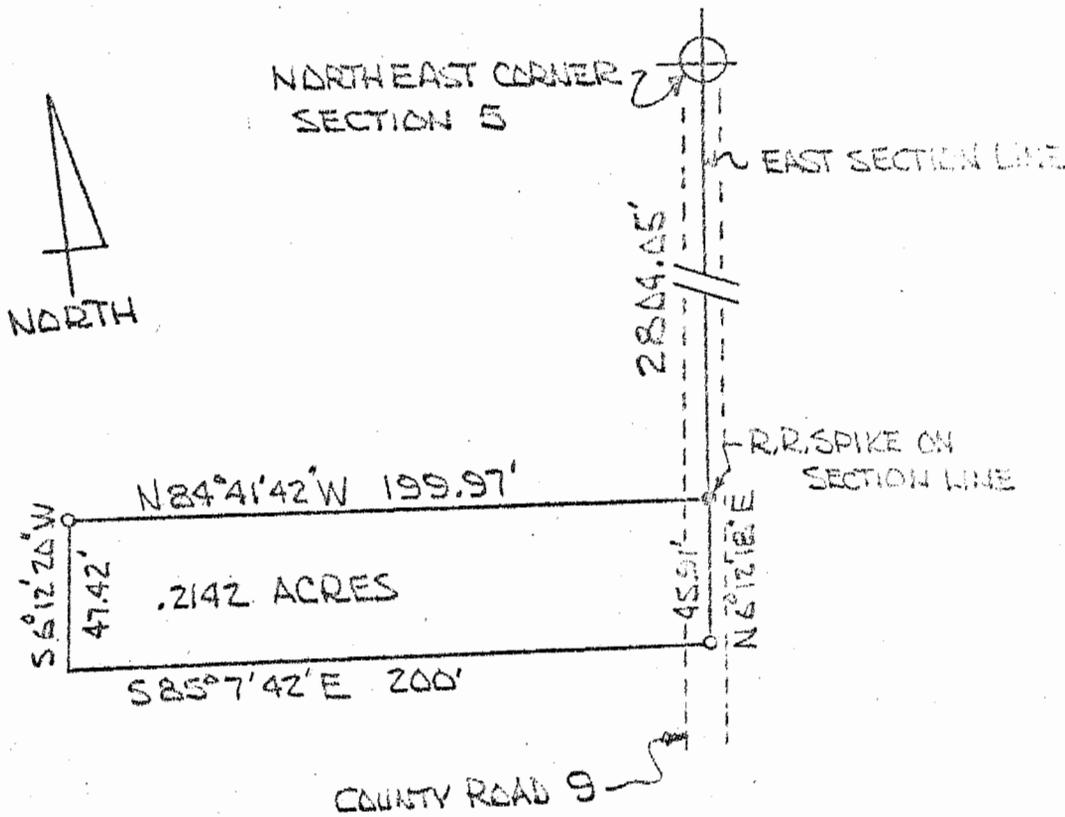

- IRON PIN
- RAILROAD SPIKE

Phil H. Ong
PHIL ONG RS 2142
JUNE 2 1976

WPT #5

37

CARL AND SHARON TOPE

The tract herein described is situated in Section 5, Waterloo Township, T11, R15 Athens County, commencing at the northeast corner of Section 5, thence south along the east section line (also the center line of County Road 9) 2804.05 feet to a railroad spike and the point of beginning of said tract, thence $N84^{\circ}41'42''W$ 199.97 feet to an iron pin, thence $S6^{\circ}12'20''W$ 47.42 feet to a point, thence $S85^{\circ}07'42''E$ 200 feet to an iron pin in County Road 9, thence $N6^{\circ}12'18''E$ along said County Road 9 45.91 feet to the point of beginning, containing .2142 acres.

Description by Phil Ong. Reg. Survr. 2142


Phil Ong

STATE OF OHIO

ATHENS COUNTY

WATERLOO TOWNSHIP SECTION 5 T11 R15

PROPERTY OF ROGER LEE SIX

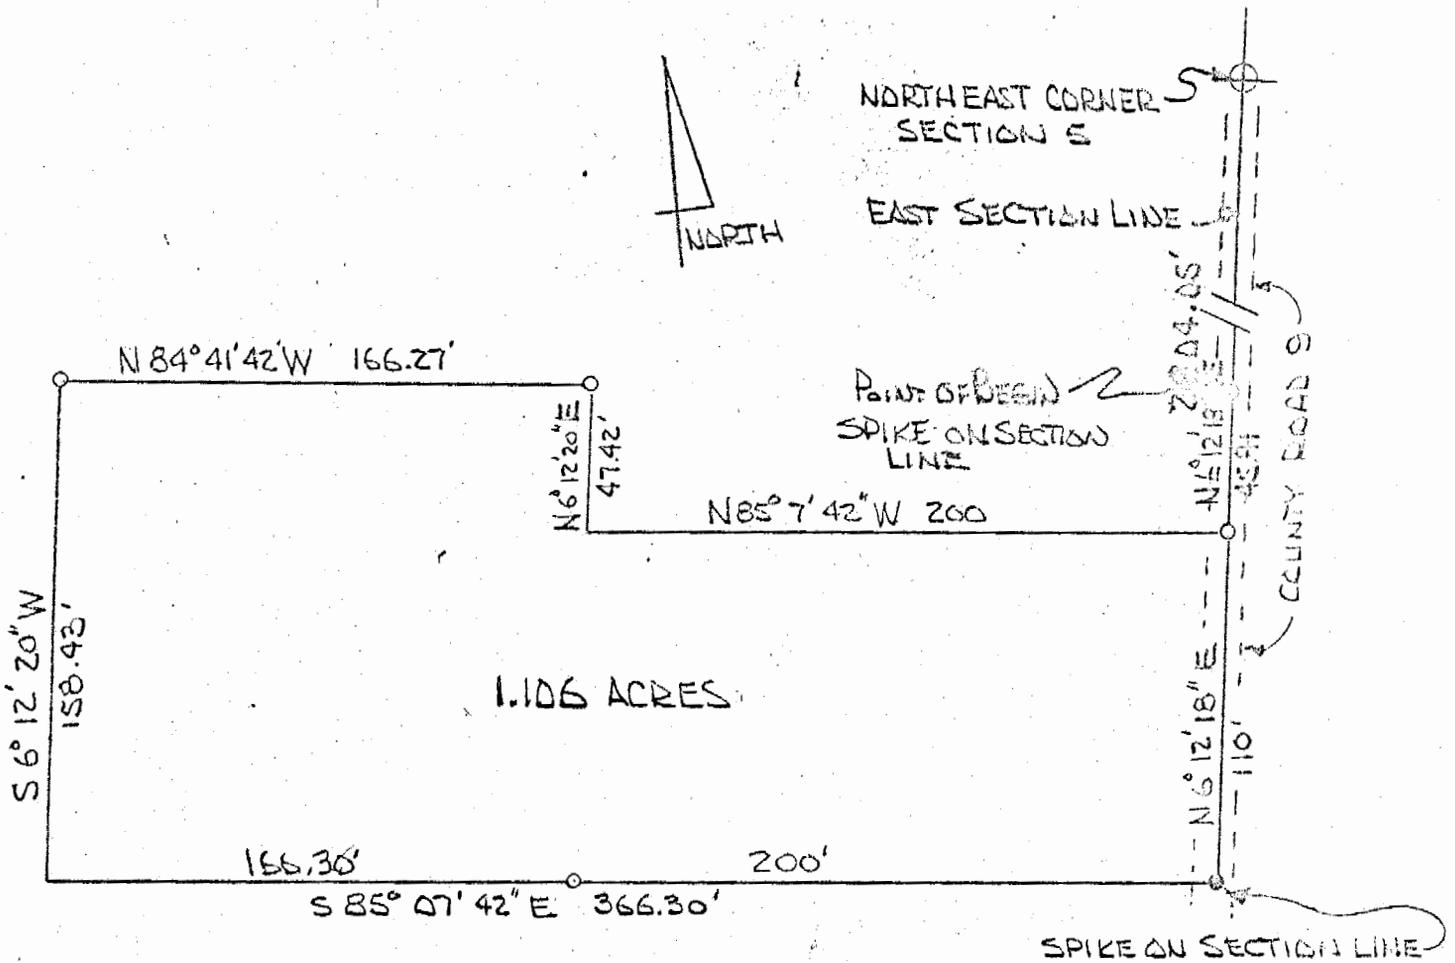

- IRON PIN
- RR SPIKE

Paul H. Day
 PAUL H. DAY RS 2142
 JUNE 2 1976

Sec 5 Waterloo Twp

ROGER LEE SIX

The tract herein described is situated in Section 5, Waterloo Township, T11 R15 Athens County, commencing at the north east corner of Section 5, thence south along the east section line (also the center line of County Road 9) 2804.05 feet to a railroad spike, thence $S6^{\circ}12'18''W$ 45.91 feet to an iron pin and the point of beginning of said tract, thence $N85^{\circ}7'42''W$ 200 feet to a point, thence $N6^{\circ}12'20''E$ 47.42 feet to an iron pin, thence $N84^{\circ}41'42''W$ 166.27 feet to an iron pin, thence $S6^{\circ}12'20''W$ 158.43 feet to a point, thence $S85^{\circ}7'42''E$ 366.30 feet (passing an iron pin at 166.30 feet) to a railroad spike ~~and~~ on the east section line and in said County Road 9, thence $N6^{\circ}12'18''E$ along said County Road 9 110 feet to the point of beginning, containing 1.106 acres.

Description by Phil Ong Reg. Survr. 2142

Phil Ong