


All other bearings are from angles and distances as measured in the field and tied by GPS to the ODOT CORS stations.

A survey of this property was completed in July 7, 2016 under the supervision of Michael A. Kinnison, Engineer and Surveyor, 218 E. 2nd Street, Wellston, Ohio. Registered Surveyor Number 8231.





Michael A. Kinnison, P.L.S. No. 8231

7/12/16

Date

***** End of Description *****

Kinnison Engineering and Surveying, LLC
 Michael A. Kinnison P.E., P.S.
 218 E. 2nd Street
 Wellston, Ohio 45692
 Telephone: 740-418-5364

This survey is not valid without the original signature and seal of the Land Surveyor.

LEGEND	
●	5/8" Rebar Set, 30" in Length, Cap Stamped, "Kinnison PS 8231"
△	Steel Spike Found
•	Point
⊙	Mag Nail Set
○	1/2" Iron Pin Found, No Cap or Tag
⊗	1-1/4" Outside Diameter Steel Pipe Found
□	Stone Found with "X"


Description Checked for
 Mathematical Accuracy
 Athens County
 ENGINEER'S OFFICE
 BY: D.S. SD
 DATE: 7/12/16

John David Knisley
 and Carrie Ann Knisley
 O.R. 0517/1172
 35.49 Acres

Section 1, York Twp.
 Section 6, Waterloo, Twp.

Stone found, taken to be the northeast corner of the Northwest Quarter of the Northwest Quarter of Section 6

Mag nail set in the centerline of Salem Road, taken to be the northeast corner of the Southwest Quarter of the Northwest Quarter of Section 6

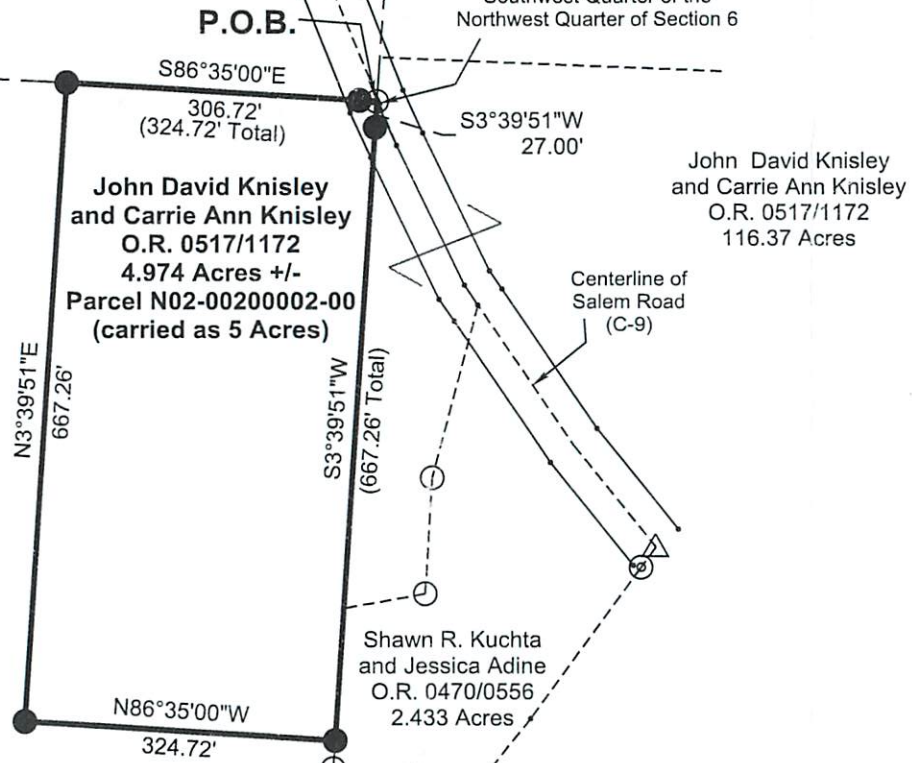

**John David Knisley
 and Carrie Ann Knisley**
 O.R. 0517/1172
 4.974 Acres +/-
 Parcel N02-00200002-00
 (carried as 5 Acres)

John David Knisley
 and Carrie Ann Knisley
 O.R. 0517/1172
 116.37 Acres

Shawn R. Kuchta
 and Jessica Adine
 O.R. 0470/0556
 2.433 Acres

Brian K. Dowler
 O.R. 0291/1334
 36.45 Acres



- Reference Documents:
1. Deeds and Prior as Listed
 2. Prior Surveys
 3. Tax Plats
 4. G.I.S.
 5. Existing Monuments
 6. County and City Maps
 7. Highway R/W Plans
 8. Railroad R/W Plans

I hereby certify this to be a plat of a survey made under my direction in July 7, 2016.

[Signature]
 Michael A. Kinnison, P.L.S. No. 8231

Date 7/12/16

- NOTES:
1. There may be additional easements, restrictions and/or matters not shown on this survey which may be found in the public records of this county.
 2. Underground utilities were not located unless otherwise noted.
 3. Interior improvements were not located unless otherwise noted.
 4. This survey is not valid without the original red signature and red seal of Michael A. Kinnison.
 5. This plat of survey is based upon a sample plat of survey as designated on the Professional Land Surveyors of Ohio, Inc. brochure and adopted by this county.

FILE NAME 3CARTSALM.TRV	DRAWING Drawing2	
SCALE 200 Ft/in	DATE 7-12-2016	DRAWN BY M.A.K.
JOB 16-058	REVISION 1/1	SHEET 1/1

This map was drawn with TRAVERSE PC Software

ATTENTION:
 THIS PLAT OF SURVEY REPRESENTS THE MINIMUM STANDARDS FOR BOUNDARY SURVEYS IN THE STATE OF OHIO AS ADOPTED BY 5-1-80 OF THE ADMINISTRATIVE CODE CHAPTER 4733-37. LOCAL GOVERNING REQUIREMENTS IF MORE STRINGENT, SHALL BE ADHERED TO.

Not to be used as a separate building site or transferred as an independent parcel without planning commission approval.

By: [Signature] Director,
 Date: 8/16/16 Must be held continuous & contiguous with parcel

Survey For:	Rodney Cartwright
	4.974 Acres +/-
Situated in the Southwest Quarter of the Northwest Quarter of Section 6 of the Ohio Company Purchase, T-11N., R-15W., Waterloo Twp., Athens County, Ohio	
July 7, 2016	