


Thomas Lark Stewart
342/707
102 ac.

Stotsky
15.0 Ac.
371/581

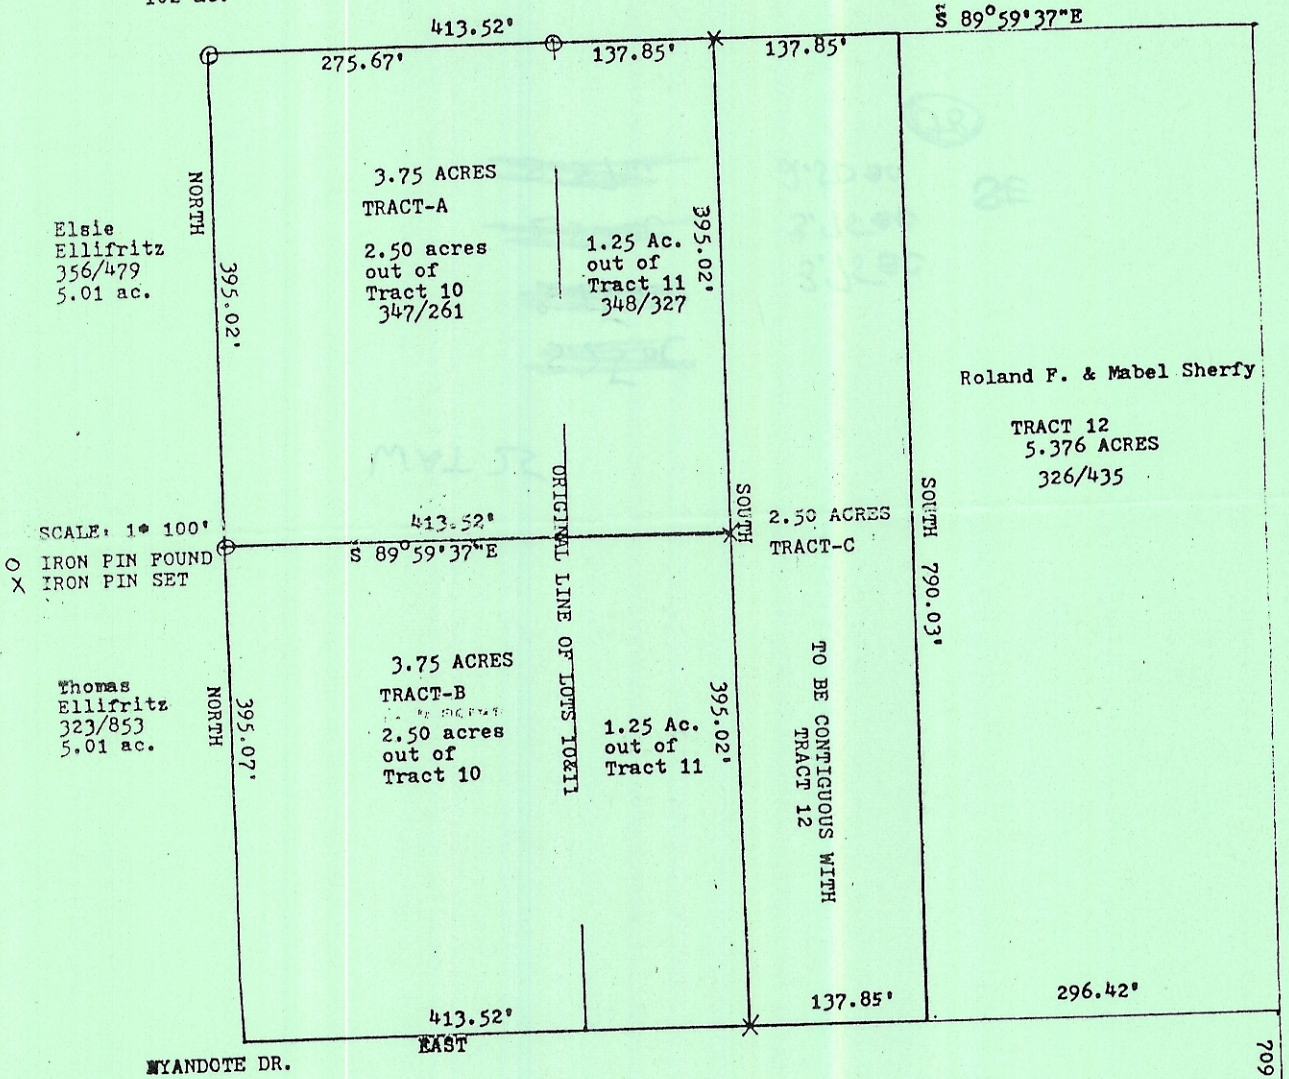

SURVEY OF 3 TRACTS OUT OF TRACTS 10&11 BARNES SUBDIVISION
AS RECORDED IN PALT BOOK 10, PAGE 12, COUNTY RECORDER'S OFFICE
AND SITUATED IN SECTION 25, T.11, R.15, WATERLOO TOWNSHIP,
ATHENS COUNTY, OHIO



Prepared by: *John M Branner*
JOHN M. BRANNER
REGISTERED LAND SURVEYOR #6805
RT#3, ATHENS, O. 592-5778
JUNE 1984

SE COR
OF SEC 25

Description checked for
Mathematical Accuracy
ATHENS COUNTY
ENGINEER'S OFFICE
BY: *Paul W. Stott*
DATE: 06-28-84