


Sec. 31

Sec 31
Waterloo



PLAT
 of Two Tracts in Section
 31, T. 11, R. 15, Waterloo TWP.
 Athens County Ohio
 The Athens Fish & Game Club Inc.
 "IZAACK WALTON LEAGUE"
 to Maynard Thomas
 surveyed 11-16-47 for Wilson Smith
 by Joe L. Galvin
 Reg. Sur. 1684.

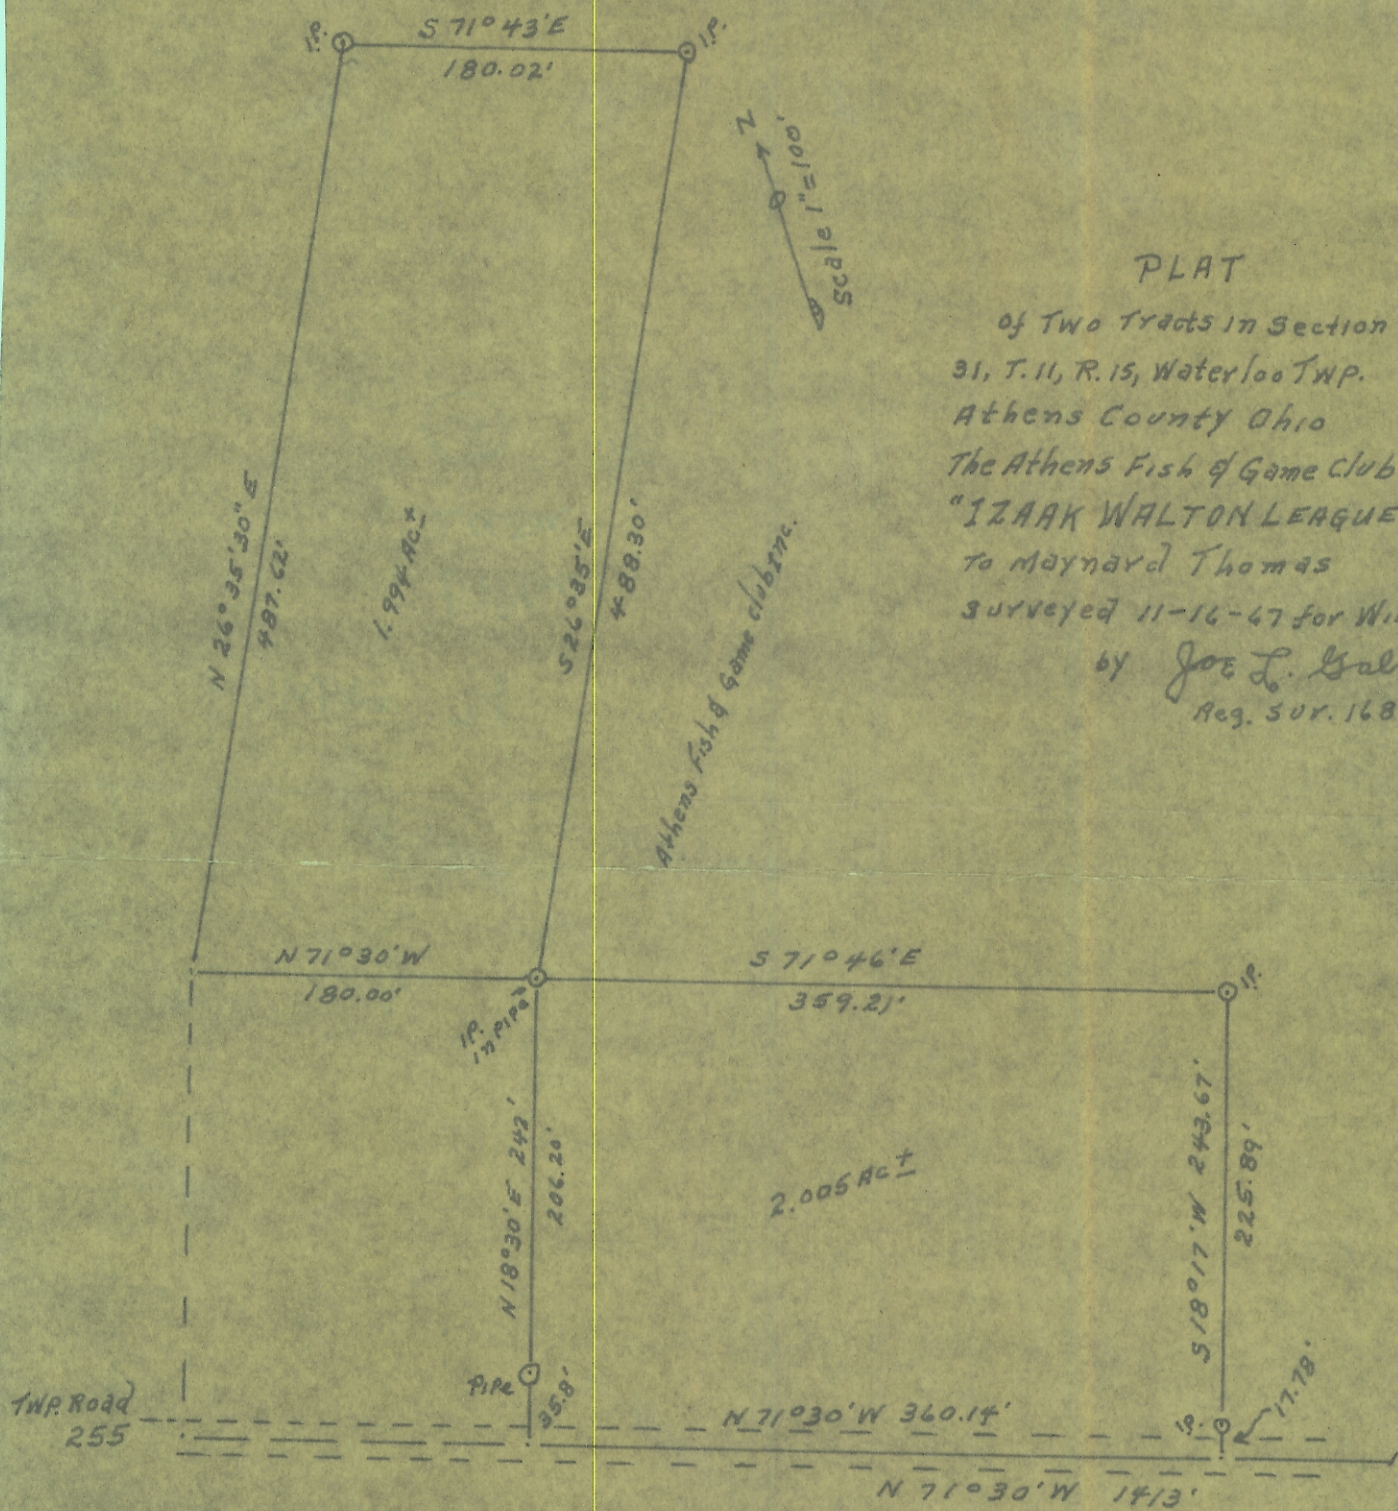

Waterloo Twp.
 Athens Co. 31 | 25
 Vinton Co. 36 | 30
 Knox Co. 14 | 13