

Highland Surveying
80 Fayette Street
Nelsonville Ohio 45764

Description of a 0.093 Acre Tract

Situated in the City of Nelsonville, Township of York,
County of Athens, and State of Ohio and being a portion
of Lot No. 248 of the L.D. Poston's Addition to the City of
Nelsonville as recorded in the Plat of said Addition in the
Recorders office of Athens County and being more
particularly described as follows:

Beginning at an iron pin set at the southwest
corner of Lot 248
thence North 89° 57' 00" East 65.53 feet along the North
line of a 16 foot alley to an iron pin set
thence North 62.00 feet to an iron pin set on the
East line of Lot 248
thence South 89° 57' 00" West 65.53 feet to an
iron pin set on the West line of lot 248
thence South along said West line 62.00 feet to
the place of beginning and containing 4062.85 square
feet (0.093 acres)

Subject to all Easements and Rights of Way of Record



Kenneth E. Highland
Kenneth E. Highland S-7581


Description checked for
Mathematical Accuracy
ATHENS COUNTY
ENGINEER'S OFFICE
BY: *Hyane*
DATE: 11/1/94

YORK # 24

61

HIGHLAND SURVEYING

REGISTERED PROFESSIONAL LAND SURVEYOR

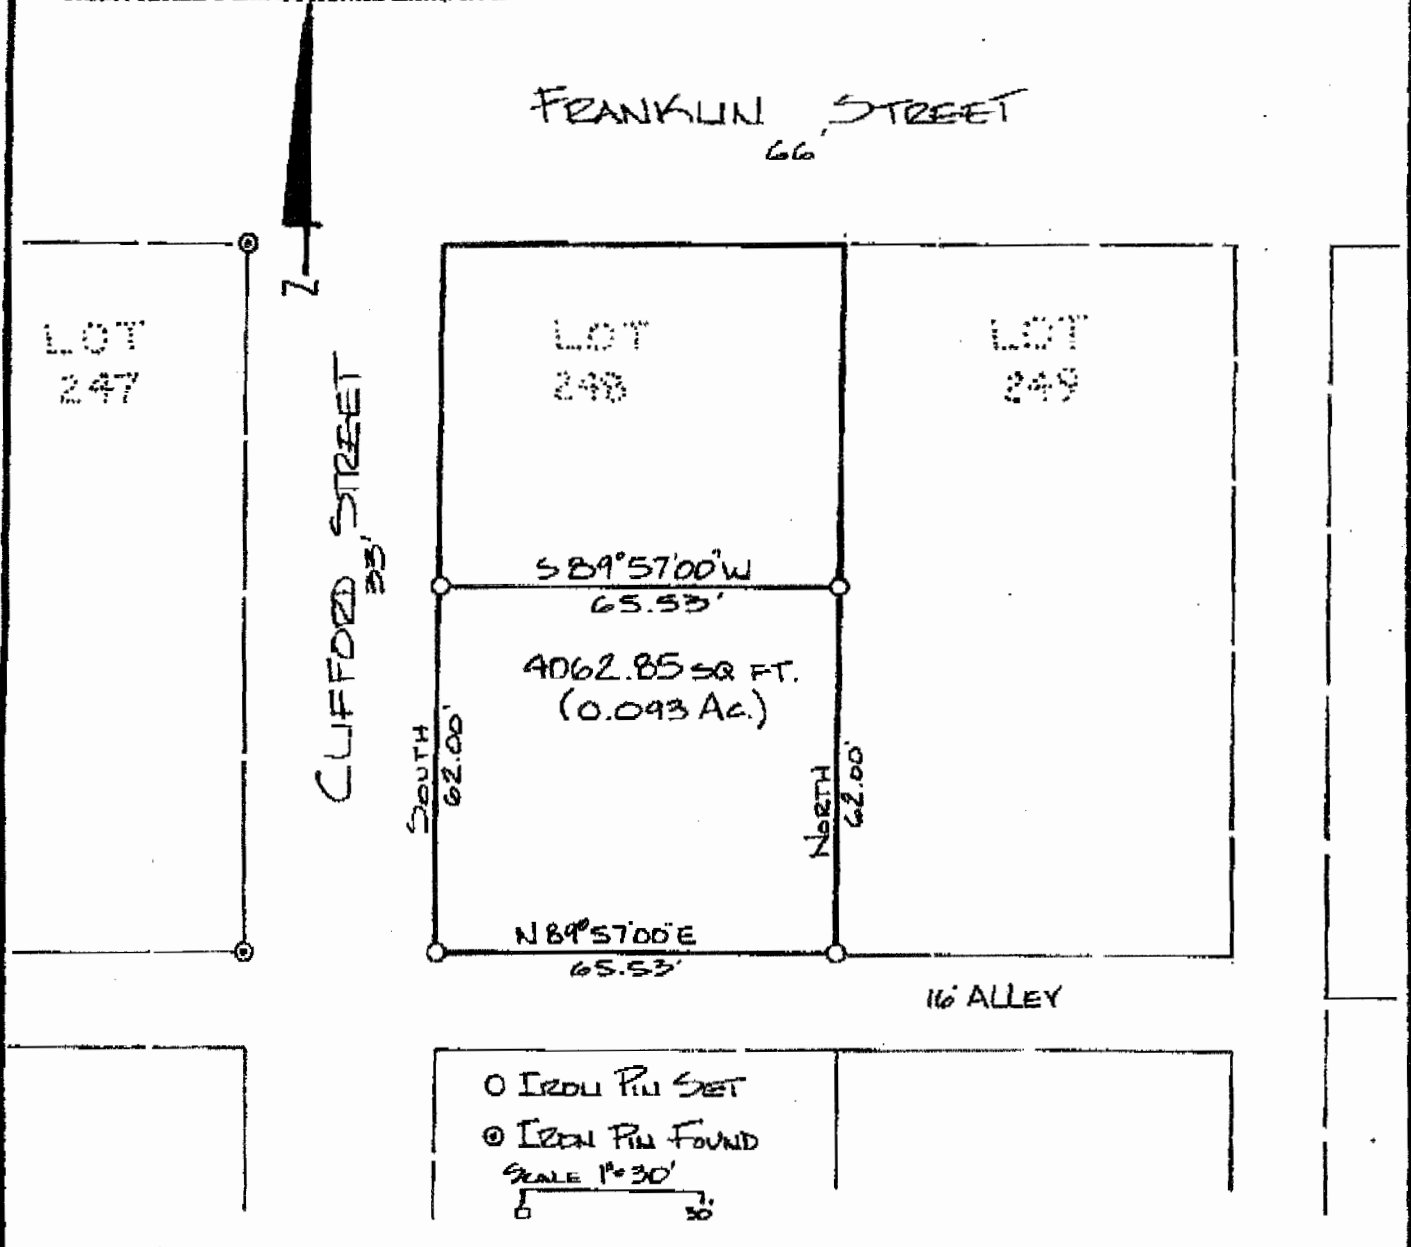

PLAT of SURVEY OF 4062.85 SQ FT TRACT
 SURVEYED for DAVE BISHOP
 SUBDIVISION L.D. POSTONS ADDITION
 TOWNSHIP YORK SECTION 24 TOWN 12 RANGE 15
 CORPORATION NELSONVILLE COUNTY ATHENS STATE OHIO
 SCALE 1" = 30' DATE OCT 17 1994

KENNETH E. HIGHLAND
 90 FAYETTE STREET
 NELSONVILLE, OHIO 45764
 614-758-1204

Kenneth E. Highland
 Kenneth E. Highland S-7581



63