


# SOUTHEASTERN LAND SURVEYS

LEONARD F. SWOYER  
REGISTERED LAND SURVEYOR

Box 208A  
Route Five  
Athens, Ohio 45701  
614/593-8701

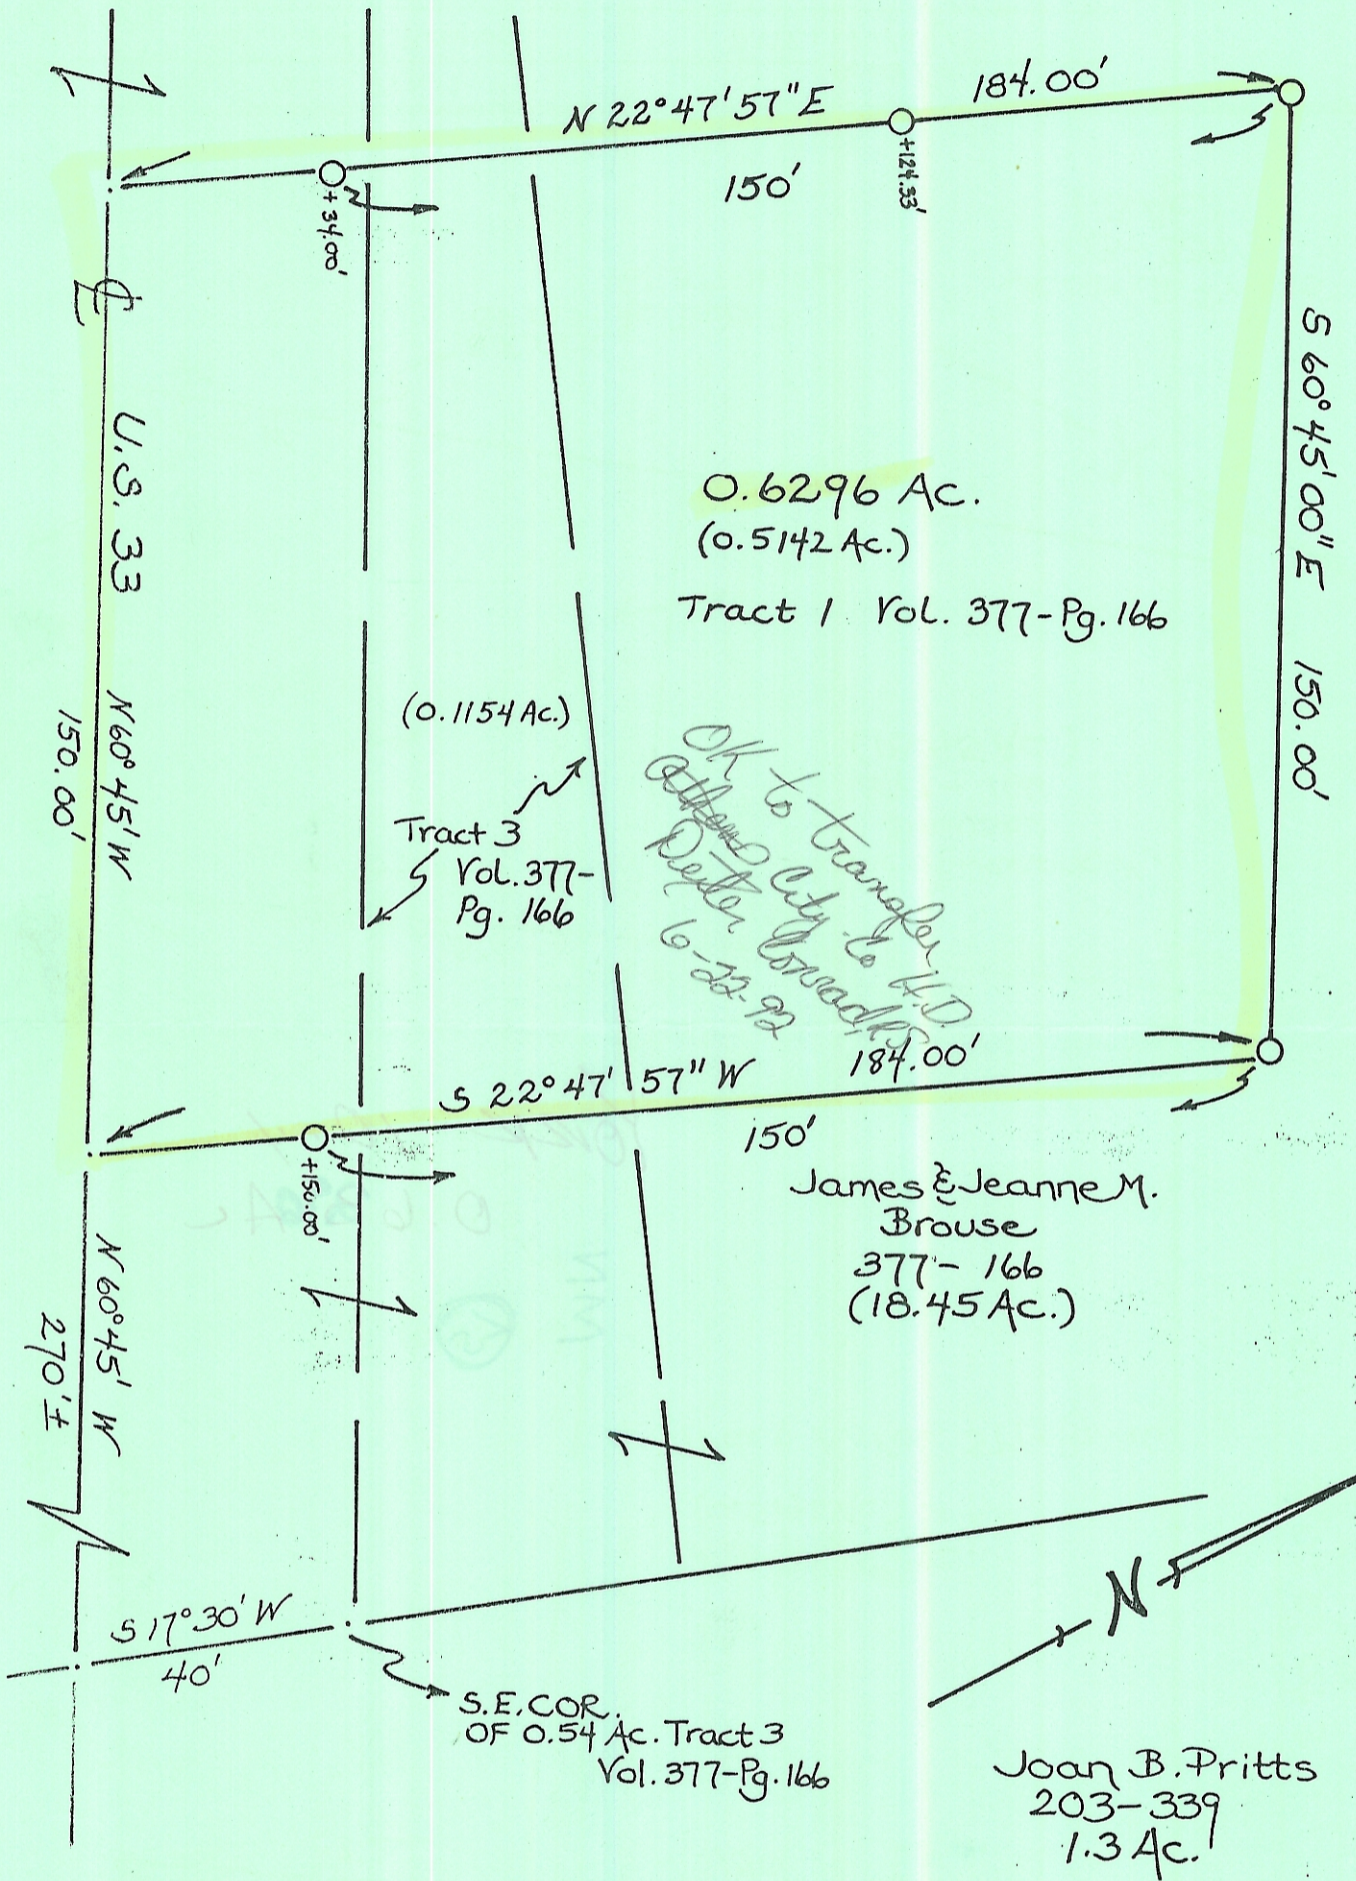

Plat of a 0.6296 Acre Tract Scale 1" = 30'

Surveyed for Mr. James Brouse DATE: 10/16/86

Subdivision N.W. 1/4 (SECTION 10)

Township York Section 10 Town 12 Range 15

Corporation --- County Athens State Ohio

*Leonard F. Swoyer II*  
Leonard F. Swoyer II Reg. Prof. Land Surveyor No. 6765