

To Auditor's Office


NELOCITY
YORK 18
O. 2605 AC



SOUTHEASTERN LAND SURVEYS

LEONARD F. SWOYER
REGISTERED LAND SURVEYOR

Box 208A
Route Five
Athens, Ohio 45701
614/593-8701

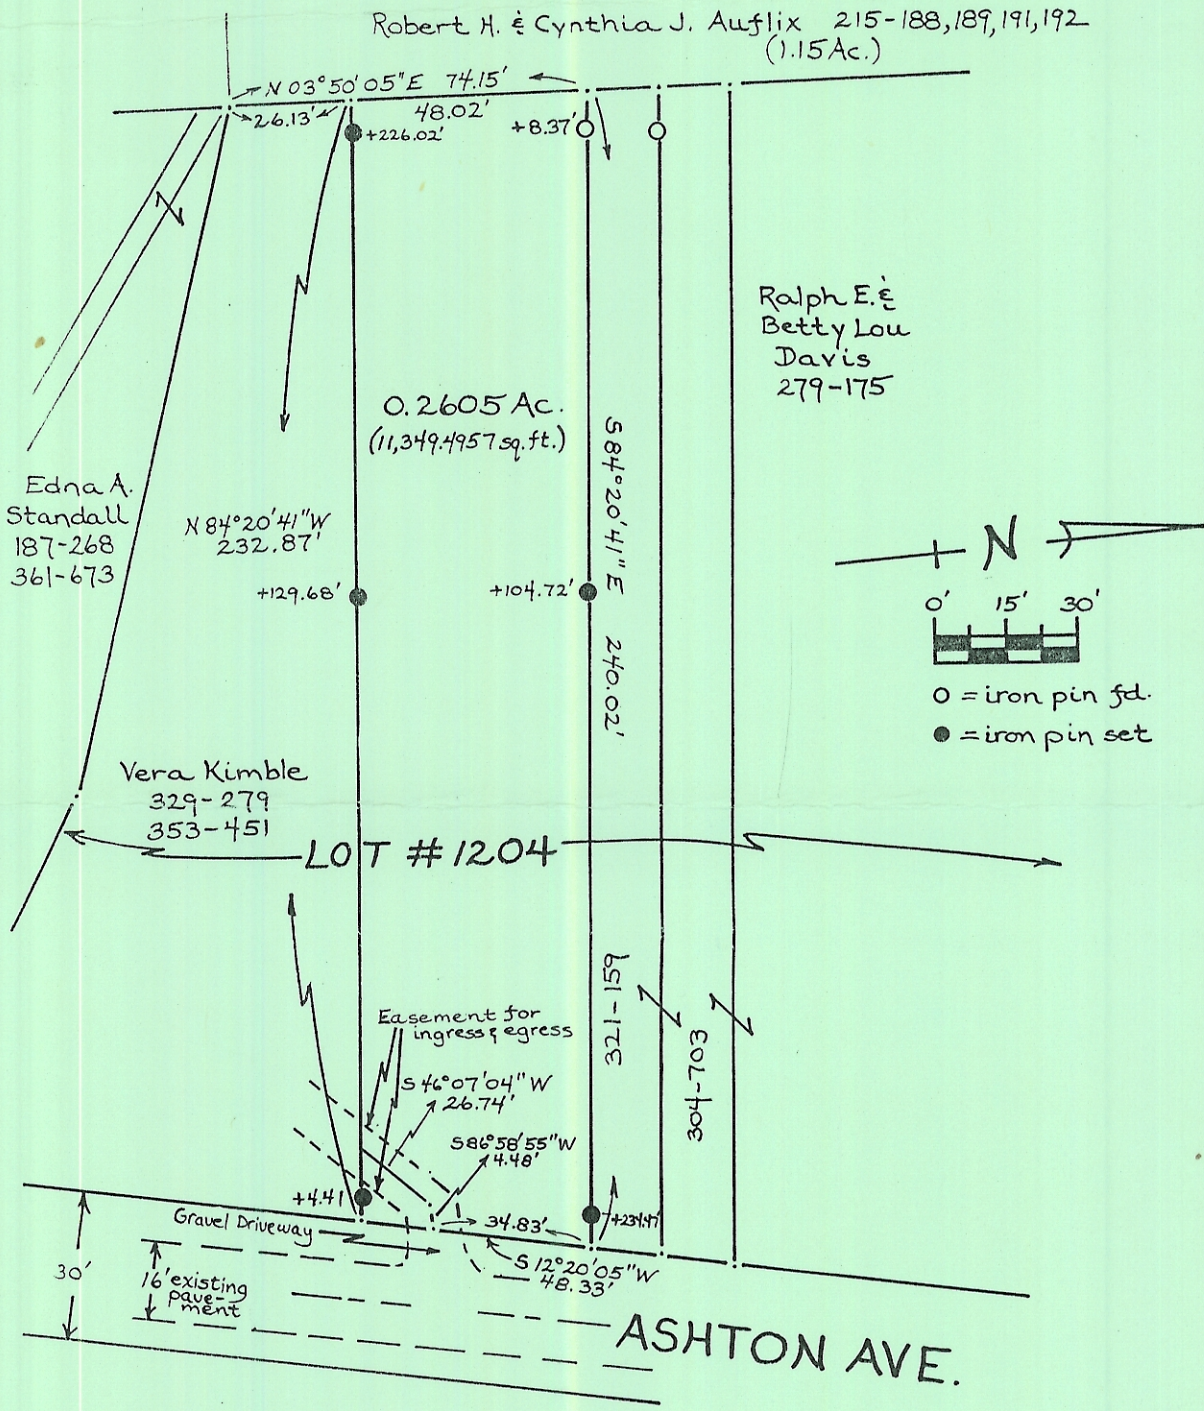

Plat of a 0.2605 Ac. Tract Scale 1" = ---'

Surveyed for Mr. Don W. Yost Date Surveyed January 14, 1986

Street Address 201 Ashton Ave., Nelsonville

Subdivision a part of Lot 1204 of Poston's Addn. to the City of Nelsonville

Township York Section 18 Town 12 Range 5

Corporation Nelsonville County Athens State OH

Leonard F. Swoyer II

Leonard F. Swoyer II Reg. Prof. Land Surveyor No. 6765