


Sec 1
York

310-347

Sec 1

SEC 7
SEC 1

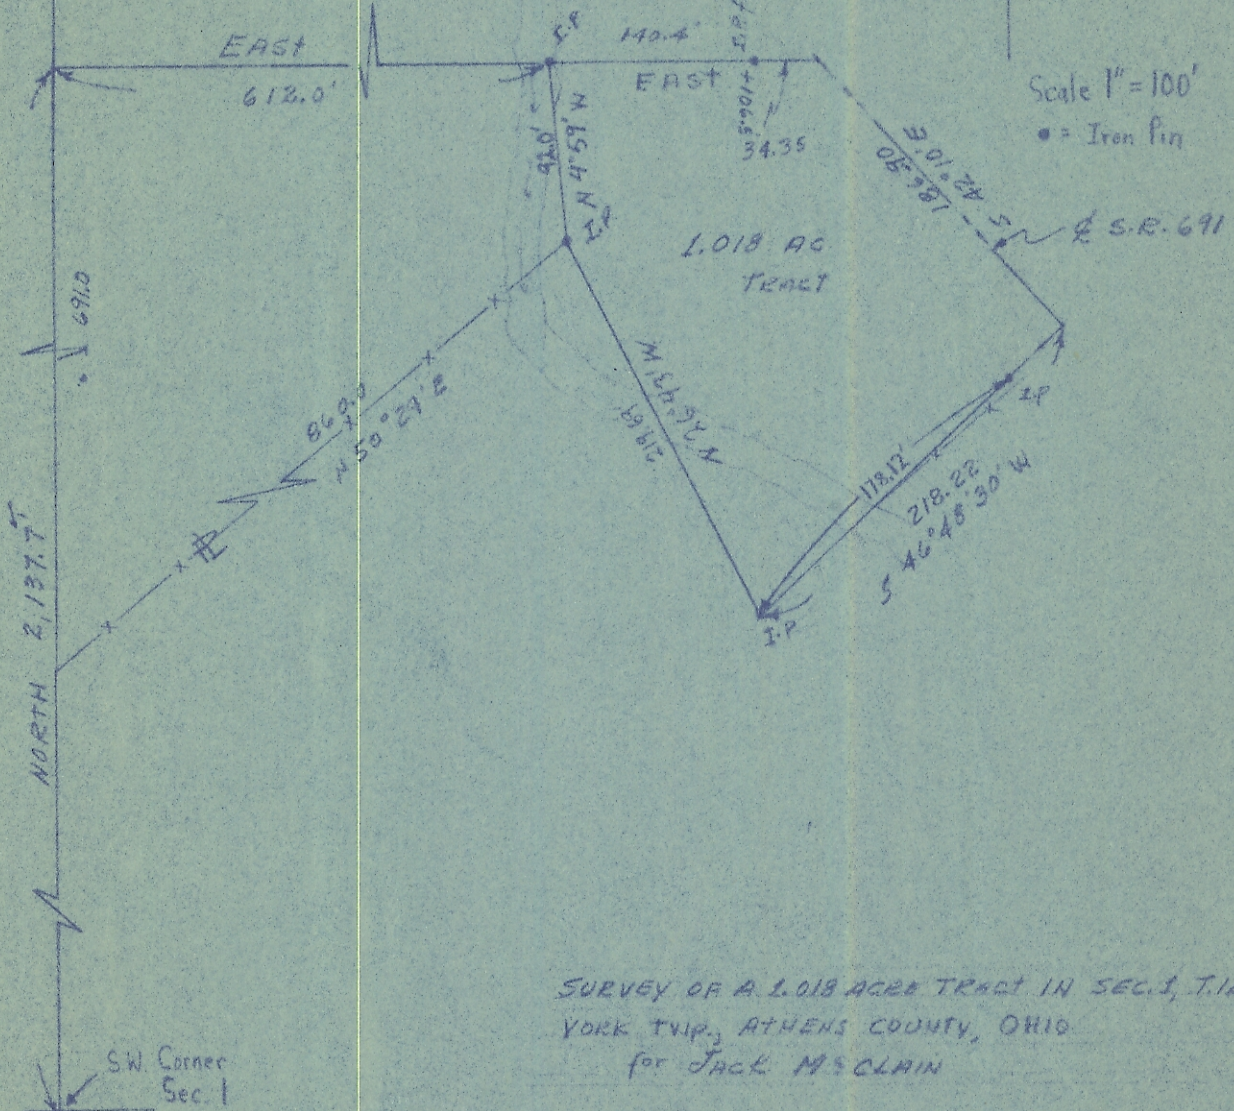

Scale 1" = 100'
● = Iron Pin

SURVEY OF A 1.018 ACB TRACT IN SEC. 1, T. 12, R. 15,
YORK TWP., ATHENS COUNTY, OHIO
for JACK MASCLAIN

SURVEYED JUNE 24, 1972

by HAROLD D. WHALEY
Harold D. Whaley
REG. SURV. NO. 4986

61712
ATHENS COUNTY
REGISTERED
SURVEYORS