DESCRIPTION - LOT 1644 & PART OF LOT 1645

LOVE - PRIMROGE ADDITION - MELGONVILLE, OHIO

Situated in the City of Nelsonville, County of Athens, State of Ohio more particularly described as follows:

Lot No. 1644 and the south 20 feet of Lot No. 1645 of the Leve - Primrose Addition to the City of Nelsonville as recorded in plat Book 5, Page 66 of the Athens County Plat Records.

This description was prepared from an actual survey of the premises made by me October 16, 1982.

Registered Surveyor #85216

Description checked for

Mathematical Accuracy

ATHENS COUNTY

ENGINEER'S OFFICE


ou Voteste

DATE: 10-18-90-0

City YRK# al

delsonville City

ø

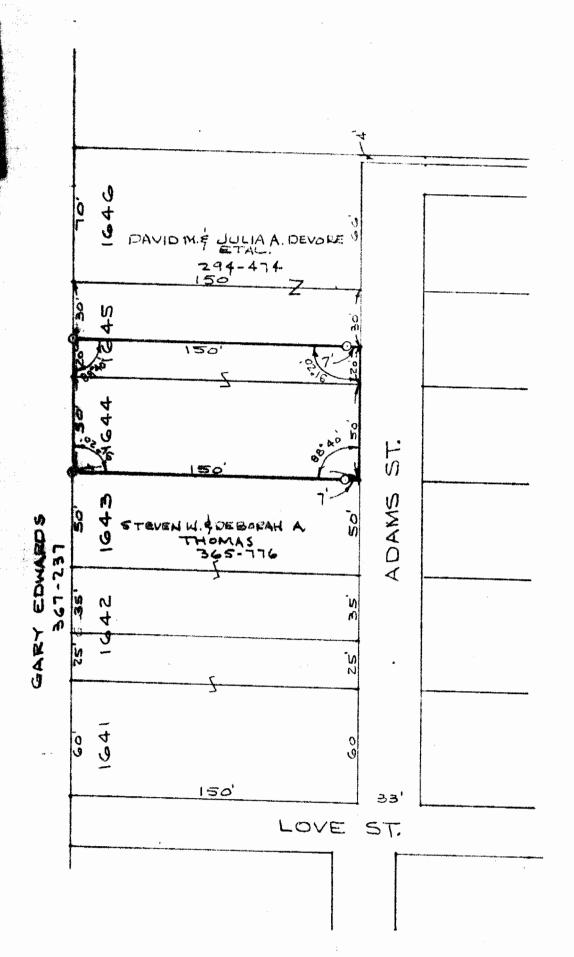

PLAT OF SURVEY
LOT 1644 PART OF LOT 1645
LOVE-PRIMROSE ADDITION
CITY OF HELBONVILLE, OHIO
PLAT BOOK 5, PAGE 66

. SCALE: 1"=50

SURVEYED OCT. 16,1982

REGISTERED SURVEYOR Nº 5-5216

WILLIAM M. WATKINS
S 5216
S STEEL ST