

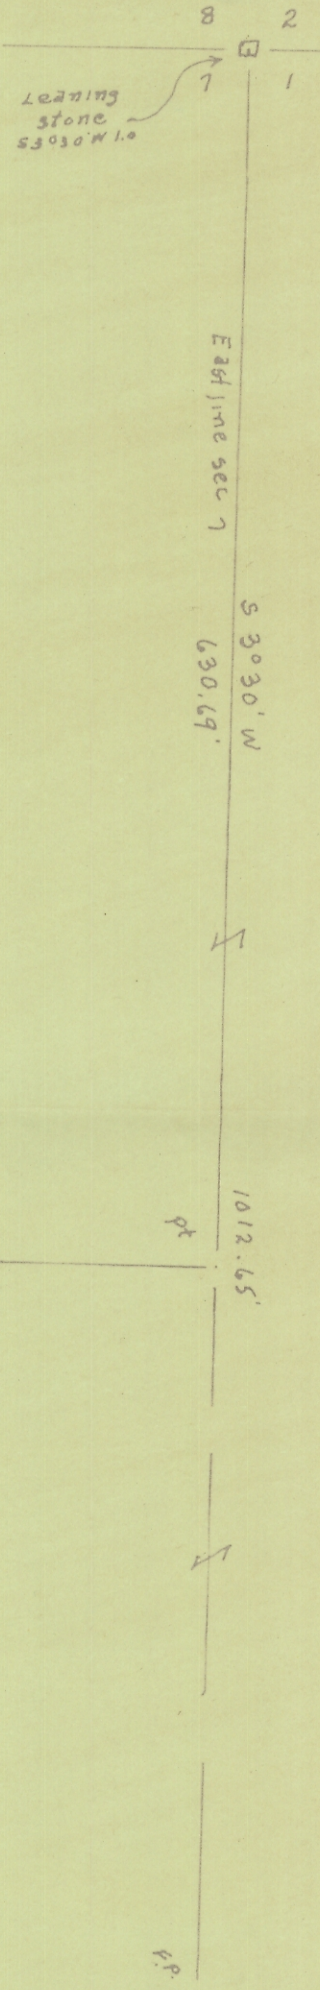


N Line Sec 7 calc N 87° 10' W

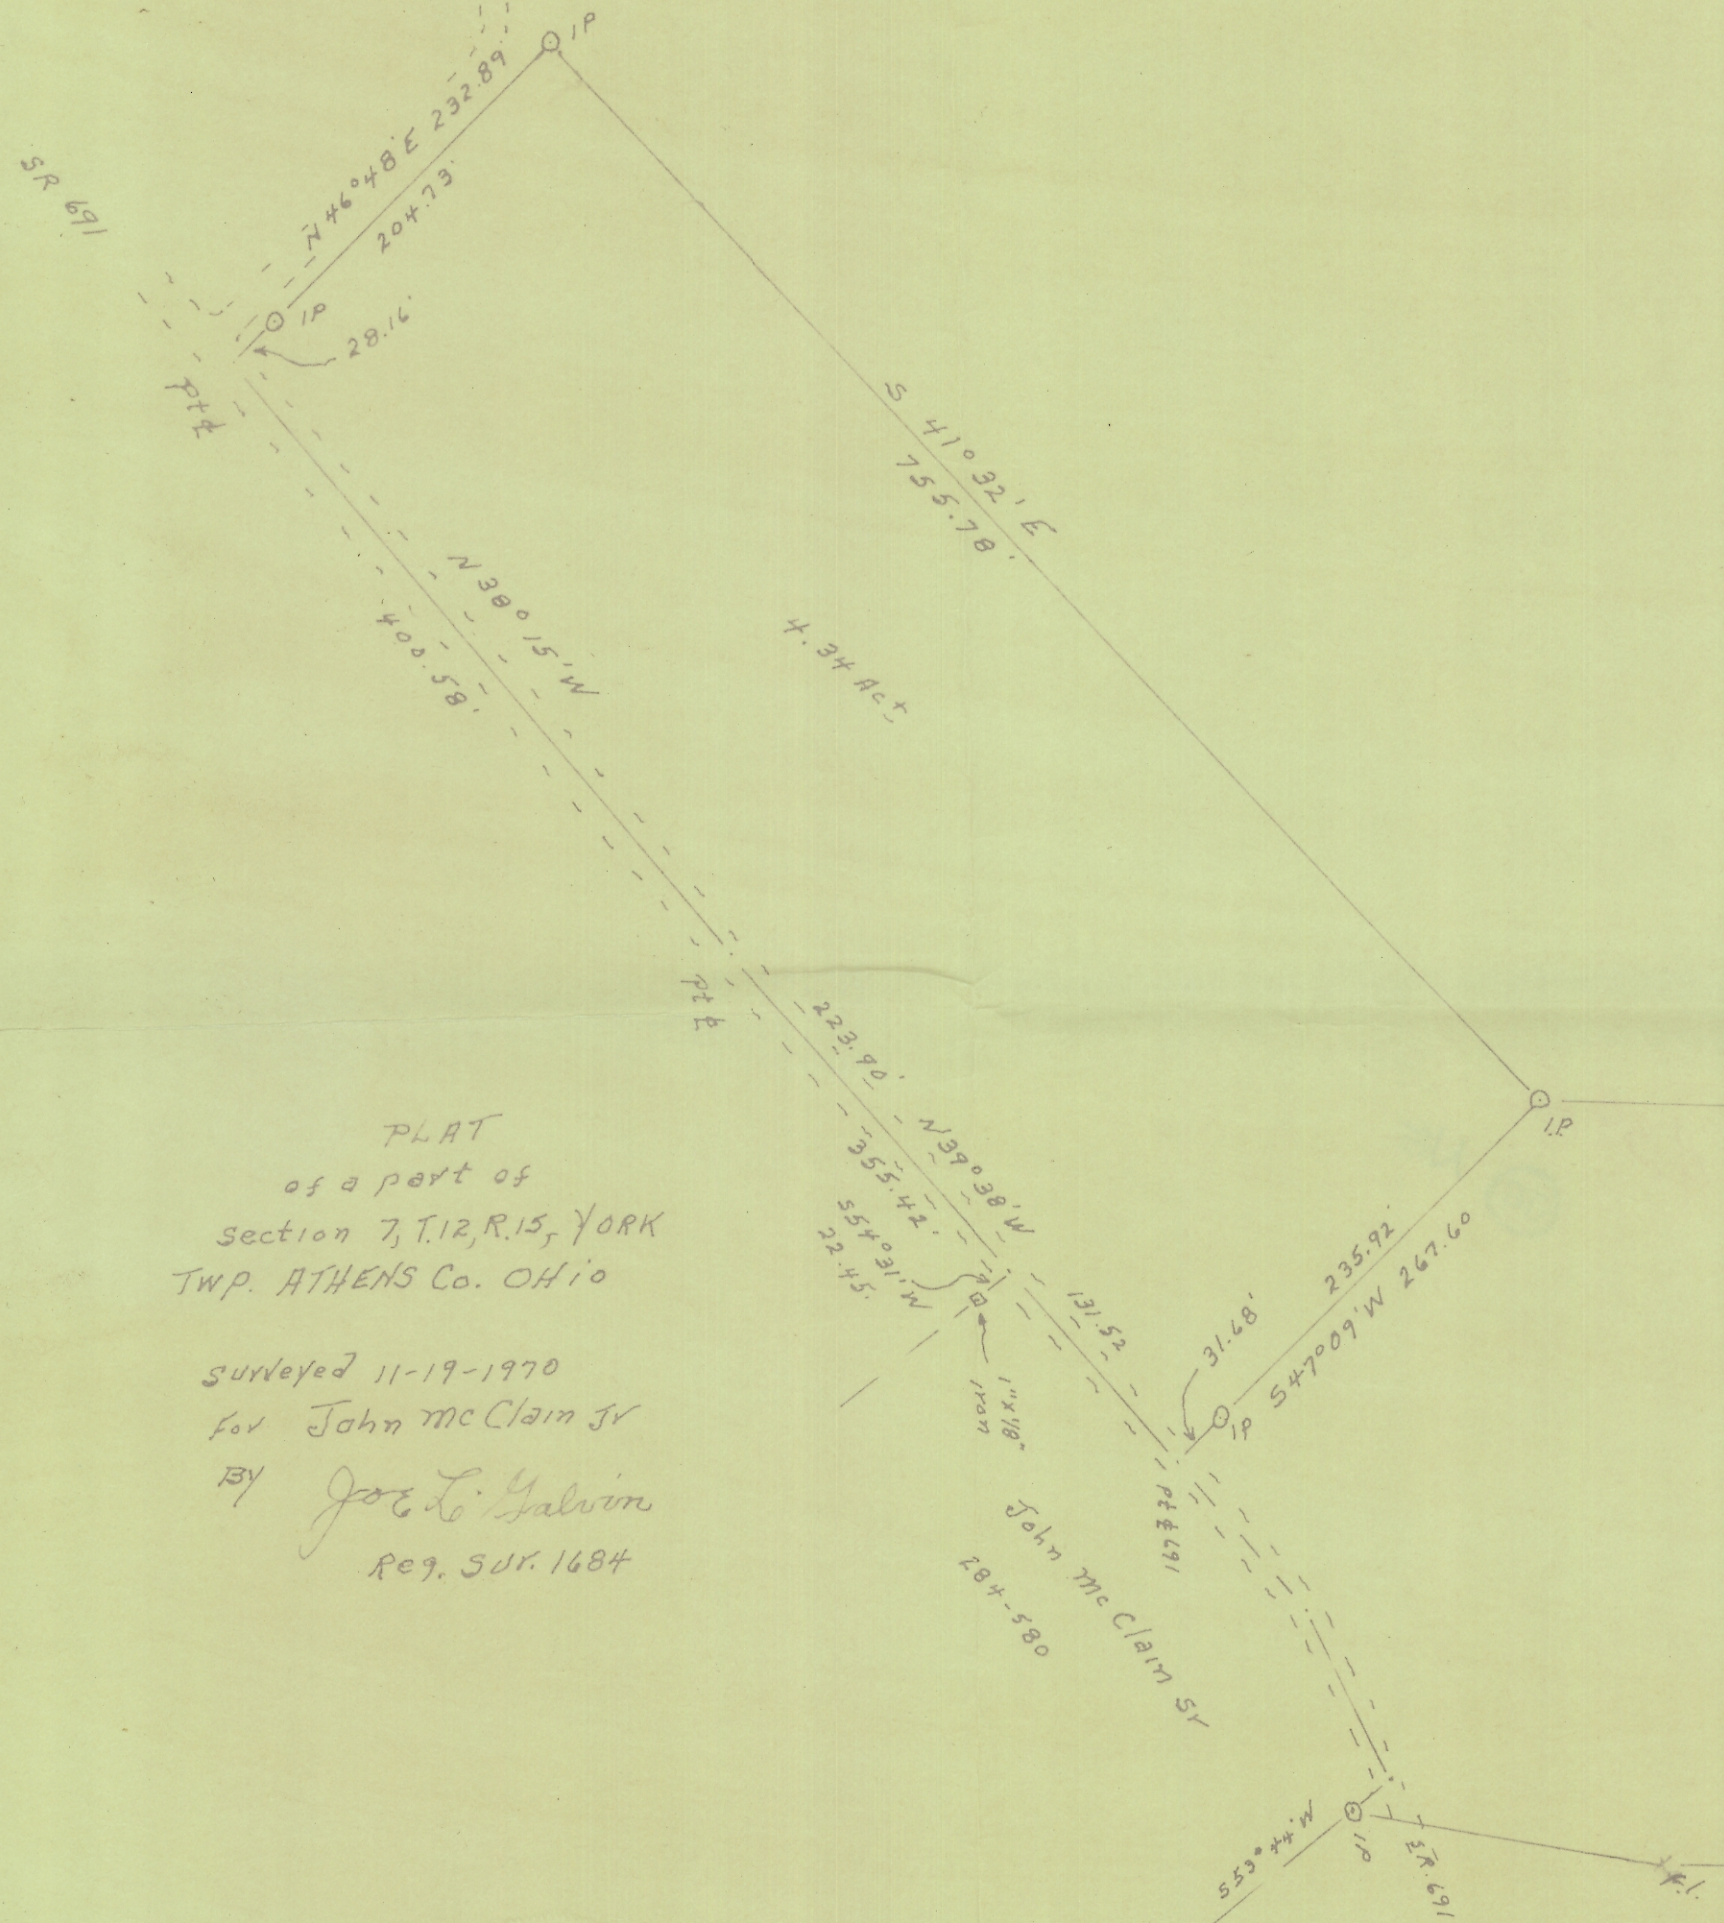

Scale 1" = 100'

PLAT
 of a part of
 Section 7, T.12, R.15, YORK
 TWP. ATHENS Co. OHIO
 surveyed 11-19-1970
 for John Mc Claim Jr
 by Joe L. Galvin
 Reg. SUR. 1684

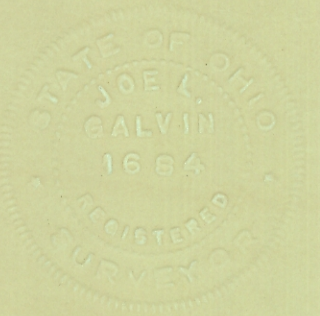

calc N 87° 10' 34" W