

James & Elizabeth Wood
210-213

Tract 5
1,306,798 sq. ft.
30.0000 acres

Tract 4
1,462,497 sq. ft.
33.5743 acres

Tract 3
435,603 sq. ft.
10.0001 acres

Tract 2
435,601 sq. ft.
10.0001 acres

Tract 1
435,602 sq. ft.
10.0001 acres

Plot of Survey of 5 Tracts
Sited in Farm Lot 3, Section 20,
Town 8, Range 14, Alexander Township,
Athens County, Ohio
Surveyed July 1989 for
Lois Flickinger




by
Gregory K. Wright
Gregory K. Wright
Registered Surveyor S-6535

Partially
60-503



• = Iron Pin Set

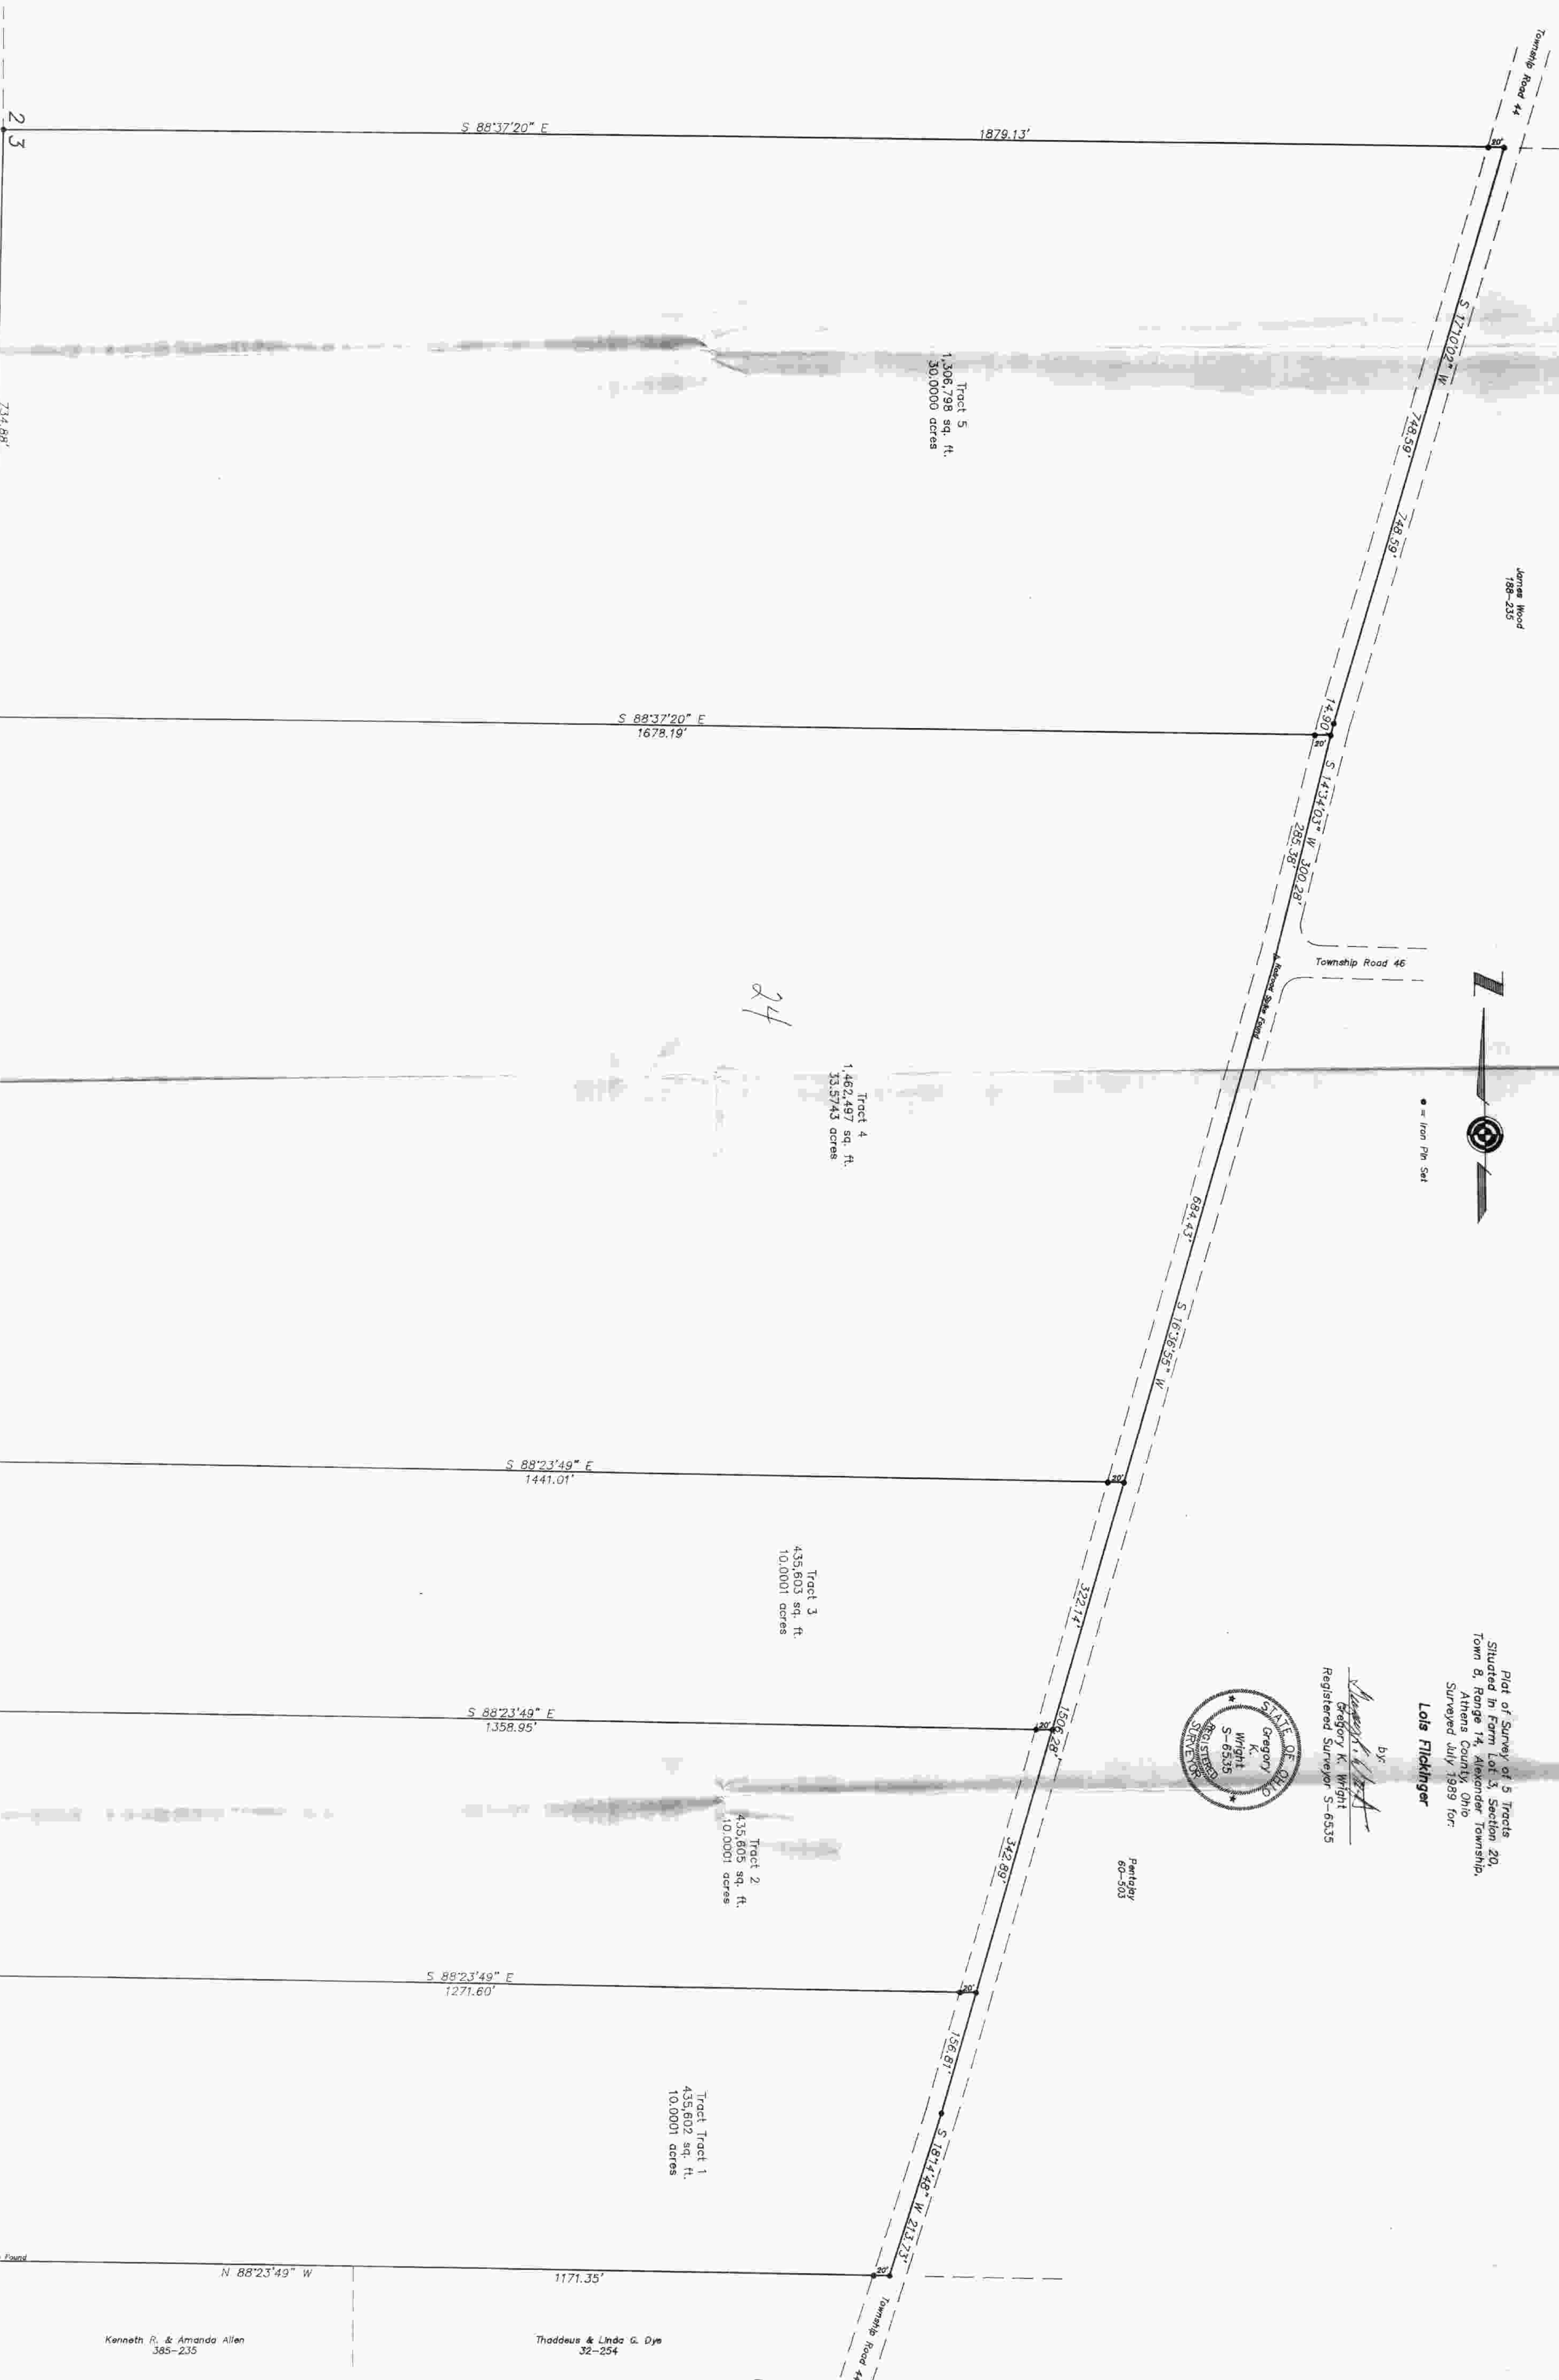

Kenneth R. & Amanda Allen
345-235

Thaddeus & Linda G. Dye
32-254

Revised 7-22-89

25

24

26

27