


N 89° 16' 16" E  
CONCRETE MONUMENT  
N.E. CORNER  
S.W. 1/4, SEC. 19

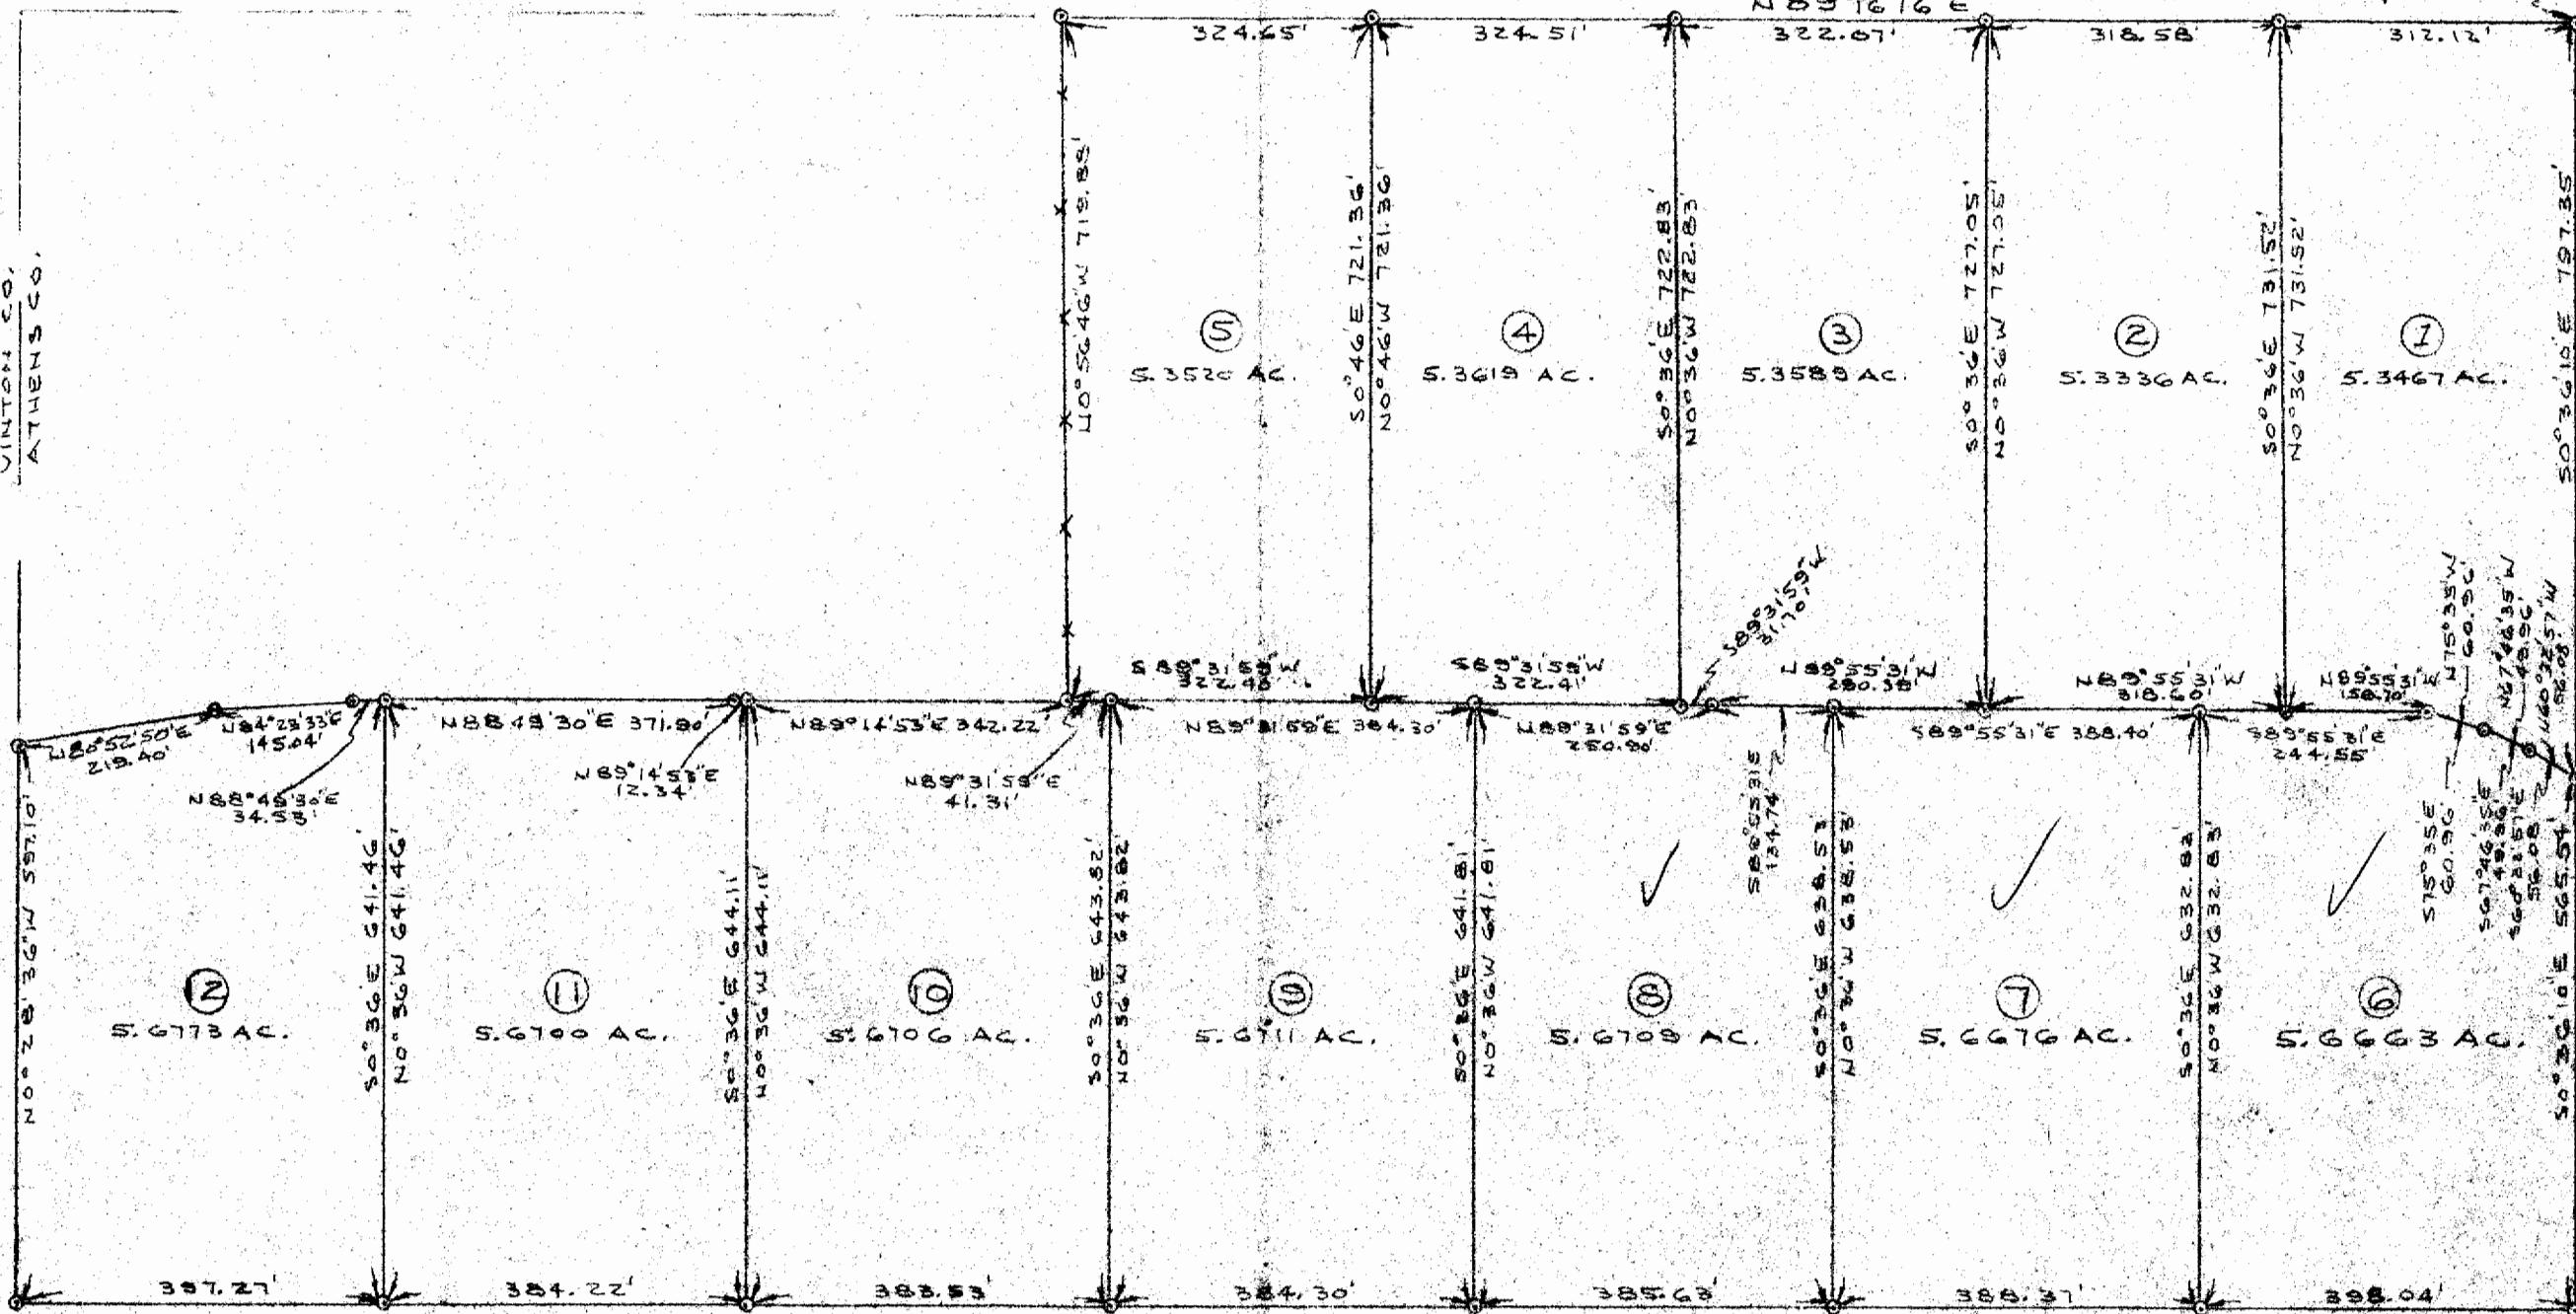

Description checked for  
Mathematical Accuracy

ATHENS COUNTY

ENGINEER'S OFFICE

By *Bruce D. McPerson*

DATE: July 16, 1975

PLAT OF DIVISION OF LAND  
LOCATED IN THE N.E. 1/4 OF THE S.W. 1/4 OF SEC. 19, TOWNSHIP, RANGE 15  
LEE TWP., ATHENS CO., OHIO

PREPARED BY

EVANS, MECHWART, HAMBLETON & TILTON, INC.  
CONSULTING ENGINEERS & SURVEYORS  
CAHANNA, OHIO

ATHENS, OHIO

SCALE: 1" = 200'

William M. Watson  
REGISTERED SURVEYOR #212

8