


ATHENS COUNTY AUDITOR TAX PLAT
Scale 1" = 100'

GLOUSTER

D-3

NW.Q of SW. Q SEC. 9
Trimble Twp.
TII-R14

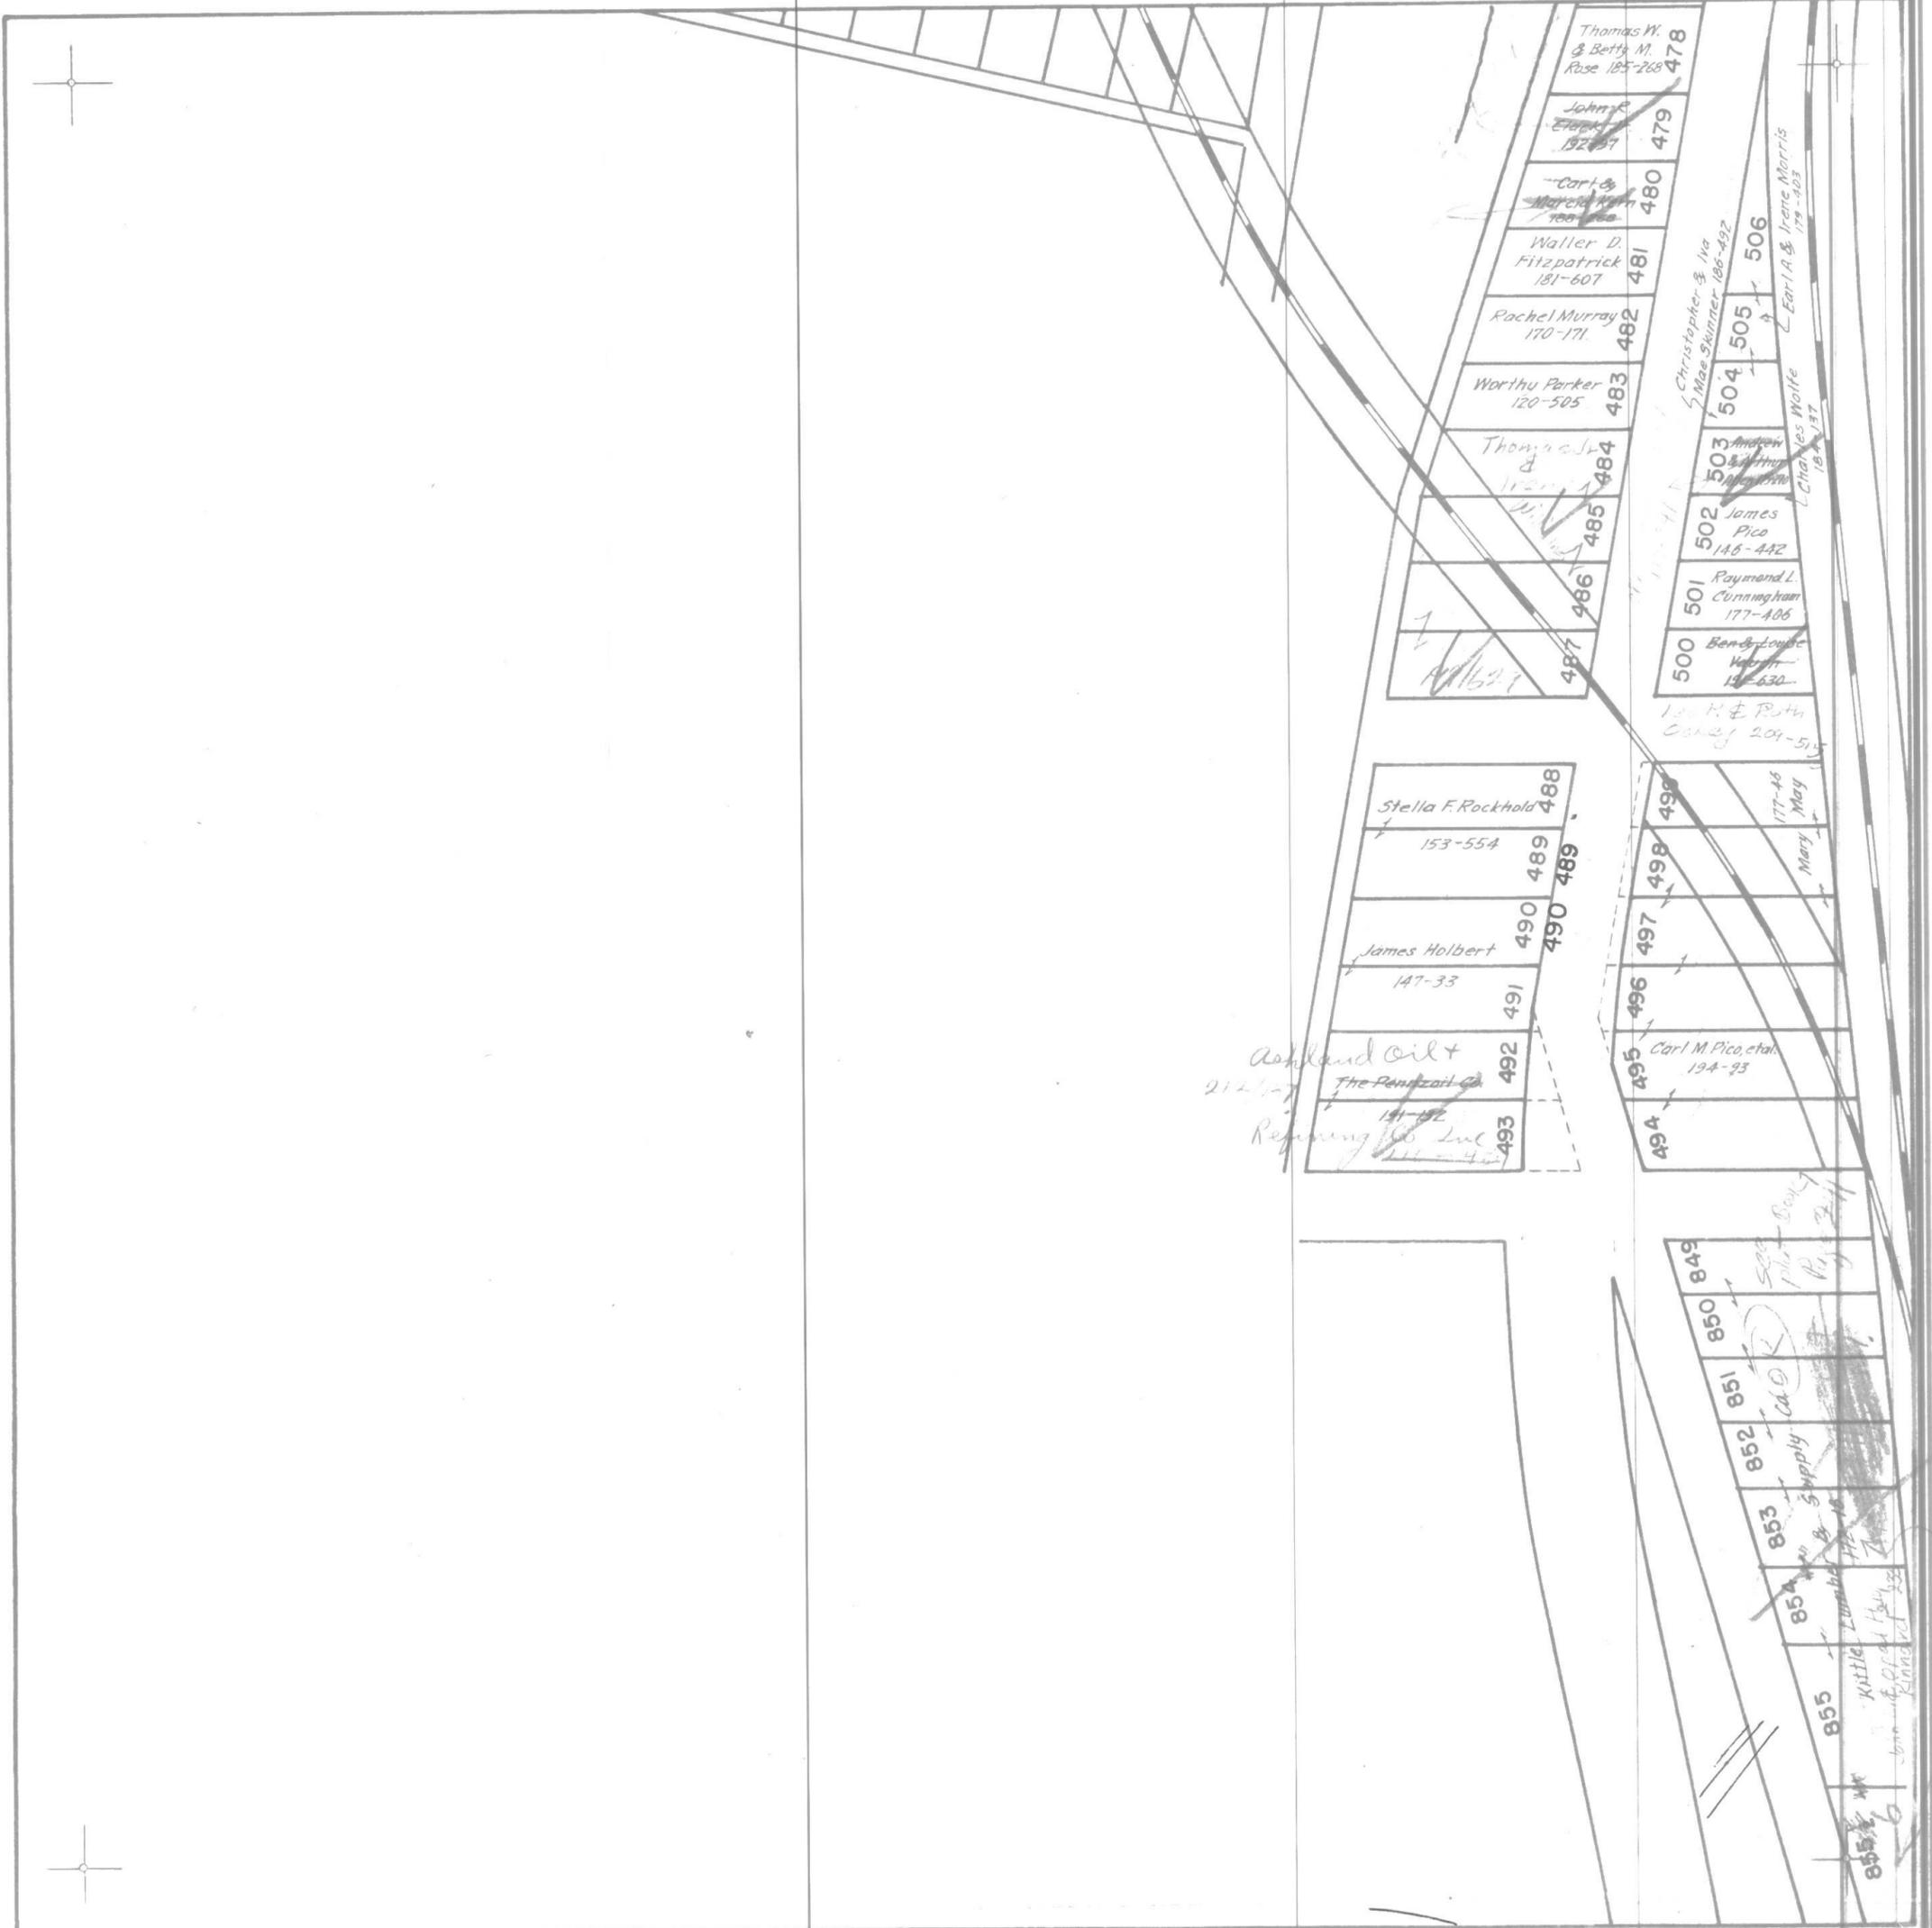

Thomas W. & Betty M. Rose 125-268 478

~~John E. Etnick 152-87 479~~

~~Carl & Myrtle 100-100 480~~

Waller D. Fitzpatrick 181-607 481

Rachel Murray 170-171 482

Worthu Parker 120-505 483

~~Thomas & Irene 120-120 484~~

~~W. W. 120-120 485~~

~~120-120 486~~

~~120-120 487~~

Christopher & Iva Mae Skinner 186-492 506

Earl A. & Irene Morris 179-403 505

Charles Wolfe 181-137 504

Andrew & Arthur 503

James Pico 145-442 502

Raymond L. Cunningham 177-406 501

~~Bend & Louise 120-630 500~~

120-630

120-630

120-630

120-630

Stella F. Rockhold 153-554 488

489

James Holbert 147-33 490

491

Ashland Oil + The Pennsalt Co. Refining Co. Inc. 141-142 492

493

177-46 Mary 494

495

496

497

498

499

Carl M. Pico, et al. 194-93 494

849

850

851

852

853

854

855

500-500

500-500

