



Henry Finsterwaulds Survey in Guysville

83 10
82 6
1.4

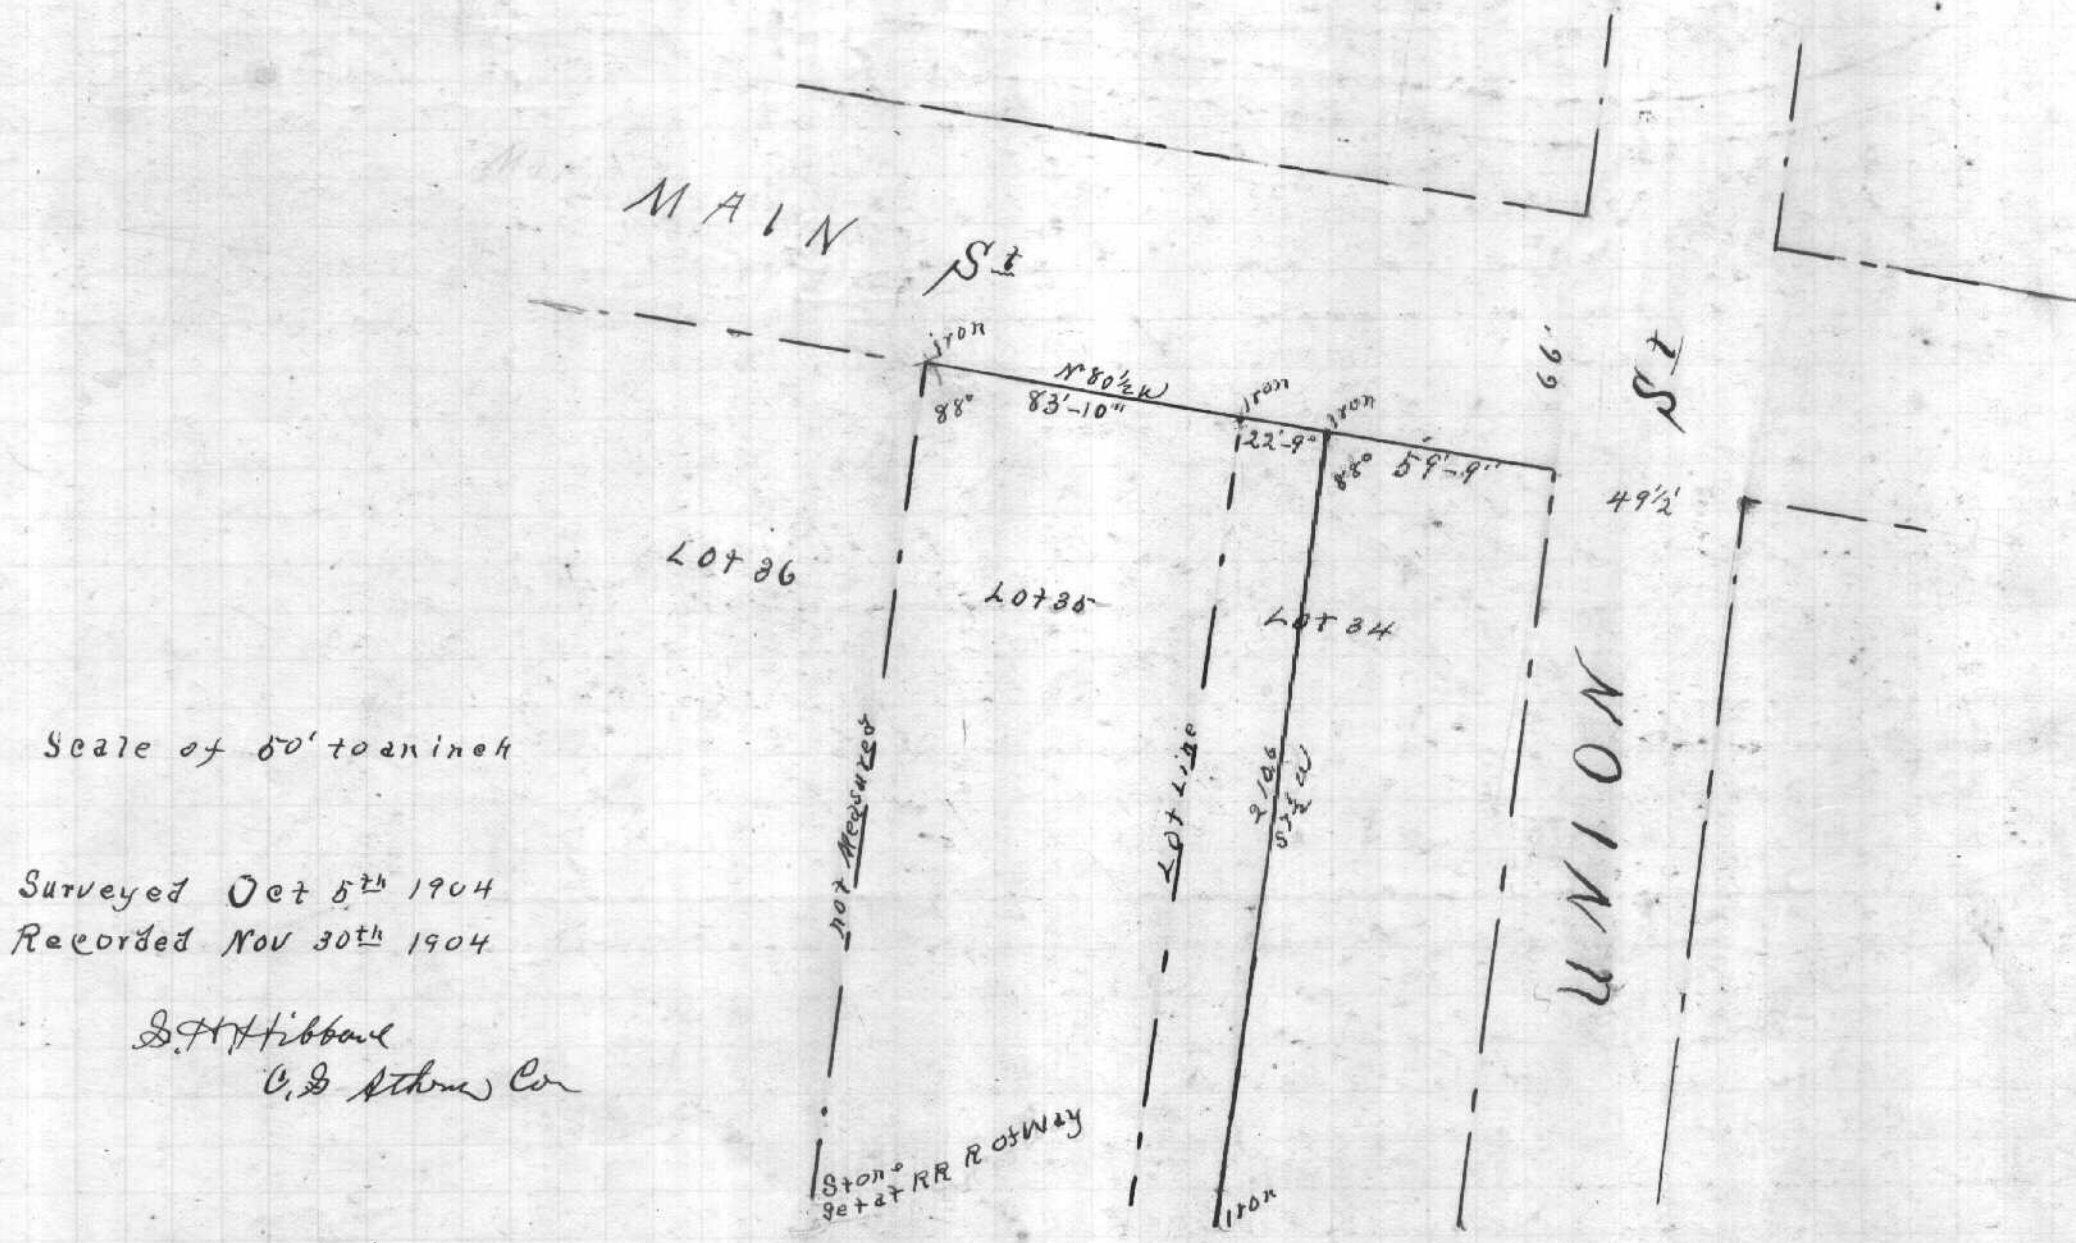

Otto Barths Survey of Lot No 459 in Athens

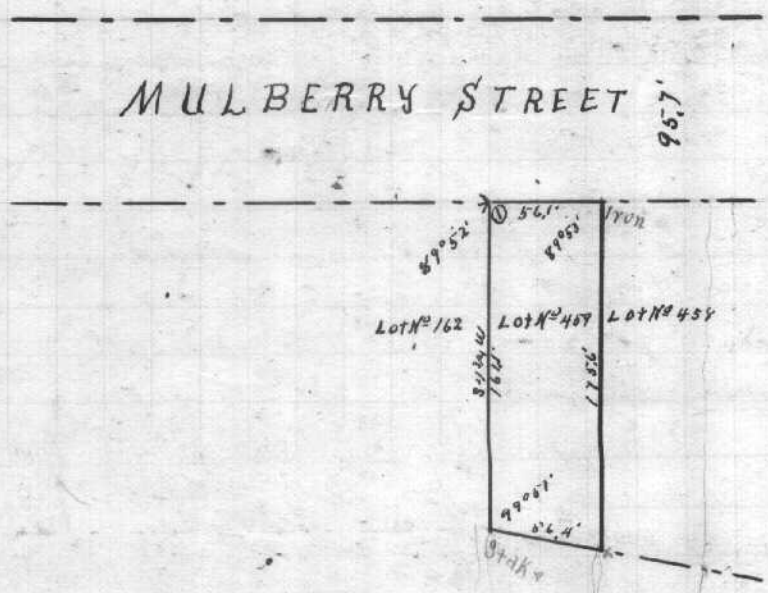

⊙ on East side of Curb, 1' South of Northend

Scale of 100' to an inch

Surveyed Oct 25th 1904
Recorded Dec 2nd 1904

S. H. Hibbard
Surveyor of Athens Co