


(Rome Twp)  
Maklon Hayes Survey in Section N<sup>o</sup> 13 Town N<sup>o</sup> 6 Range N<sup>o</sup> 12

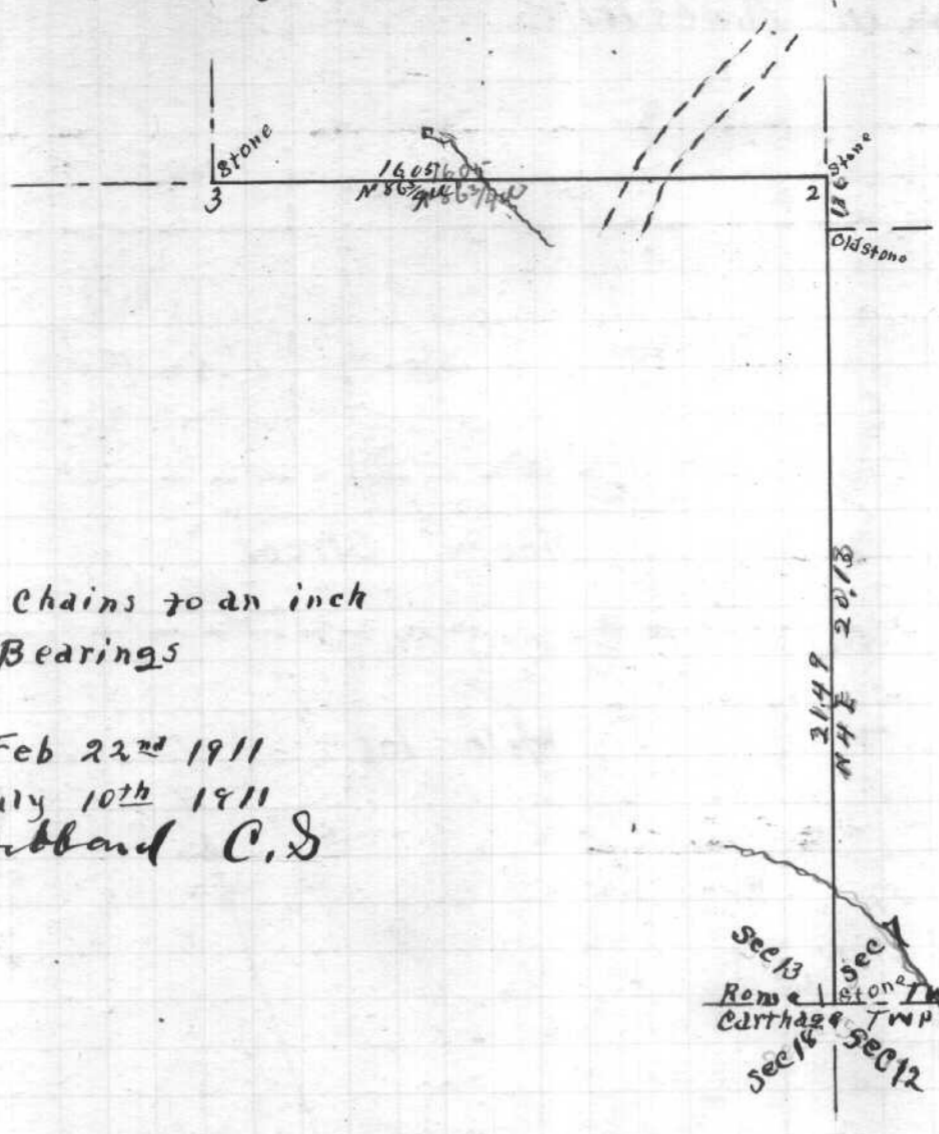

Scale of 5 chains to an inch  
Corrected Bearings

Surveyed Feb 22<sup>nd</sup> 1911  
Recorded July 10<sup>th</sup> 1911  
S. A. Hubbard C. S.


1} W.O 30" S 27 1/2 E 47

2} Stone  
Found Holes of Both old Hick Trees & stake hole

3} Stone  
Found remains of Both Trees and stake hole



DW Cornelius Survey in Lots Nos 19 & 20 in Savannah (Guysville) Rome

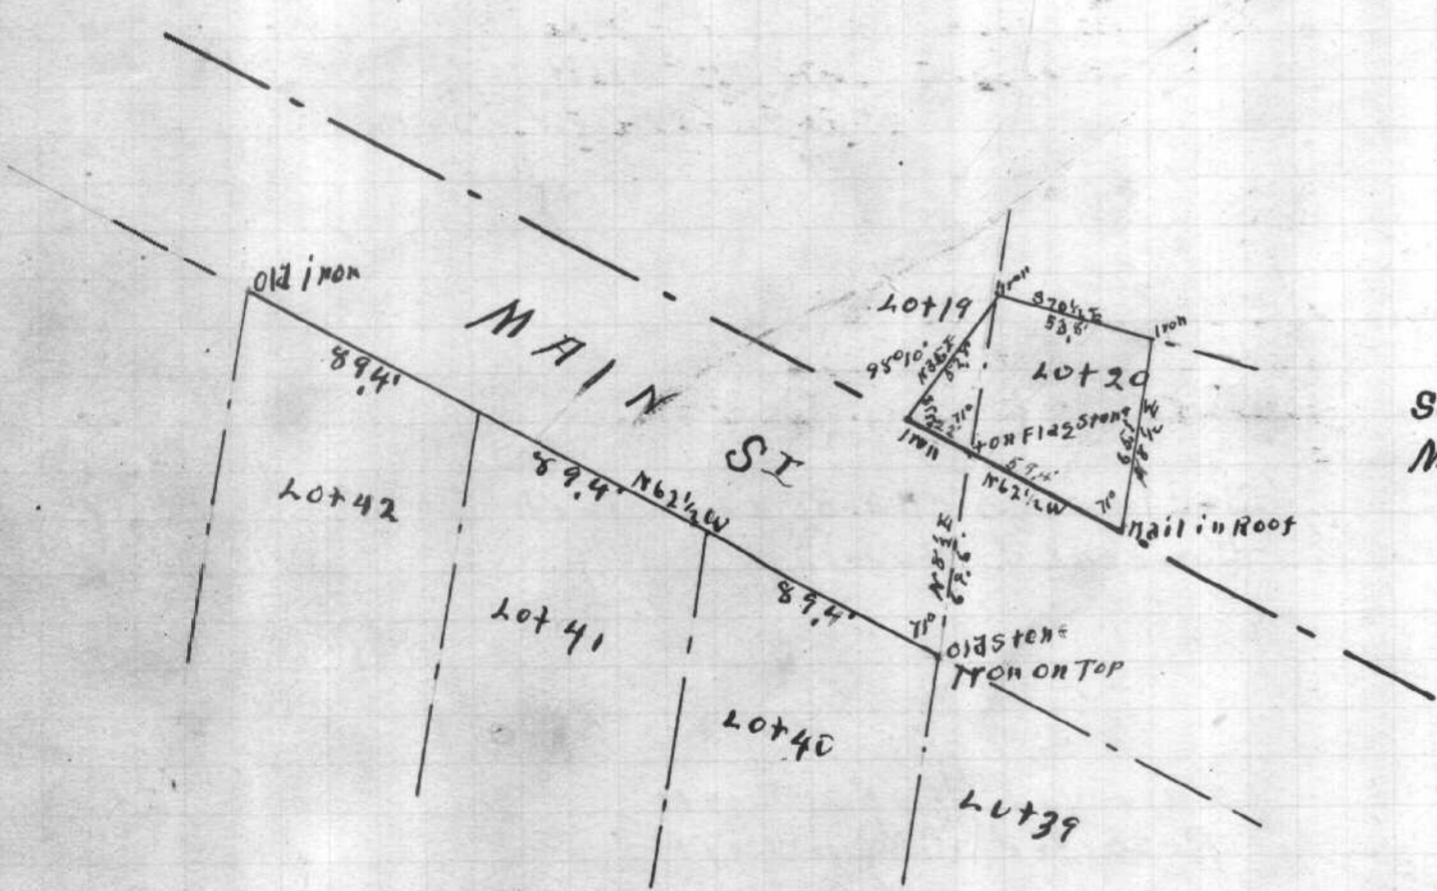

Scale of 66' to an inch  
Magnetic Bearings

Surveyed March 21<sup>st</sup> 1911  
Recorded July 12<sup>th</sup> 1911  
S. A. Hubbard C. S.