


A.C. Dailey's Survey in Albany Town N^o 10 Range N^o 15


See

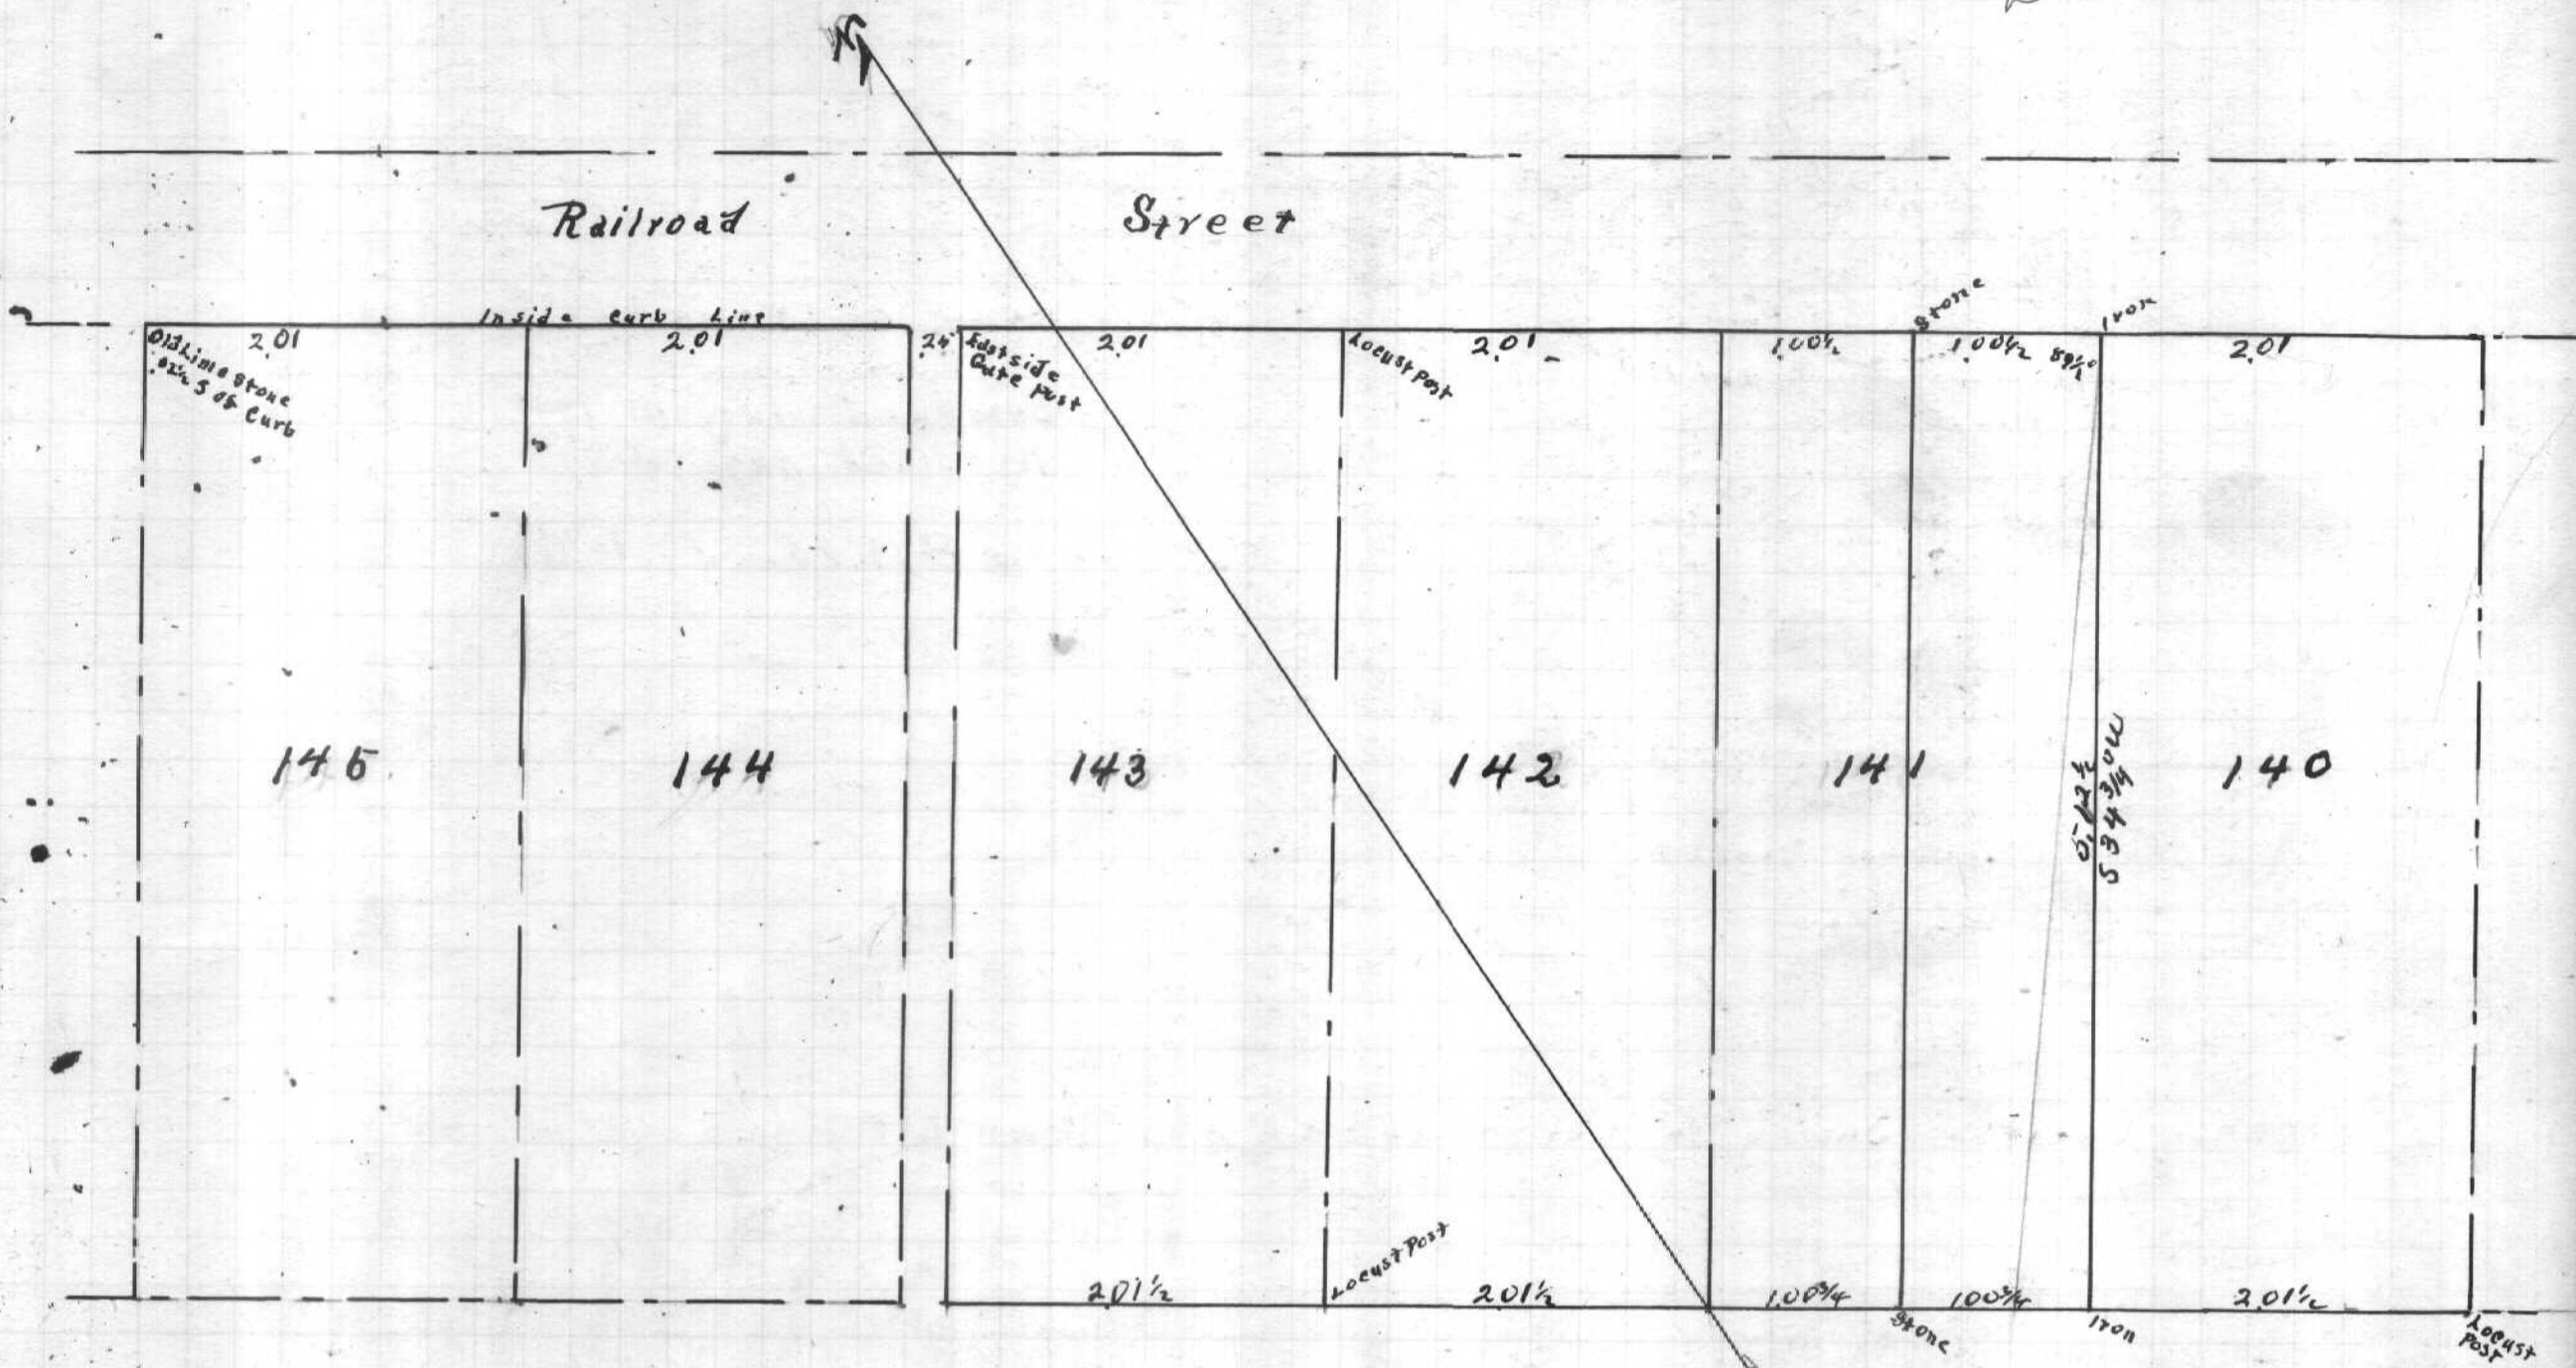

Scale 1 chain to an inch
Magnetic Bearings

Surveyed June 30th 1911
Recorded July 22nd 1911
S.H. Helbard C.S.

F.S. Coultrap and J.H. Cline's Survey in Lot #43, Athens.

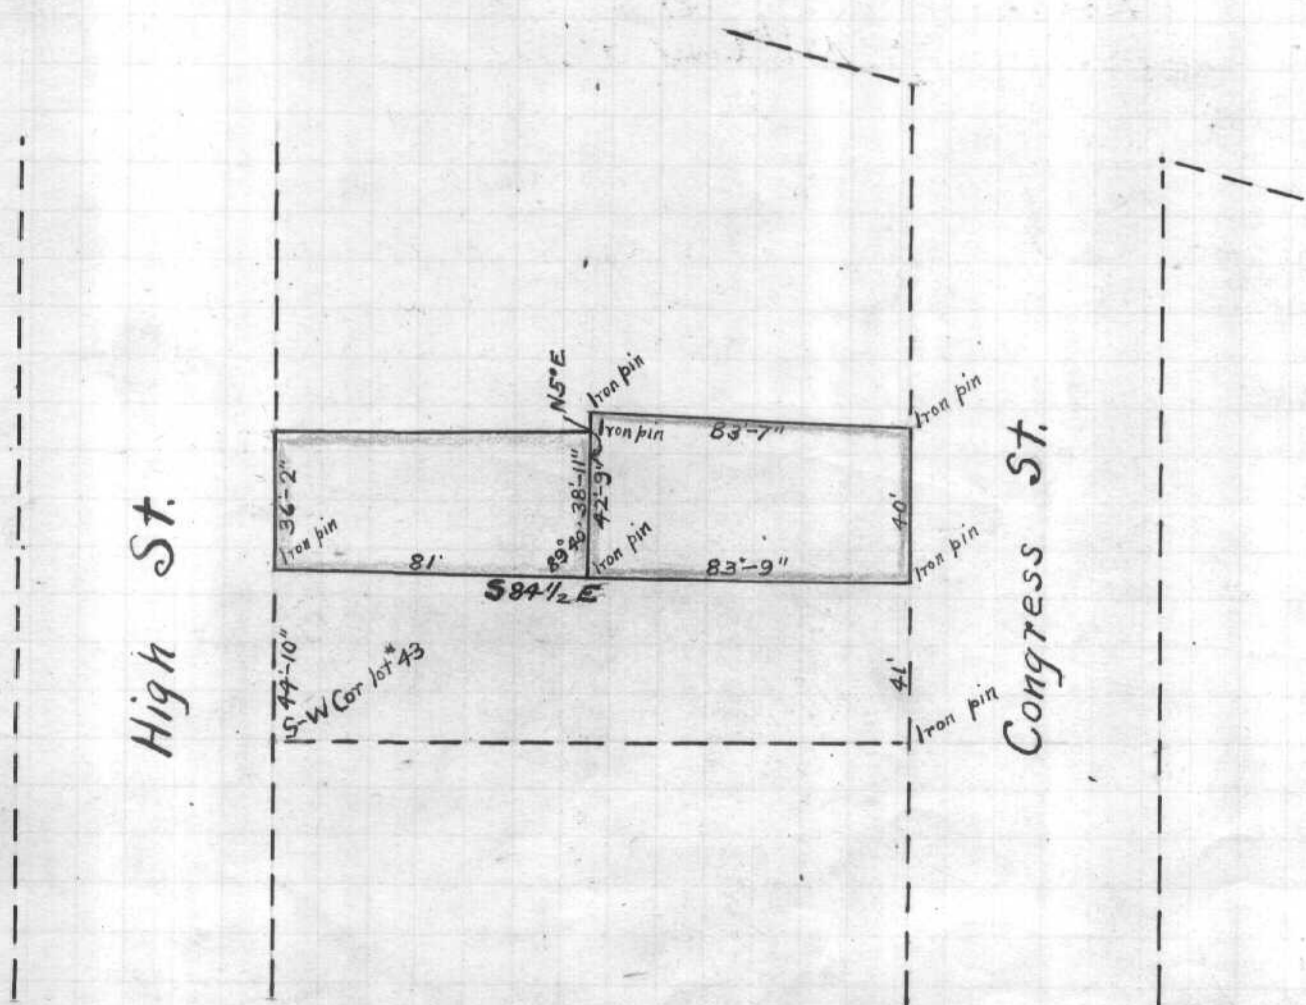

Scale 1" = 50'
Surveyed Aug. 2 1911.
Recorded Aug. 5 1911.

Arthur Anderson