


W^m Vorhes Survey in Lotts N^o 30th & 31 in Albany Tⁿ N^o 10 Range N^o 15

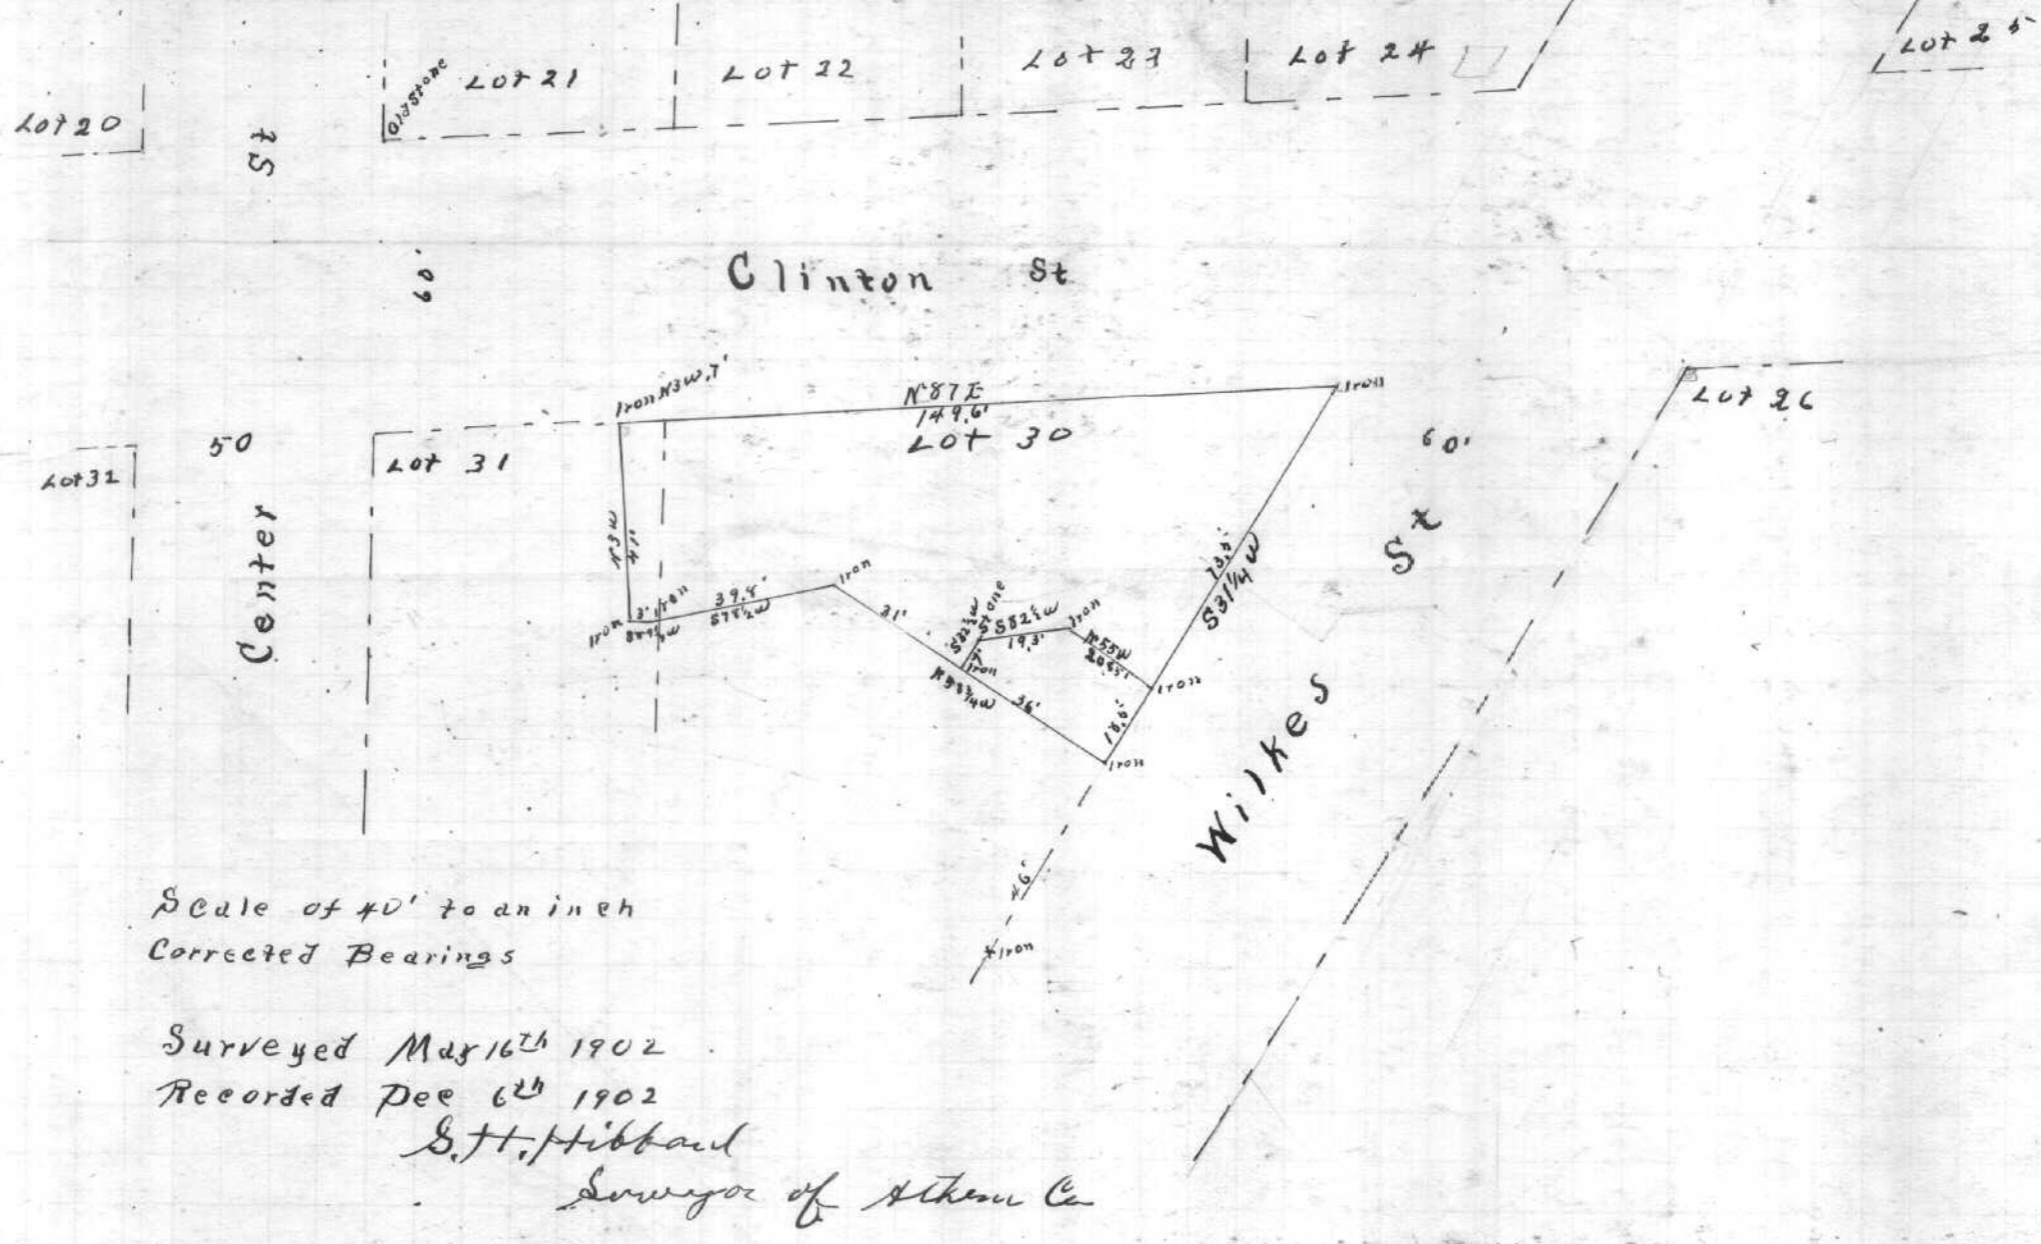

A. P. Wemmers Survey in Sec N^o 5 Town N^o 10 Range N^o 14 Dover Twp

- 1 { Sugar 13" N 36 W 3 1/4 } Marked by Coulson
- { WO 24" S 20 E 28 1/2 }
- 2 { W Oatump 30" N 88 1/2 W 12
- { BO 12" S 81 E 41 1/2
- { Walnut 5" N 41 W 39 1/2
- 3 { BO 26" S 67 E 9 } Marked by Coulson
- { WO 42" N 73 W 62
- { Walnut 10" N 79 E 61
- 4 { Stone N 40 1/2 E 32 1/4
- 5 { WO 30" S 20 1/4 E 17 1/2
- { WO 14" N 46 E 34

