


ENVELOPE: 161B

ATHENS - INLOTS 1024 & 1025

In Lots 1024 & 1025
Village of Athens.
certify the above plat to be correct
F.R. Baker.

Received for record July 24th 1899
at 1:30 O'clock P.M.

Recorded July 24th 1899
in Plat Book No. 3, Page 92.
Attest Elmer Golden
Recorder

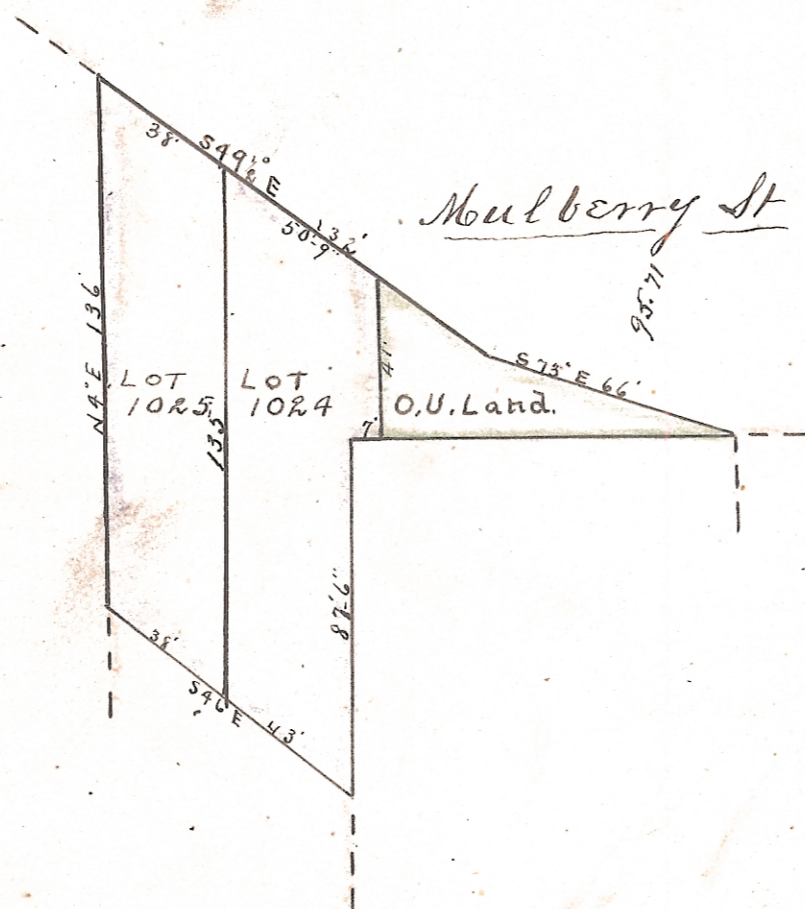

RECORDED
JUL 24 1899