


Sec 16 SW  
Alexander  
313-879

3AC

Sec 16

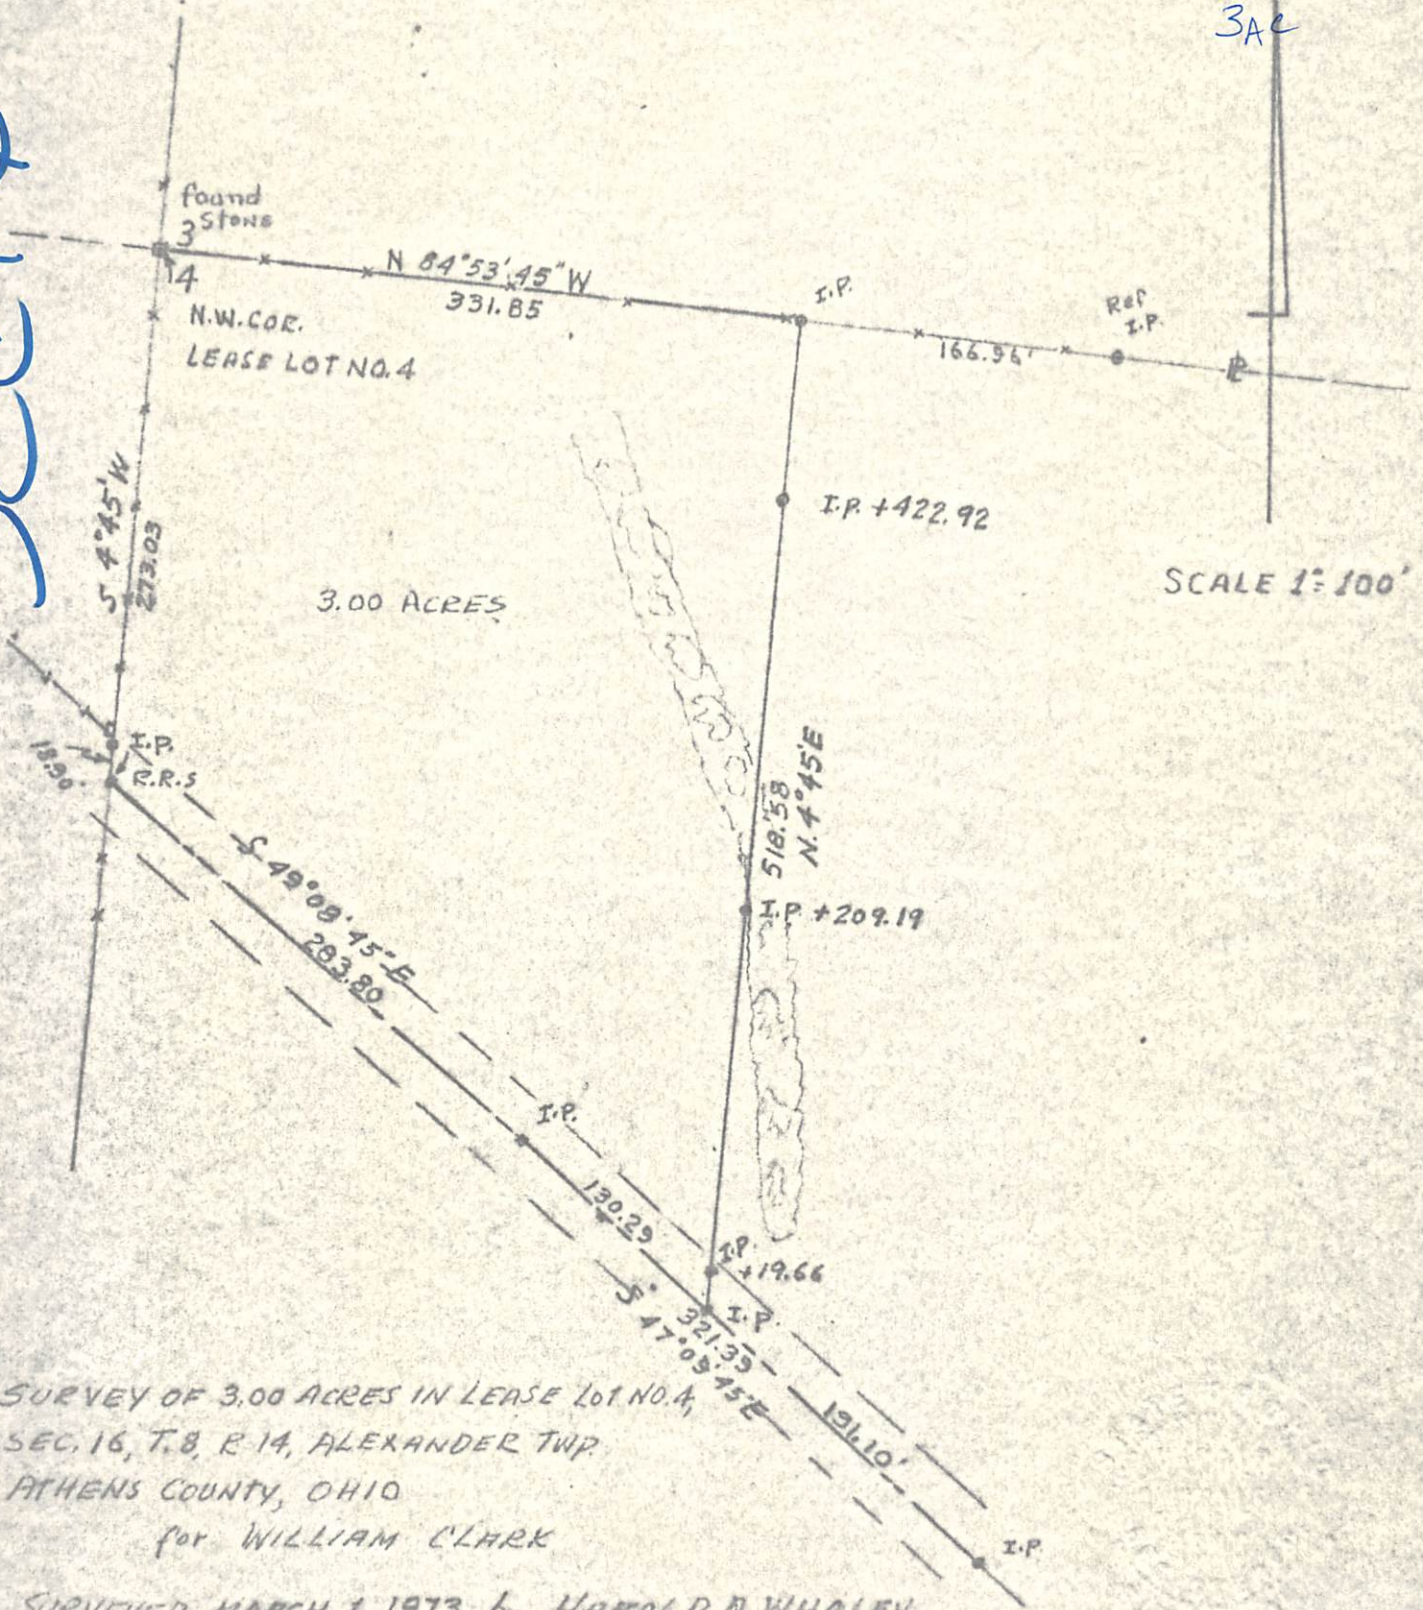

SURVEY OF 3.00 ACRES IN LEASE LOT NO. 4,  
SEC. 16, T. 8, R. 14, ALEXANDER TWP.  
ATHENS COUNTY, OHIO  
for WILLIAM CLARK

SURVEYED MARCH 3, 1973 by HAROLD D. WHALEY  
Harold D. Whaley  
REG. SURV. NO. 4886

10

3.00 ACRES

Situated in Lease Lot No. 4, Sec 16, T. 8, R. 14, Alexander Township, Athens County, Ohio and being more particularly described as follows:

Beginning at a Stone on the Northwest Corner of Lease Lot No. 4, Thence along the West line of Lease Lot No. 4, S. 4° 45' W (passing an Iron Pin at 254.13 feet) for a total distance of 273.03 feet to a R.R. spike in the Centerline of the public Road;

Thence along the Centerline of S. 49° 08' 45" E. 283.80 feet to an Iron pin;

Thence S. 47° 09' 45" E 130.29 feet to an Iron pin;

Thence leaving the highway and parallel with the West line of Lease Lot No. 4, N 4° 45' E (passing an Iron pin at 19.66 feet, an Iron pin at 209.14 feet, and an Iron pin at 422.92 feet) for a total distance of 518.58 feet to an Iron pin on the North line of Lease Lot No. 4;

Thence along the North line of Lease Lot No. 4, N 84° 53' 45" W 331.85 feet to the point of beginning, containing 3.00 Acres, and being part of a 73.60 Acre tract described in Vol. 185-page 611 of the Athens County Deed Records;

Surveyed March 1, 1973 by Harold D. Whaley  
Harold D. Whaley  
Reg. Surv. No. 4926

APR 73  
3-5-73  
gk