


Alexander
 Rec. 4 Fl. 1
 305-909

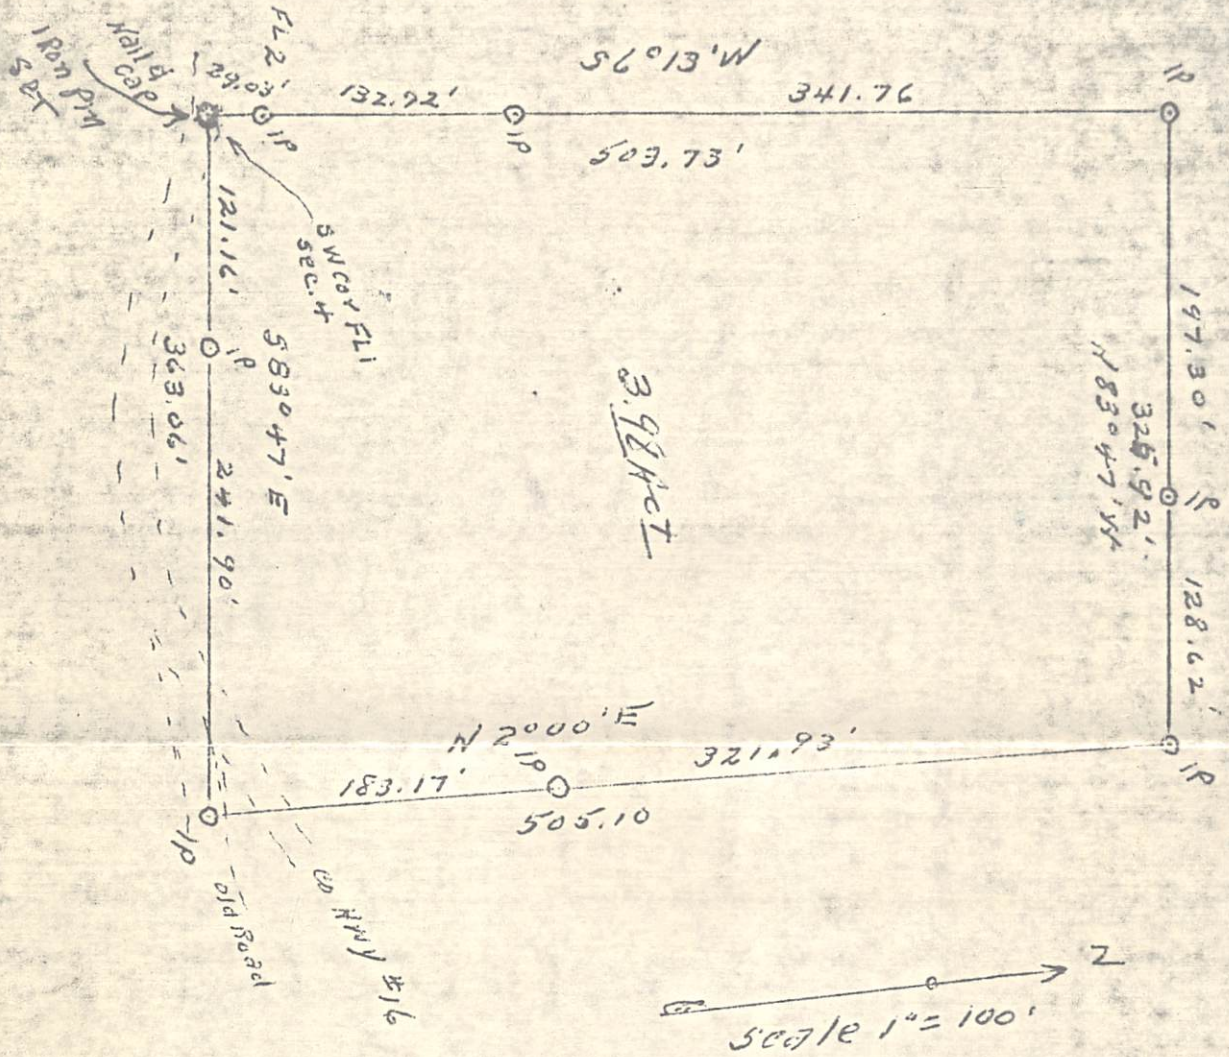

Sec. 4

plat

of Survey 10

the SW Corner of Fl. 1

Sec 4 T 8 R 14 Alex. Indor

TWP Athens County Ohio

Surveyed for Keith & Johnson

By Jack Gollman

Reg SUR 1034

Aug 24 1970

Jack Gollman
 Jack Gollman



Sec. 4

Alexander Twp.

3.98 AC

S.E.

2