


SOUTHEASTERN LAND SURVEYS

LEONARD F. SWOYER
REGISTERED PROFESSIONAL LAND SURVEYOR

3428 Pleasant Hill Road
Athens, Ohio 45701
614/593-8701

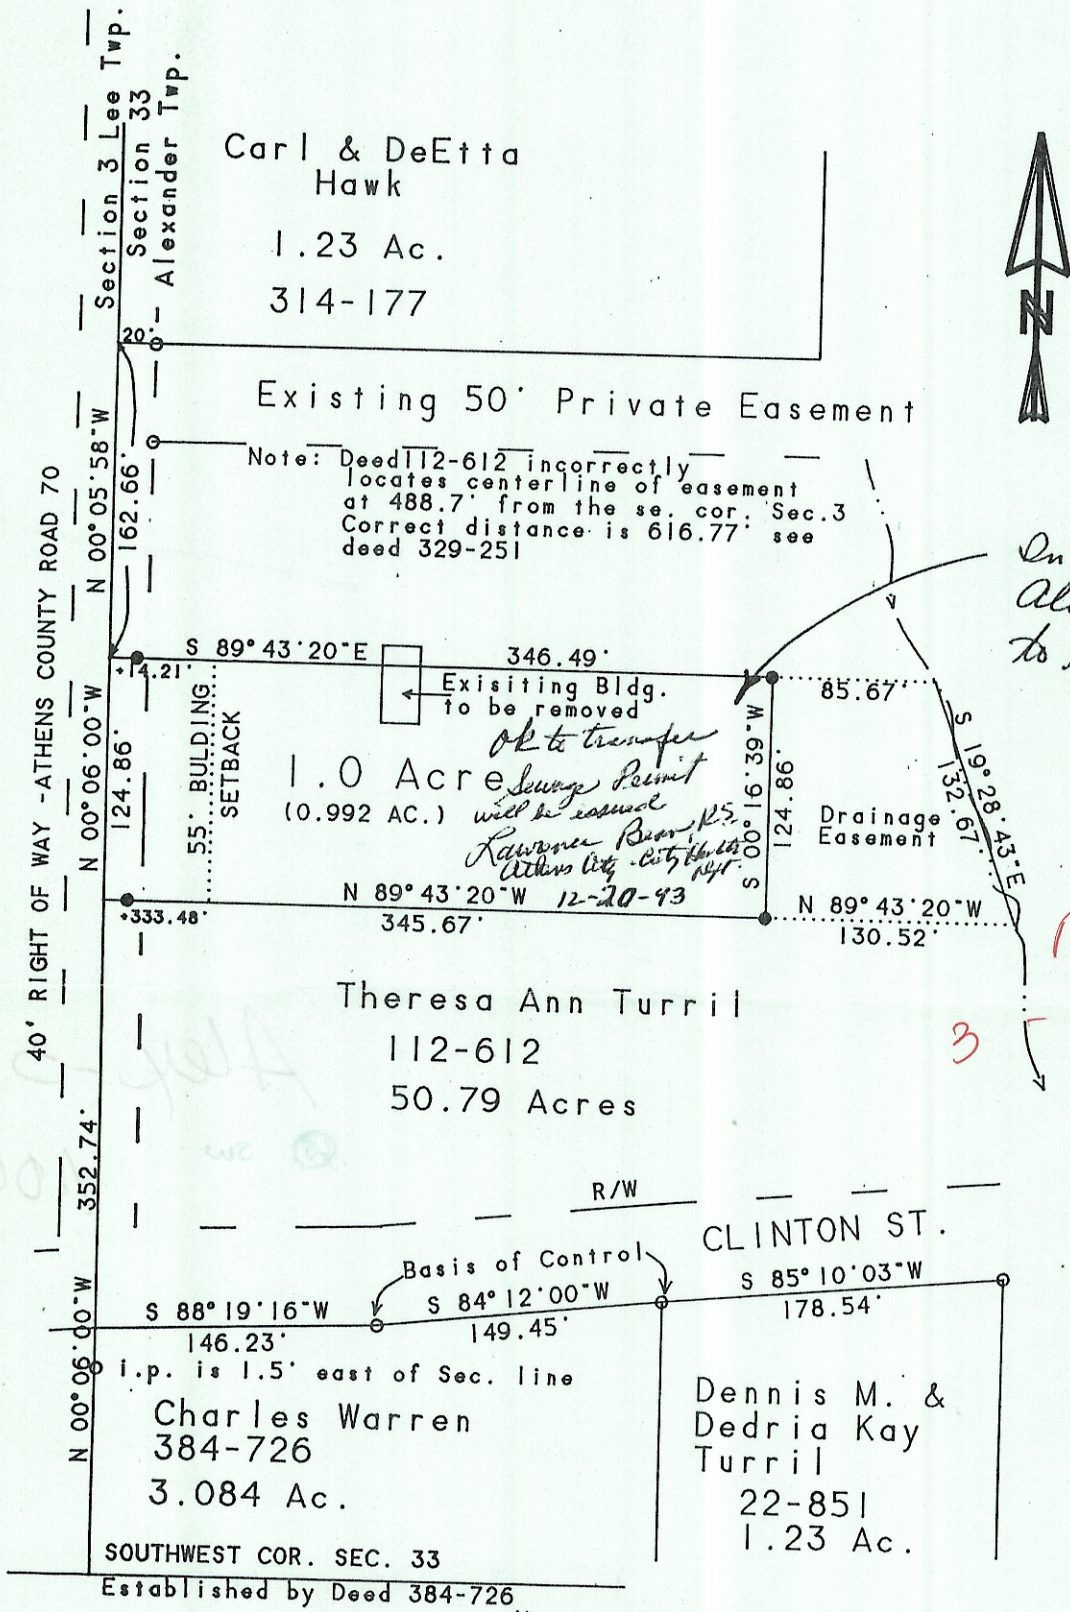

- ⊙ - IRON PIN SET
- - IRON PIN FOUND

Note: All set iron pins are 5/8" rebar, 30" in length with plastic I.D. marker scribed
L.F. Swoyer
R.L.S. 6765

Bearings shown are to an assumed meridian and are used to denote angles only
Basis of bearing is Section Line established from the southwest corner of Sec. 33 and a point 20' West of found iron pin off set from the sw. cor. of deed 314-177

Pertinent Documents and Sources Used:
Existing Deeds and Tax Plat

Plat of 1.0 Acre (0.992Ac.) Scale 1" = 100'

Surveyed for Dave Turril Date 12/17/93

Subdivision -----

Township Alexander Section 33 Town 8 Range 14

Corporation ----- County Athens State Ohio

Leonard F. Swoyer Jr.
Leonard F. Swoyer Jr. Reg. Prof. Land Surveyor No. 6765

