## SOUTHEASTERN LAND SURVEYS

LEONARD F. SWOYER REGISTERED PROFESSIONAL LAND SURVEYOR

3428 Pleasant Hill Road Athens, Ohio 45701 740/593-8701

Situated in Lease Lots 1 & 4 of Section 11, and Lease Lot 1 of Section 17, Alexander Township, Town 8, Range 14, Athens County, Ohio and described as follows:

Commencing at the approximate southeast corner of said Lease Lot 4 of Section 11; thence on an assumed bearing North 86 Degrees 13 Minutes 43 Seconds West, passing an iron pin\* at 1.17 feet and a stone\* at 1658.75 feet, for a total distance of 2477.64 feet to a point at the approximate southwest corner of said Lease Lot 4; thence along the approximate west line of said Lease Lot 4 North 03 Degrees 47 Minutes 11 Seconds East distance of 892.48 feet to a point THE TRUE POINT OF BEGINNING; thence along a new line the following two bearings and distances: 1) North 57 Degrees 11 Minutes 10 Seconds West a distance of 319.63 feet to a set iron pin; thence 2) North 30 Degrees 09 Minutes 45 Seconds East passing a set iron pin at 738.65 feet, for a total distance of 769.14 feet to a point on the grantor's east line in Alexander Township Road 56; thence along the grantor's east line and along said road the following seven bearings and distances: 1) South 07 Degrees 51 Minutes 23 Seconds East a distance of 106.58 feet to a point; thence 2) South 15 Degrees 26 Minutes 31 Seconds East a distance of 88.73 feet to a point; thence 3) South 32 Degrees 28 Minutes 32 Seconds East a distance of 83.97 feet to a point; thence 4) South 33 Degrees 22 Minutes 38 Seconds East—a distance of 155.04 feet to a point; thence 5) South 37 Degrees 55 Minutes 19 Seconds East a distance of 86.18 feet to a point; thence 6) South 46 Degrees 17 Minutes 24 Seconds East a distance of 115.08 feet to a point; thence 7) South 40 Degrees 49 Minutes 18 Seconds East a distance of 78.93 feet to a point; thence leaving said road along a new line South 58 Degrees 22 Minutes 06 Seconds West passing a set iron pin at 11.87 feet, for a total distance of 507.98 feet to a set iron pin ; thence North 57 Degrees 11 Minutes 10 Seconds West a distance of 49.55 feet to the POINT OF BEGINNING and containing 6.649 acres and being a part of Parcel Two as described in Volume 378 Page 945 of the Athens County Official Deed Records. There are 2.938 acres in Lease Lot 4 of Section 11, 1.405 acres in Lease Lot 1 of Section 11 and 2.306 acres in Lease Lot 1 of Section 17.

\*Denotes calculated location of monument based on a previous survey.

Note: Unless otherwise noted, all set iron pins are 5/8 inch diameter rebar and 30 inches in length and capped with a plastic identification marker inscribed " L.F. SWOYER PS 6765.

The above description was prepared under the supervision of Leonard F. Swoyer Registered Professional Land Surveyor No. 6765 and based on a survey performed by Southeastern Land Surveys dated December 19, 2003.

Subject to all easements and right of ways of record.

Description Checked for Mathematical Accuracy Athens County ENGINEER'S OFFICE


12-22-0

BY DATE:

SUBDIVISIONS

CONSTRUCTION

PROPERTY

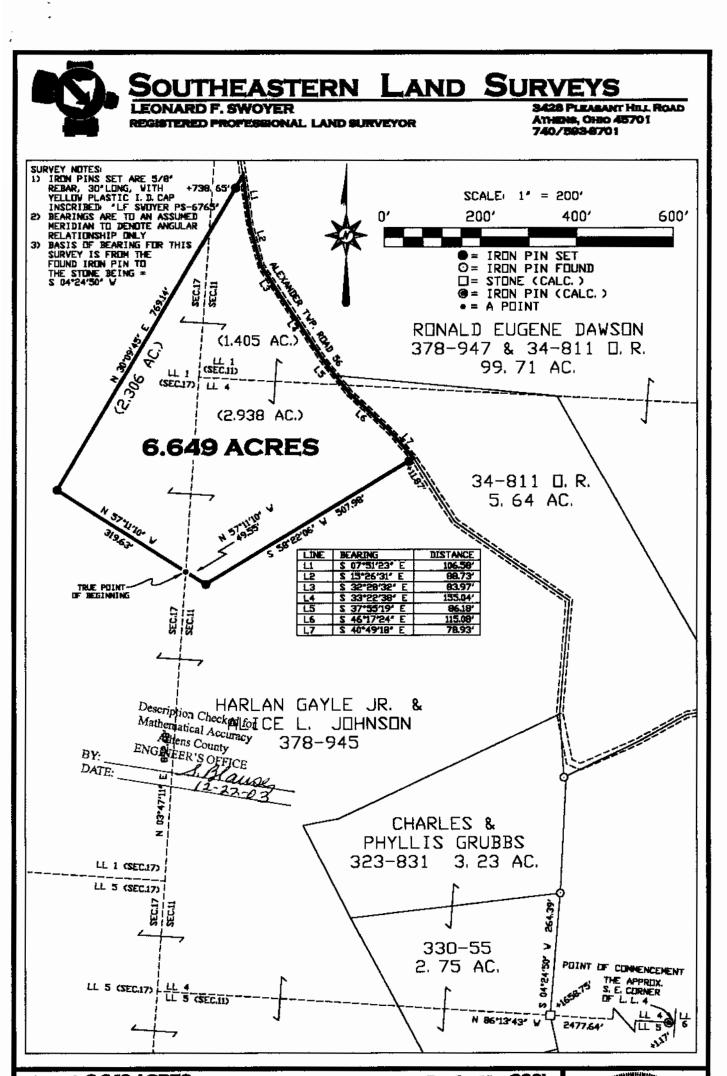

Plat of 6.649 ACRES

Surveyed for: MR. HARLAN G. JOHNSON

Subdivision

LL.1, SEC.17 & LL1, SEC.11 & LL4 SEC.11

Township

ALEXANDER

Section 11 & 17 Town 8 Range 14

Corportation

County

ATHENS

Ohio

Job No. 120511403



"Sight" Survey 970324-Z-0324

Monday, December 22, 2003 9:54 am. Pg: 1'
Registered to:
ATHENS COUNTY ENGINEER DEPT.
File Name:
C:\LOTSPL~1\ALEX\S11\T56-6-64.ZAK

Po	oint Direction	Distance	Northing	Easting Elev	ation
Database	opened: Monday, Decer	mber 22, 2003 9:4	9 am.		
Assigned	point				
	1		5000.00000	5000,00000	0.000
tart	4		E000 00000	E000 00000	0.000
	1 57 1110	210.62	5000.00000	5000.00000	0.000
Raw:	n57.1110w	319.63			
R	N 57°11'10.0" W 2	319.630	5173.21132	4731.37168	0.000
Raw:	n30.0945e	769.14	3173.21132	4/31.3/100	0.000
R	N 30°09'45.0" E	769.140			
	3	707.140	5838.21272	5117.82928	0.000
Raw:	s07.5123e	106.58	0000 man n	071710/2720	
R	S 7°51'23.0" E	106,580			
	4		5732.63310	5132.39776	0.000
ław:	s15.2631e	88.73			
R	S 15°26'31.0" E	88.730			
	5		5647.10619	5156.02317	0.000
law:	s32.2832e	83.97			
R	S 32°28'32.0" E	83.970			
	6		5576.26736	5201.11000	0.000
law:	s33.2238e	155.04			
R	S 33°22'38.0" E	155.040		m	
	7	0.5.50	5446,79863	5286.40507	0.000
aw:	s37.5519e	86.18			
R	S 37°55'19.0" E	86.180	E470 04 5 4 5	E440 AE084	0.000
	8	115.00	5378.81565	5339.37021	0.000
law:	s46.1724e	115.08			
R	S 46°17'24.0" E 9	115.080	E200 20448	E400 E5E00	0.000
aw:	s40.4918e	78.93	5299.29438	5422.55539	0.000
R	S 40°49'18.0" E	78.930			
	10	70.730	5239.56427	5474.15247	0.000
aw:	s58.2206w	11.87			
R	S 58°22'06.0" W	11.870			
	11		5233.33897	5464.04591	0.000
raverse erunnin	aw Data Modified g Modified Traverse				
	Adjusted Points				
So to	1		5000 00VV	±000 00000	0.000
P tarl	1 S 0°00'00.0" E	10.000	5000.00000 New Backsi	5000.00000 ght Bng. (B.S. is ~BS1)	0.000
	1		5000,00000	5000,00000	0.000
law:	N57.1110W	319.63	2000000000	500000	0.000
'R	N 57°11'10.0" W	319.630			
	2		5173.21132	4731.37168	0.000
aw:	N30.0945E	769.14			7. 7. 7. 7.

"Sight" Survey 970324-Z-0324

Monday, December 22, 2003–9:54 am. Pg: 2'
Registered to:
ATHENS COUNTY ENGINEER DEPT.
File Name:
C:\LOTSPL~1\ALEX\S11\T56-6-64.ZAK

Point	Direction	Distance	Northing	Easting	Elevation
	N 30°09'45.0" E	769.140			
3			5838.21272	5117.82928	0.000
	07.5123E	106.58			
R	S 7"51'23.0" E	106.580			
4			5732.63310	5132.39776	0.000
	15.2631E	88.73			
R -	S 15°26'31.0" E	88.730	E ( 10 10 ( 10	E4 = 4 0004 =	0.000
5	10.00000	93.07	5647.10619	5156.02317	0.000
aw: Si R	32.2832E S 32°28'32.0" E	83.97 83.970			
6	5 52 28 52.0" E	63.970	5576.26736	5201.11000	0.000
	33.2238E	155.04	5576.20756	5201.11000	0.000
R	S 33°22'38.0" E	155.040			
7	333 22360 6	100.040	5446.79863	5286.40507	0.000
	37.5519E	86.18	J440.7 9003	5280.40307	OXXX
R	S 37°55'19.0" E	86.180			
8	007 <b>00</b> 1707 E	007.100	5378.81565	5339.37021	0.000
	46.1724E	115.08	00,000	500000021	(1,000
R	S 46"17'24.0" E	115.080			
9	_ , ,, , <b></b>		5299.29438	5422.55539	0.000
aw: S	40.4918E	78.93			
R	S 40°49'18.0" E	78.930			
10			5239.56427	5474.15247	0.000
aw: S	58.2206W	507.98			
R	S 58°22'06.0" W	507.980			
11			4973.15082	5041.63940	0.000
pen Traverse	e - No Area				
recision Ratio	=	1:2.31 <b>E+</b> 23			
ength Traver		2311.260			
ength To Clo		0.000			
Error in Latitude =		0.000			
Error in Departure =		0.000			
error in Elevation =		0.000			
rea = Open I	Traverse - No Area				
otal Angular	Error =	0,00,00,00			
Error Per Station =		0°00'00.0"			
aw: n5	57.1110w	49.55			
	N 57°11'10.0" W	49.550			
12			5000.00256	4999.99583	0.000
1	S 58°26'10.7" E	0.005			
1			5000.00000	5000.00000	0.000
ras = 280651	.128 Sq. Feet or 6.64	9 Acres			
ea - 205001					