


OK 5-15-74
[Signature]

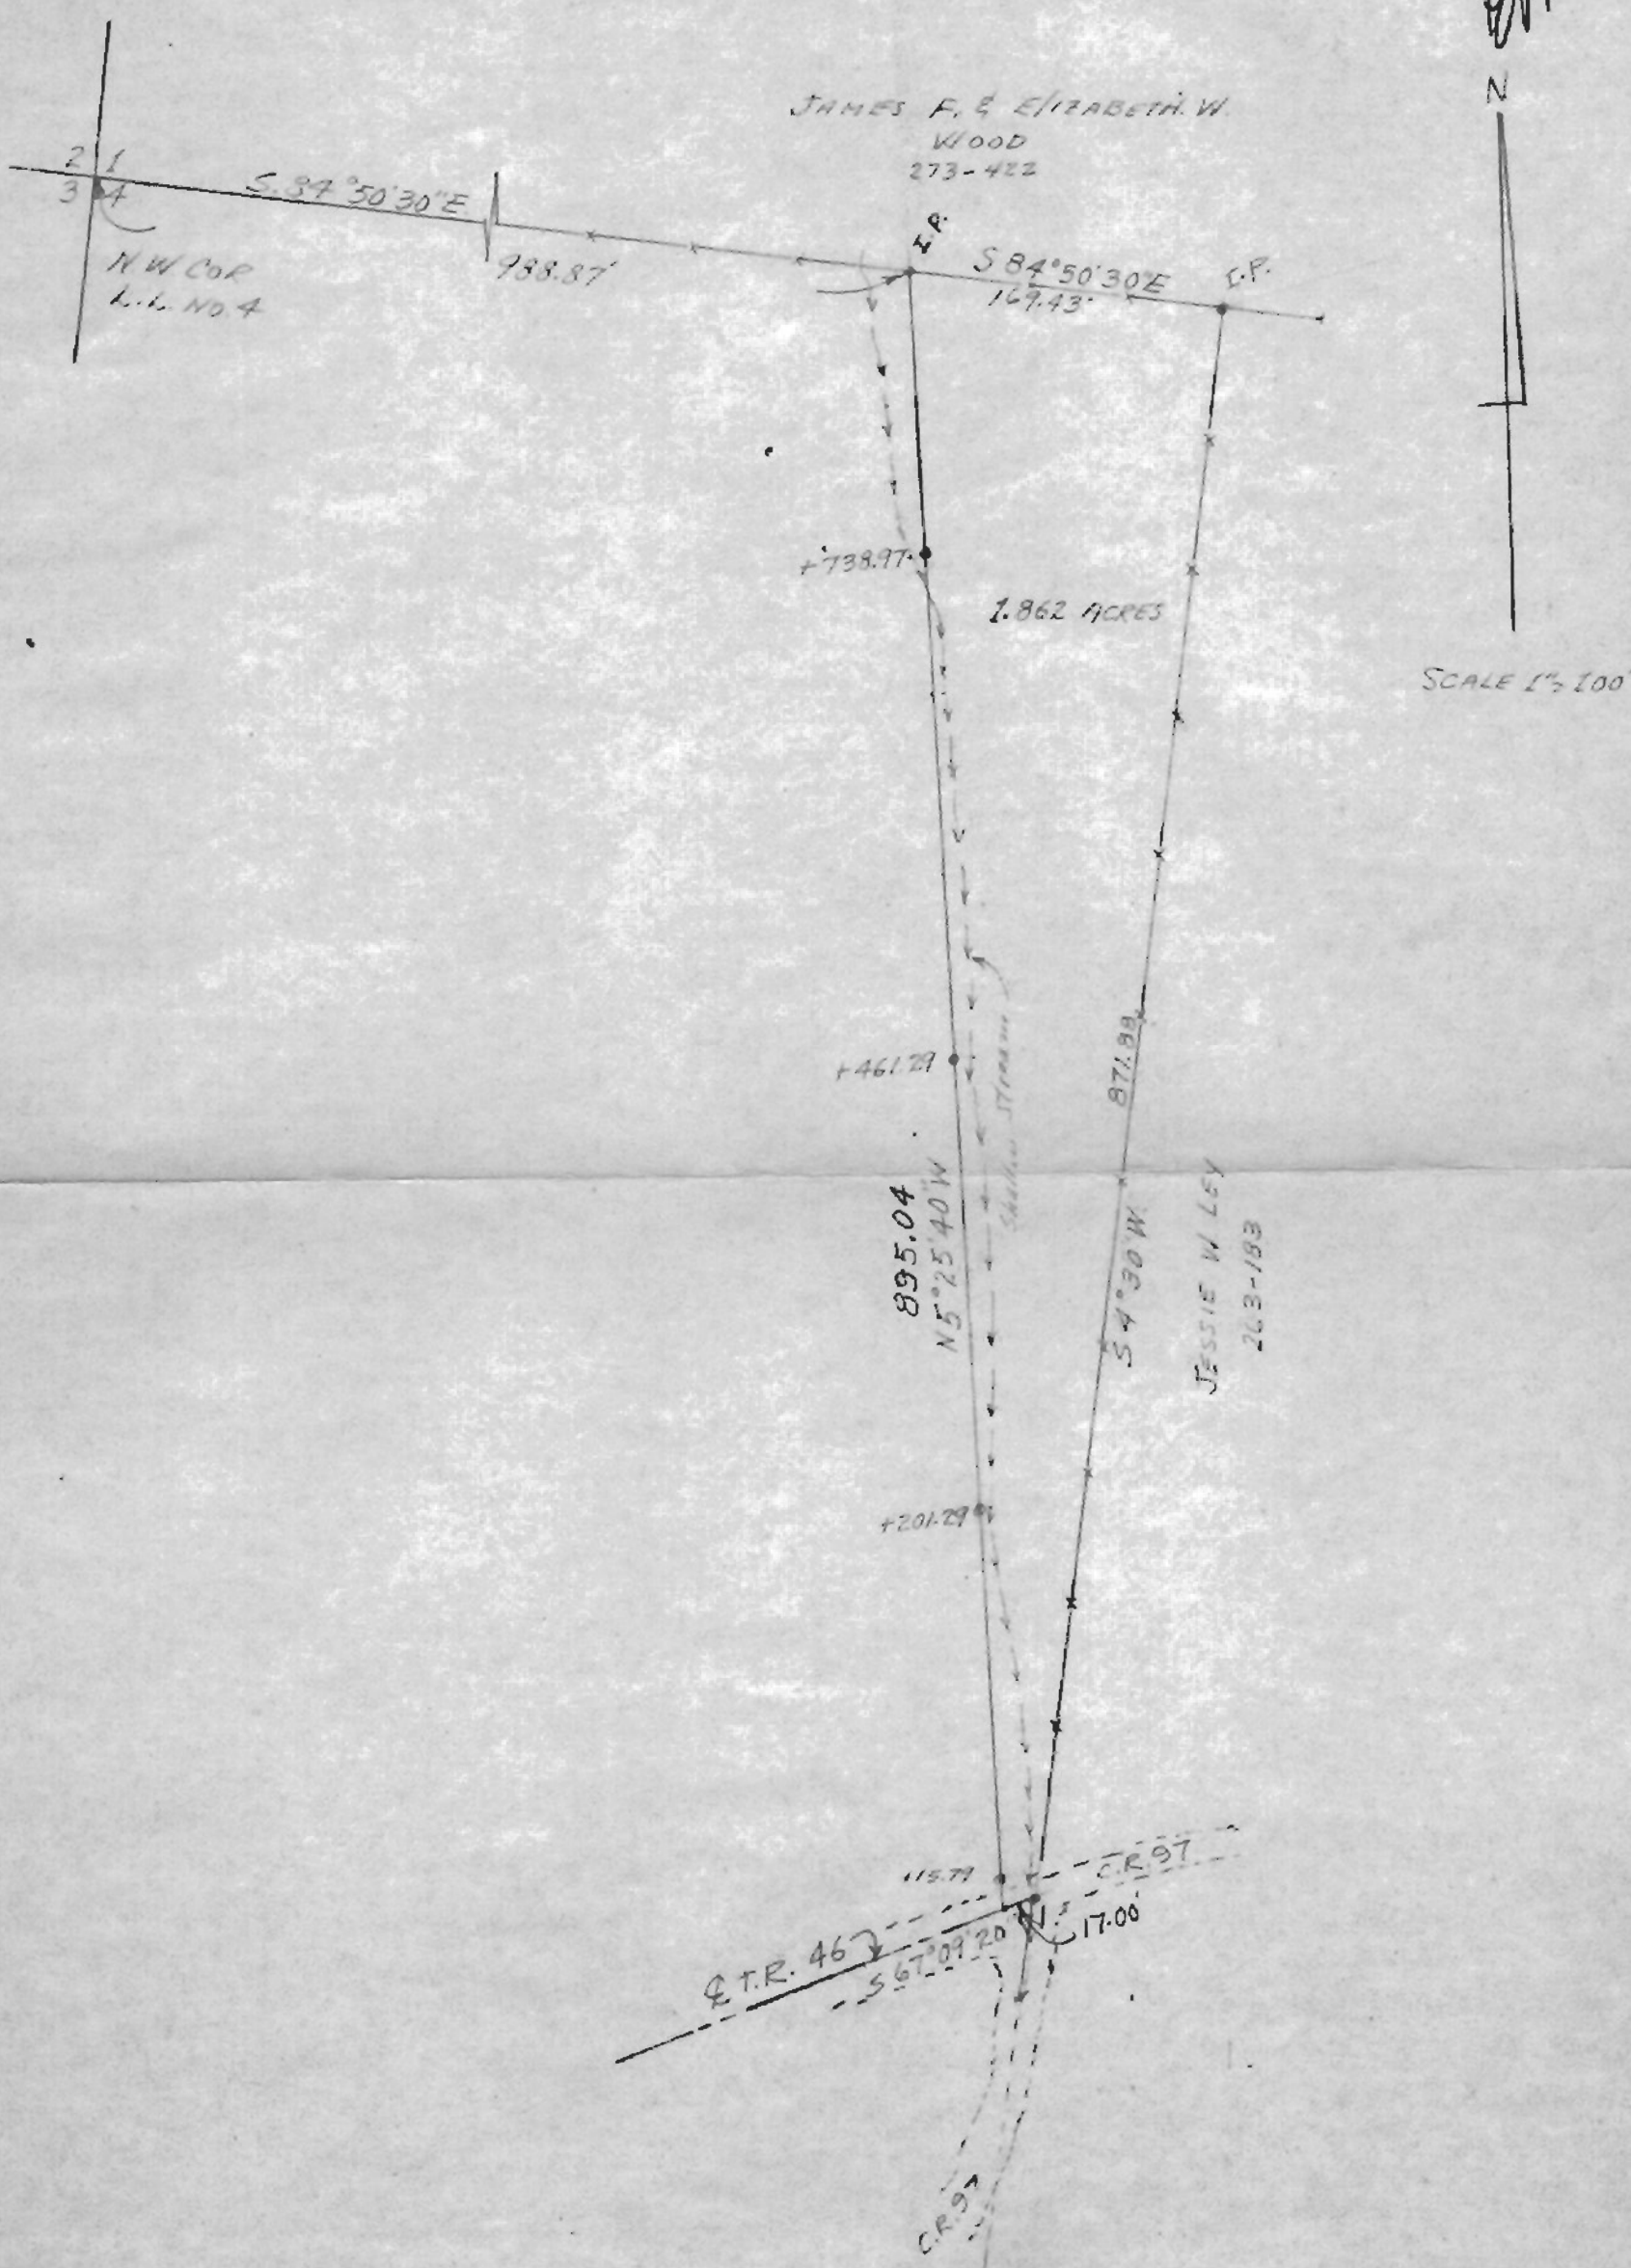

SURVEY OF A 1.862 ACRE TRACT IN LEASE LOT NO. 4,
SEC. 20, T. 8, R. 14, ALEXANDER TWP, ATHENS CO, OHIO
for HAROLD MORRIS

SURVEYED MARCH 15, 1974 by HAROLD D. WHALEY
Harold D. Whaley
REG. SURV. NO. 4986

