


SE CORNER LOT 7
NE CORNER LOT 7
S 26° 51' E 52.17' 58.08'
S 36° 20' 46" E 54.08'

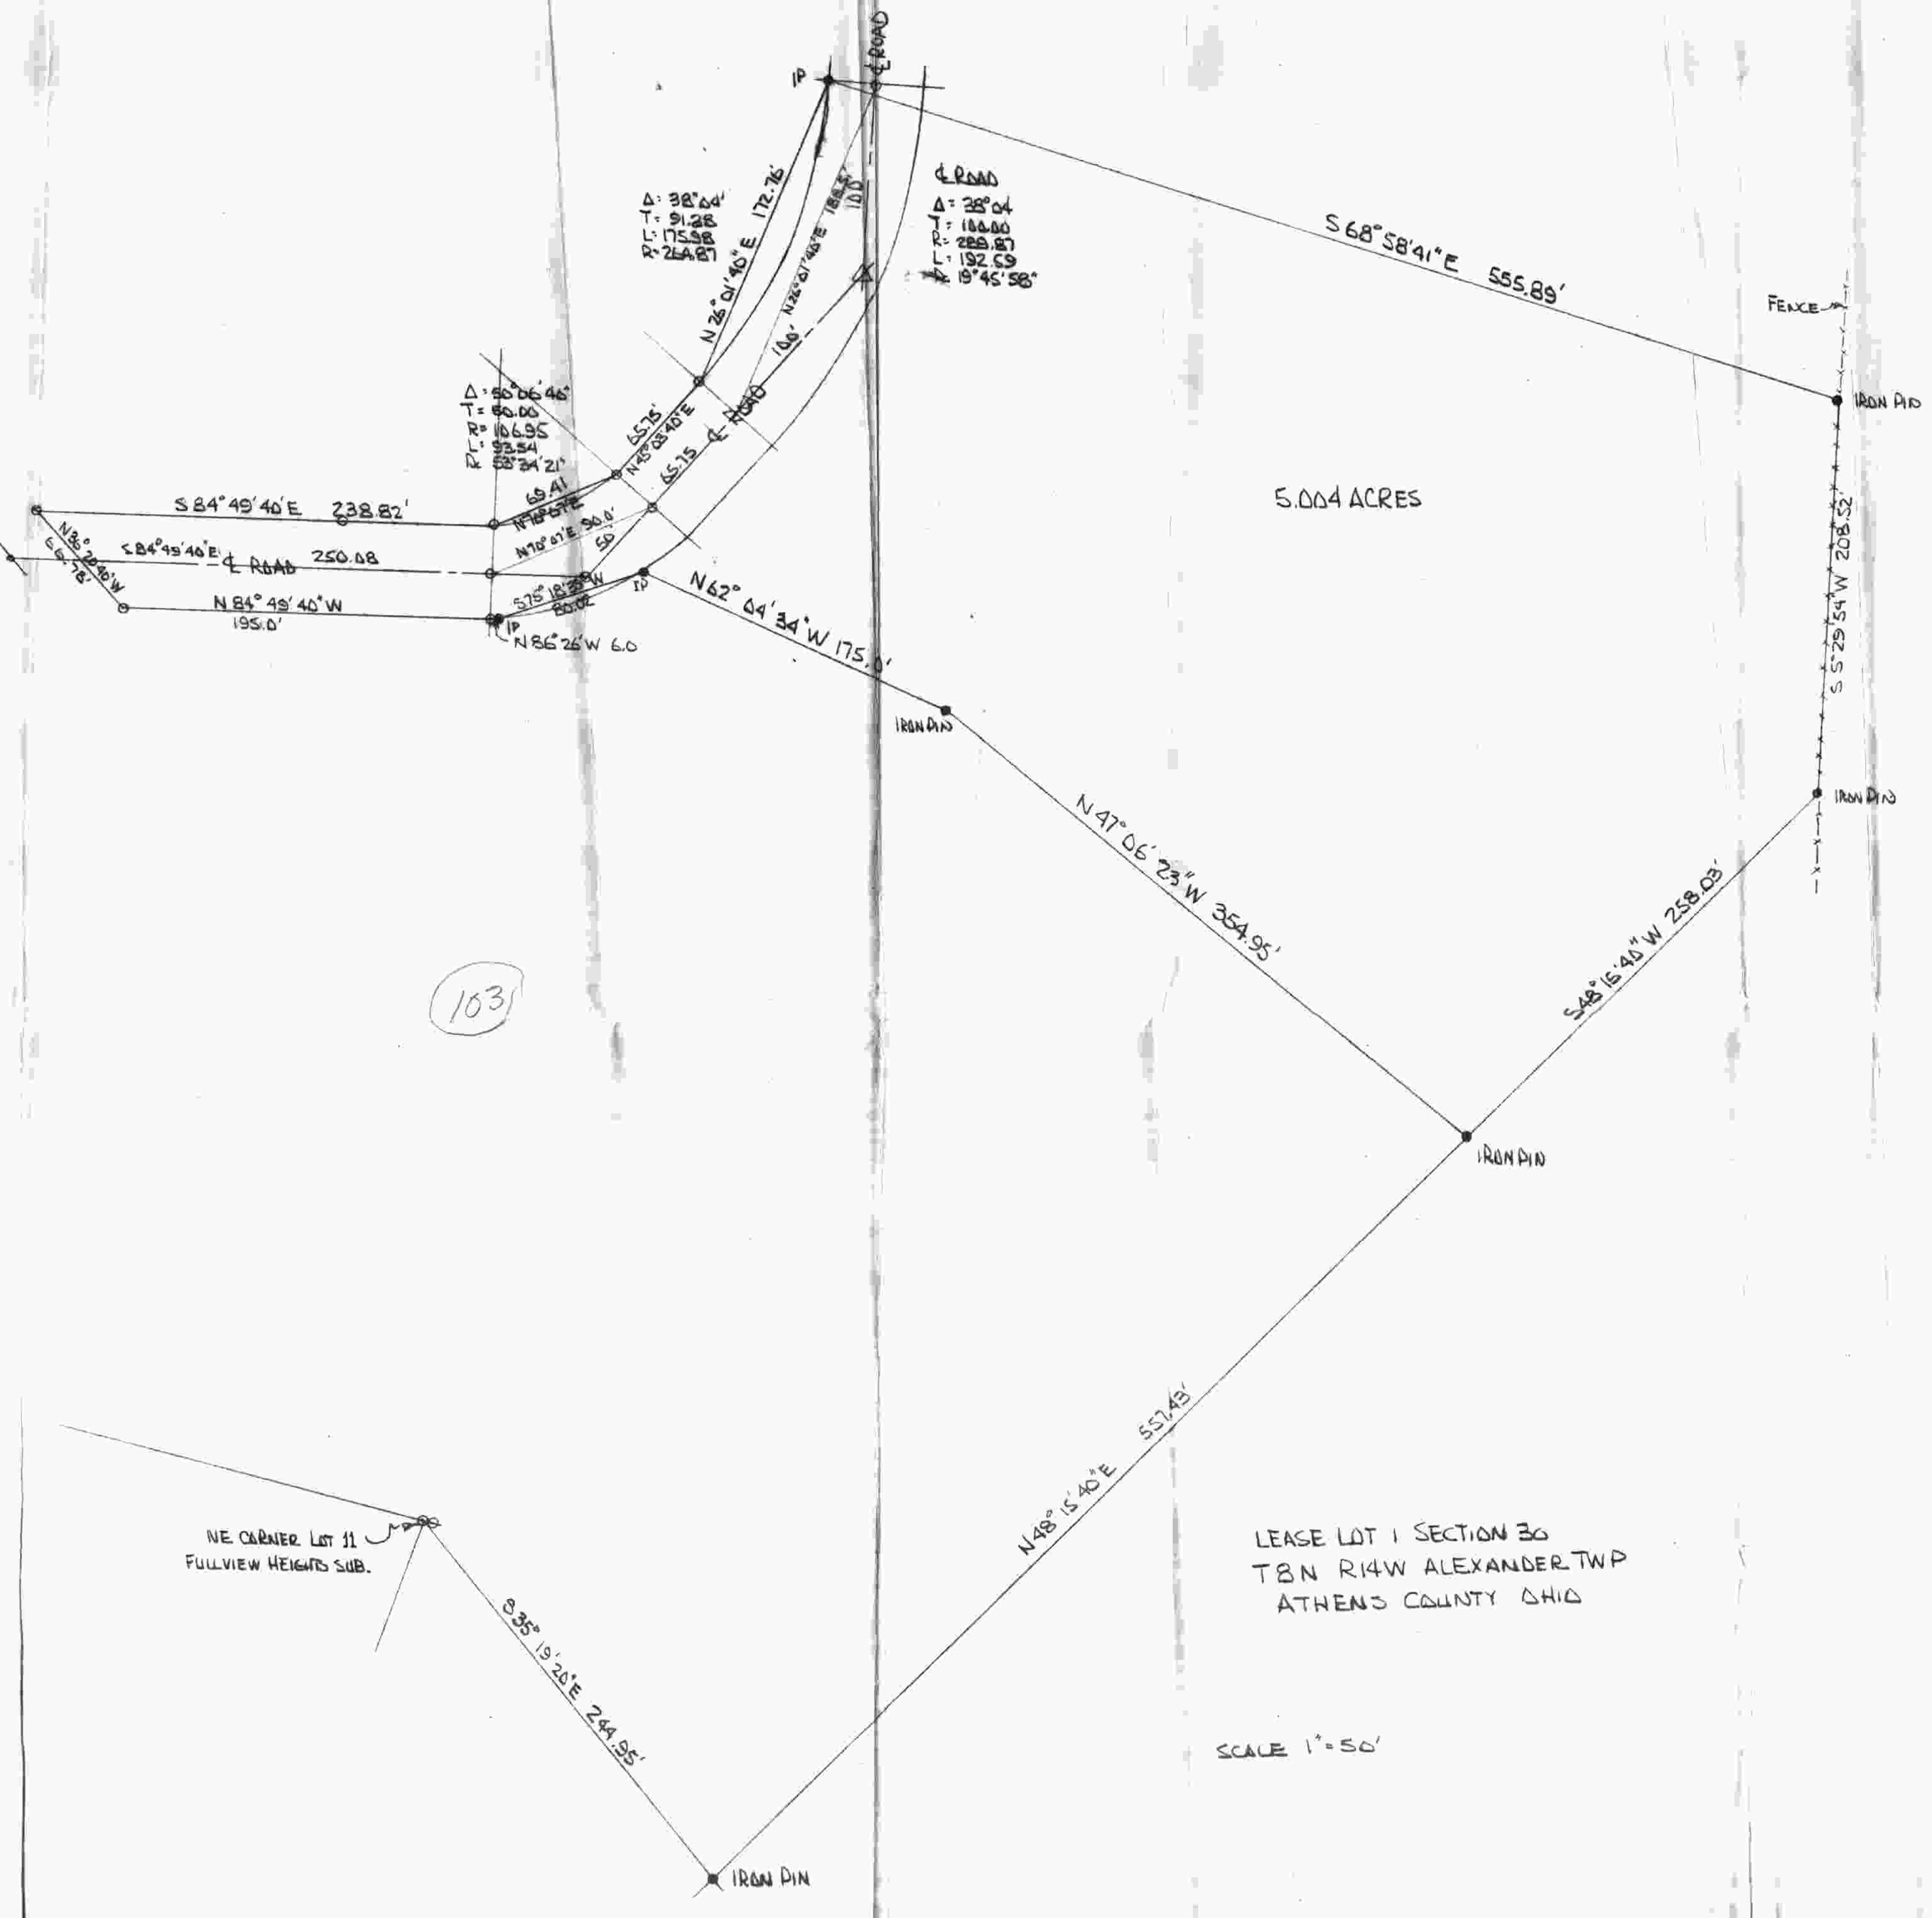

Δ = 98' 28\"/>

Δ = 80' 06\"/>

Δ = 28' 28\"/>

5.004 ACRES

103

105

NE CORNER LOT 11
FULLVIEW HEIGHTS SUB.

LEASE LOT 1 SECTION 30
T8N R14W ALEXANDER TWP
ATHENS COUNTY OHIO

SCALE 1" = 50'

104

106

Williams M. Watkins
Registered Surveyor No. 5-5216