DESCRIPTION OF A 101.59 ACRE TRACT

Situated in Sections 32 and 33 of T.6, R.13, Ames Township, Athens County ,Ohio and being more particularly described as follows:

Beginning at an iron pin found at Grantor's North-west corner, said pin bears South 21 degrees 38 minutes 05 seconds East, 4731.83 feet from the North-west corner of Section 33;

Thence, along the South-line of Cooper (569-2094 O.R.)

S 86° 16' 38" E, 3505.89 feet to an iron pin set;

Thence, along the line of Gilcher (429-1046 O.R.)

S 3° 41' 13" W, 610.03 feet to a point in State Route 550, passing an iron pin set at 534.26 feet; Thence, along State Route 550:

S 54° 55' 53" W, 270.52 feet to a point;

S 49° 45' 53" W, 384.93 feet to a point;

S 60° 49' 53" W, 414.43 feet to a point;

S 61° 24' 53" W, 267.30 feet to a point;

S 75° 51' 53" W, 283.14 feet to a point;

S 74° 00' 53" W, 434.94 feet to a point;

S 77° 56' 53" W, 231.00 feet to a point;

S 76° 44' 57" W, 342.02 feet to a point;

Thence, leaving said road and along new lines created by this survey:

N 10° 23' 18" W, 775.23 feet to an iron pin set, passing an iron pin set at 45.86 feet;

N 82° 41' 00" W, 1041.82 feet to an iron pin set;

Thence, along Valentour (551-2040.O.R.) & (17-515 O.R.)

N 4° 27′ 27" E, 993.71 feet to the point of beginning and containing 101.59 acres.

Subject to all easements and rights of way of record.

Iron pins set are 5/8 inch by 30 inch long rebar w/ plastic I.D. Cap stamped Branner P.S. 6805

Bearing: Grid North- N.A.D. 83, Ohio South Zone

The above description is based on a field survey completed November 2021 by John M. Branner P.S. 6805

Ja mosa

Legal Description Pre-Approval
APPROVED
All transfers are subject to
Athens County Conveyance Standards

NOV 2 3 2021


Jill Thompson Athens County Auditor Description Checked for

Mather alical Accuracy

Towners, left O

JOHN M.
BRANNER
S-6805

PEG/STERED
SS/ONAL SURVEY.

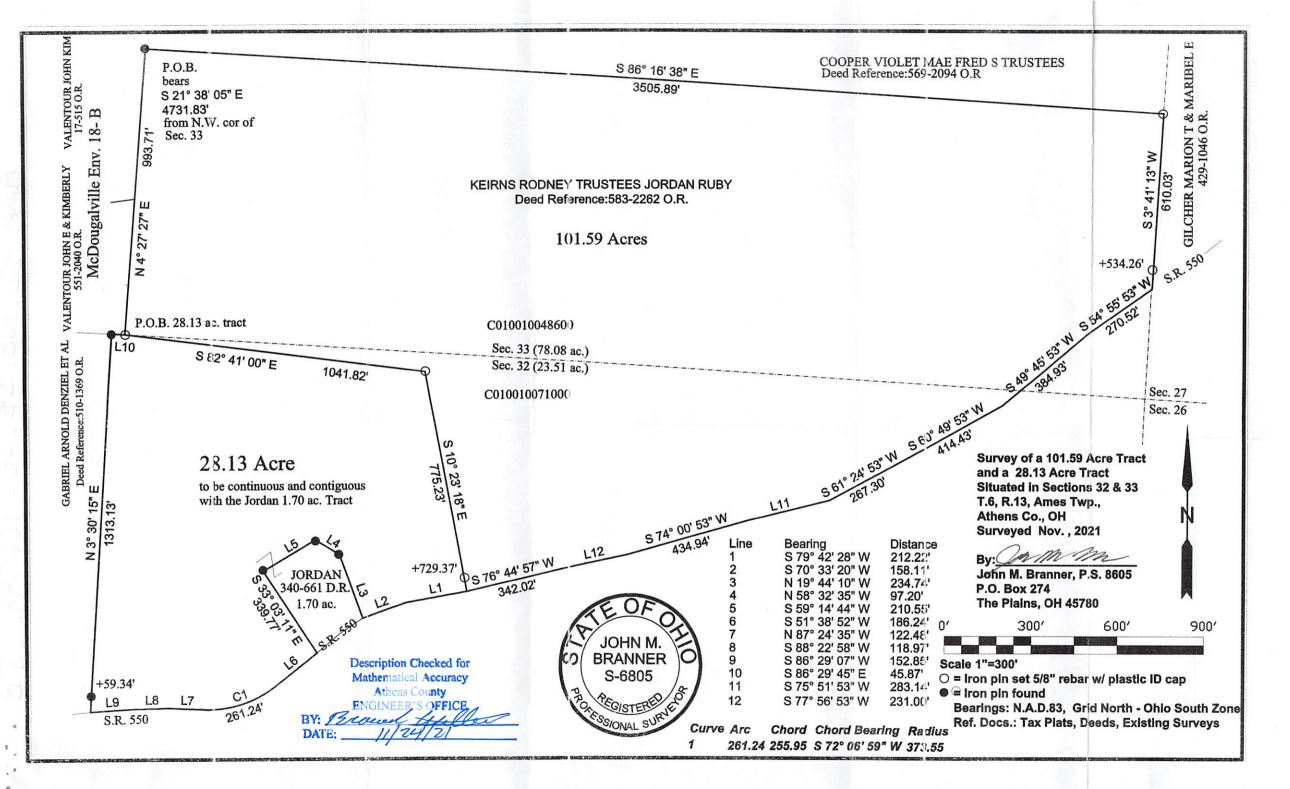

KEIR) Deed I