



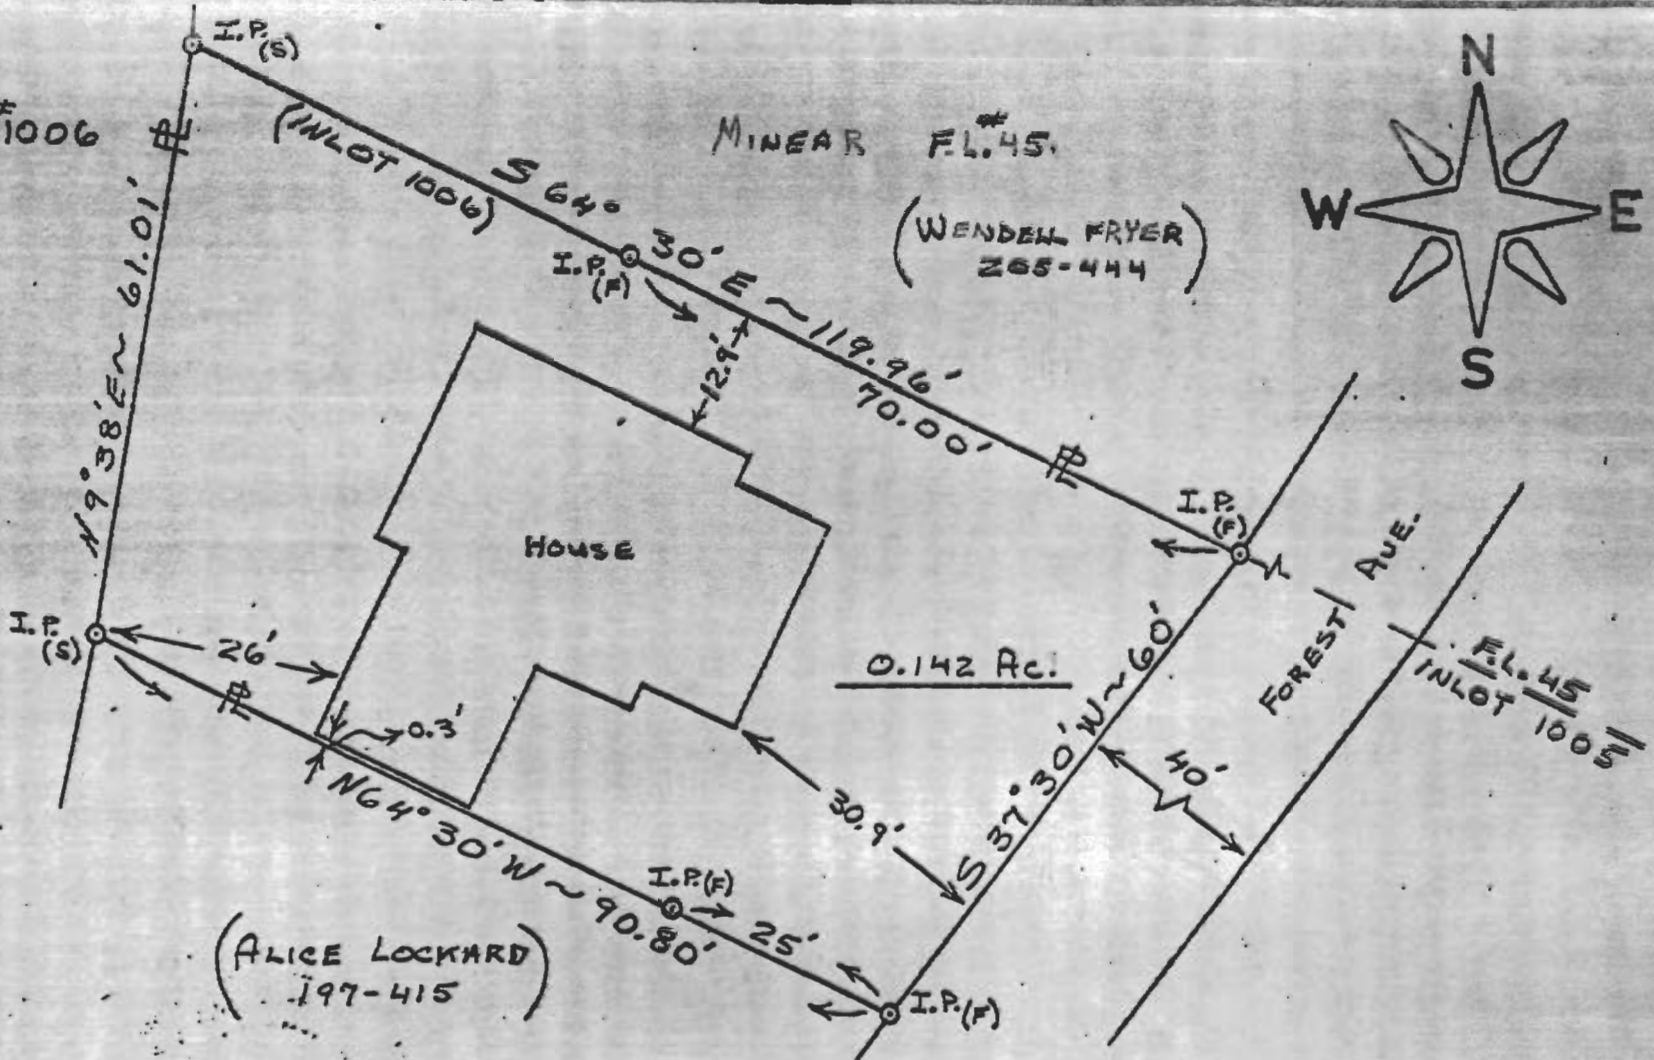

INLOT #1006

MINEAR FL.#45

(WENDELL FRYER  
265-444)

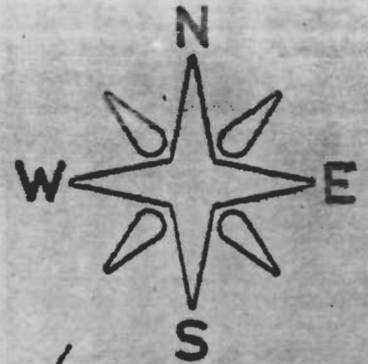

(ALICE LOCKARD  
197-415)



103

RANGE 14, TOWN 9, CITY OF ATHENS, INLOT #1006,

GROSVENOR'S ADD., ATHENS TWP., ATHENS CO., OHIO

SCALE: 1" = 20'

APPROVED BY B.D.M.

DRAWN BY B.D.M.

DATE: 5-6-83

SURVEY OF 0.142 ACRES FOR  
CANADAY REALTY, (EXISTING DEEDS 372-103)

McPHERSON SURVEYING &  
ENGINEERING 614-446-8116

DRAWING NUMBER  
1/1