

DESCRIPTION 5.1001 ACRES

Situated in the Township of Athens, County of Athens, State of Ohio and being a part of Lease Lots 119 and 120 in Section 26, Town 9, Range 14, more particularly described as follows:

Commencing at a stone in the south line of Lease Lot 120 said stone being north $86^{\circ} 05' 06''$ west 390.63 feet from the southeast corner of Lease Lot 120; thence north $3^{\circ} 54' 54''$ east 1147.14 feet to an iron pin, said iron pin being the place of beginning for the tract of land herein described; thence continuing north $3^{\circ} 54' 54''$ east 410.00 feet to an iron pin; thence south $86^{\circ} 05' 06''$ east 390.63 feet to an iron pin; thence north $86^{\circ} 22' 00''$ east 83.20 feet to an iron pin at the northwest corner of Lot No. 7 of the Gilham Subdivision, said iron pin being south $86^{\circ} 22' 00''$ west 57.00 feet from an iron pin in the north line of said Lot 7; thence with the westerly line of the Gilham Subdivision south $13^{\circ} 47' 17''$ east 380.83 feet to an iron pin at the southwest corner of Lot No. 9 in said Subdivision; thence south $3^{\circ} 54' 54''$ west 58.13 feet to an iron pin; thence north $86^{\circ} 05' 06''$ west 588.91 feet to the place of beginning and containing 5.1001 acres more or less, 1.4234 acres being in Lease Lot 119 and 3.6767 acres being in Lease Lot 120.

Prepared by: Evans, Mechwart, Hambleton & Tilton, Inc.

William M. Watkins

Registered Surveyor #5216


Description checked for
Mathematical Accuracy
ATHENS COUNTY
ENGINEER'S OFFICE

BY: *Brian*


DATE: *July*

ATHENS
#26
SER. 2

49

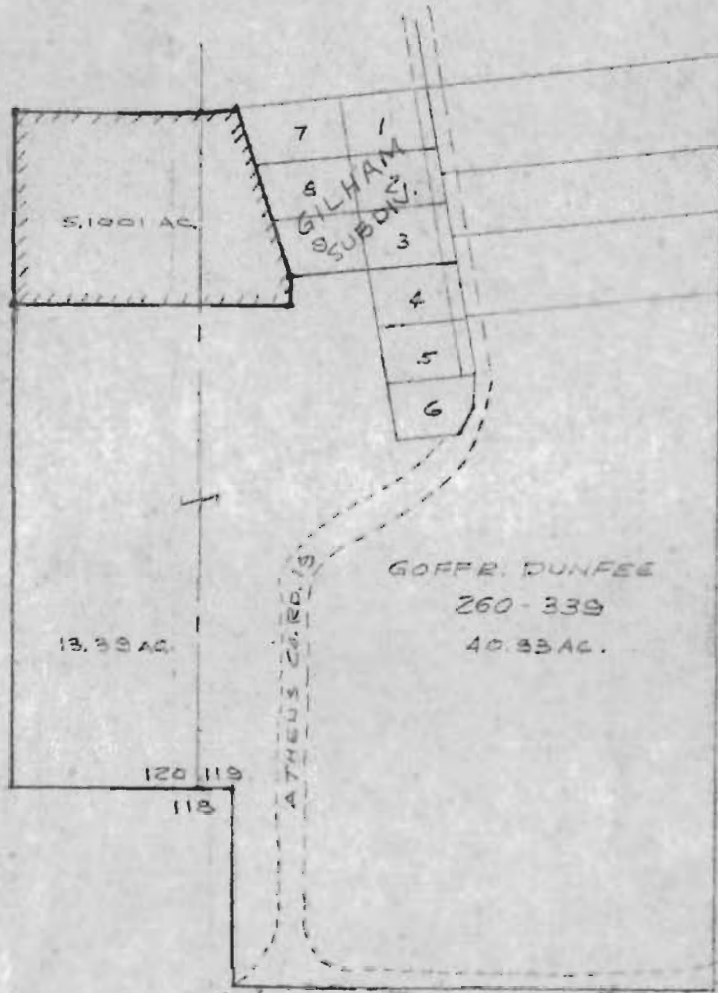

LOCATION MAP

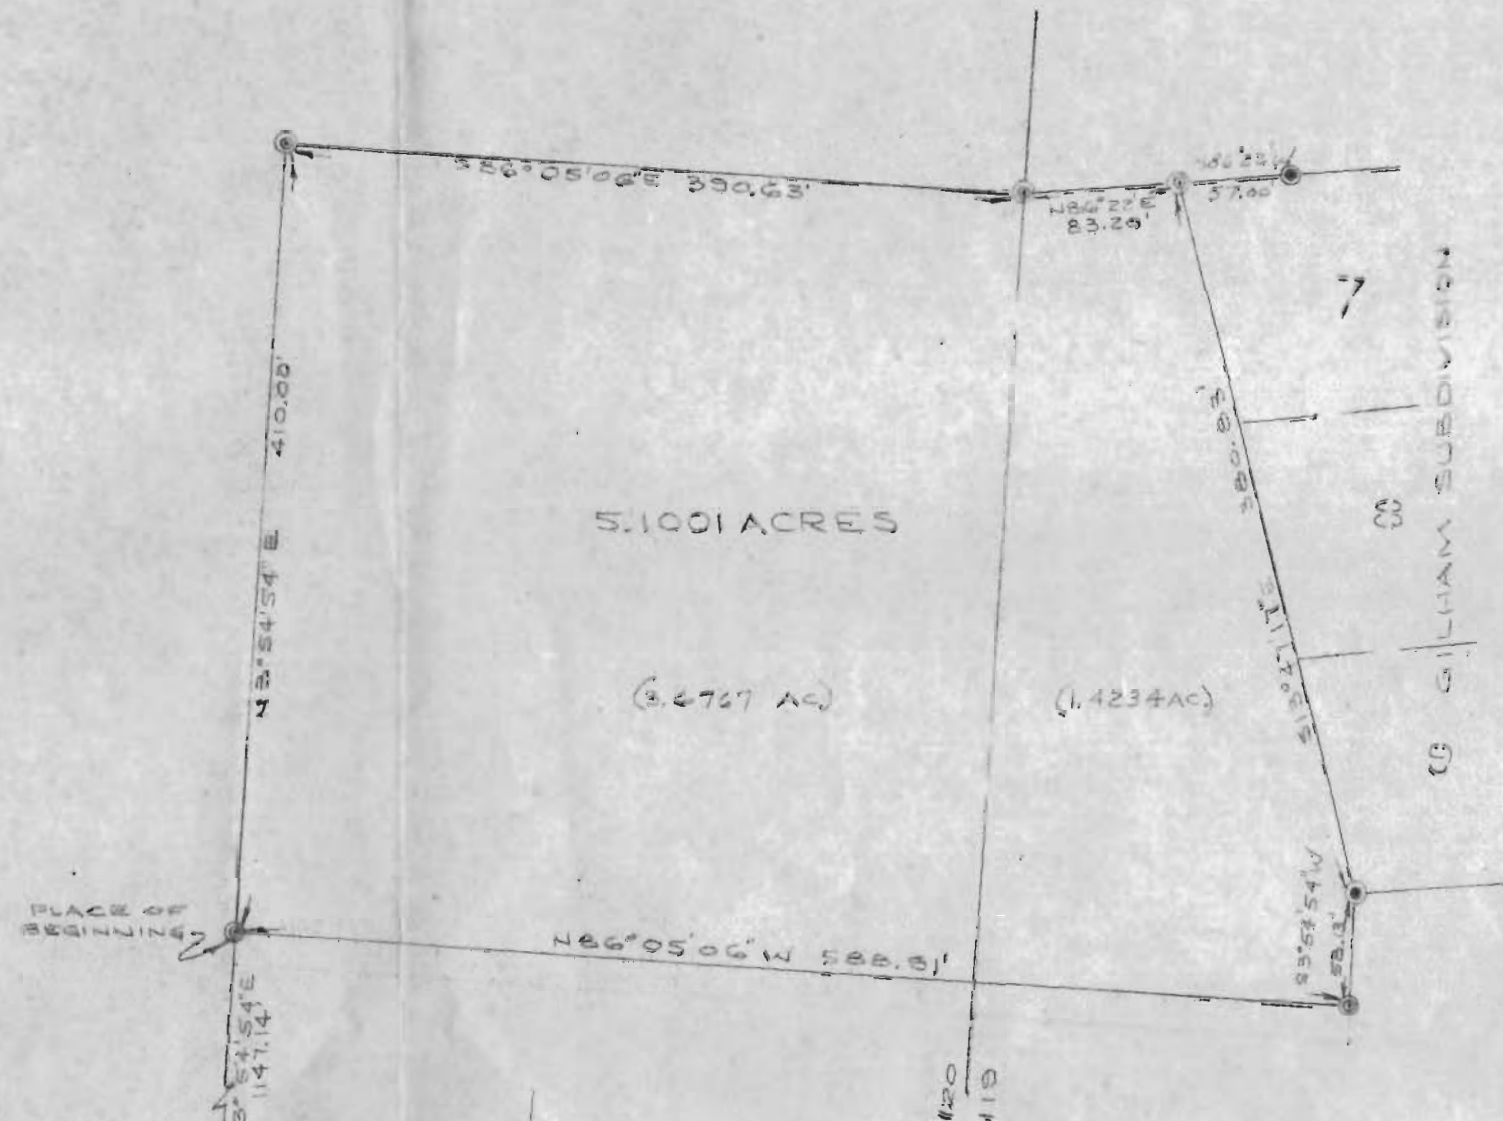

PLAT OF SURVEY

5.1001 ACRES

PART OF LEASE LOTS 119 & 120, SECTION 26, TOWNSHIP, RANGE 14, ATHENS TWP.

ATHENS CO., OHIO

PREPARED BY

EVANS, MECHWART, HAMBLETON & TILTON INC.
CONSULTING ENGINEERS & SURVEYORS

CAHALLA, OHIO

SCALE: 1" = 100'

ATHENS, OHIO

JUL 26 1975

William M. Watkins
REGISTERED SURVEYOR #5219

Description checked for
Mathematical Accuracy
ATHENS COUNTY
ENG. NEER'S OFFICE

BY: *Brian D. Moller*

DATE: *July 25, 1975*

