


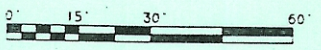

SCALE: 1" = 30'




- IRON PIN SET
- IRON PIN FOUND
- A POINT

PLAT OF RETRACEMENT SURVEY OF:
 LOT 1165 AND 1166 AND
 LOTS 1155 TO 1158 (INCLUSIVE) AND
 PART OF LOT 1159 OF THE FAIRFIELD
 ADDITION TO THE CITY OF ATHENS,
 ATHENS COUNTY, OHIO.



PREPARED BY:
 SOUTHEASTERN LAND SURVEYS
 • APRIL 27, 1998 •
 FOR: STATE ELECTRIC
Leonard Swoyer Jr.
 LEONARD SWOYER P.S. 5765

BLICK AVE.

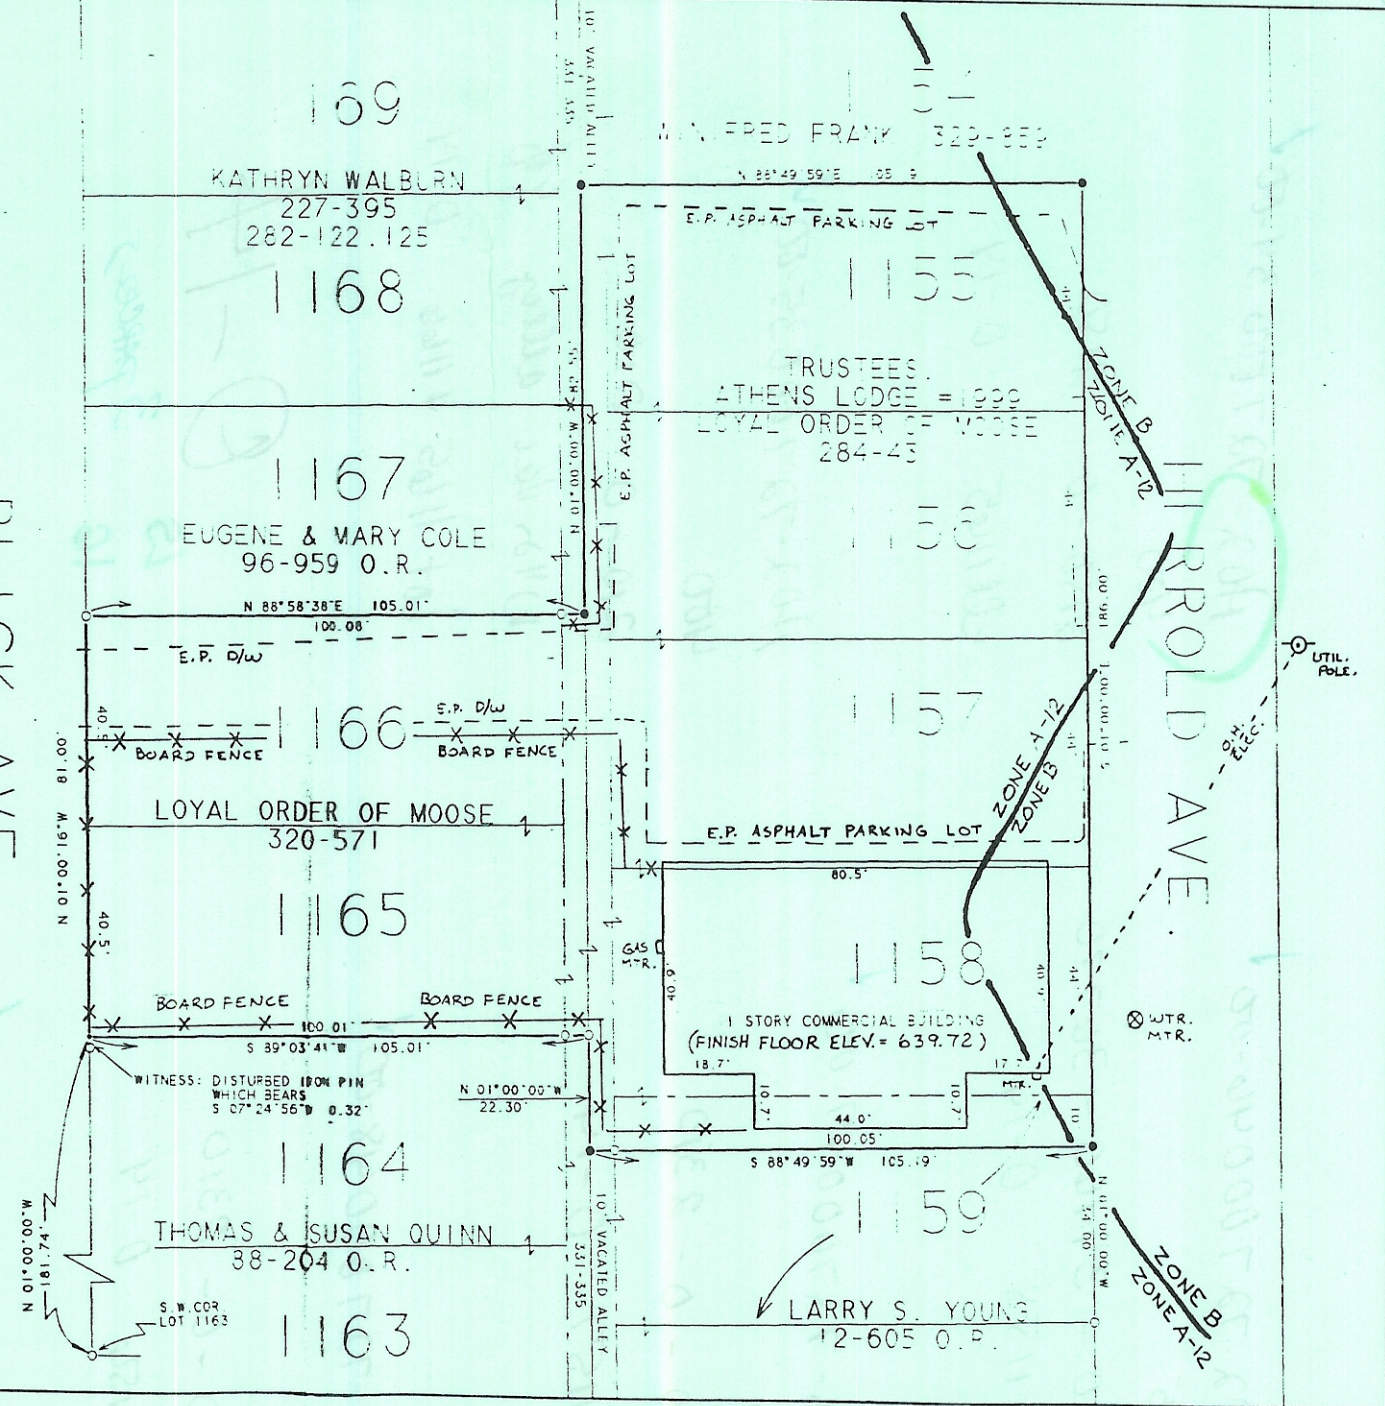

Handwritten notes and stamps on the right side of the page:

- P10 201105
- 02K-0-0218
- 040
- 050
- 060
- 1000