


SOUTHEASTERN LAND SURVEYS

LEONARD F. SWOYER
REGISTERED PROFESSIONAL LAND SURVEYOR

3428 Pleasant Hill Road
Athens, Ohio 45701
614/593-8701

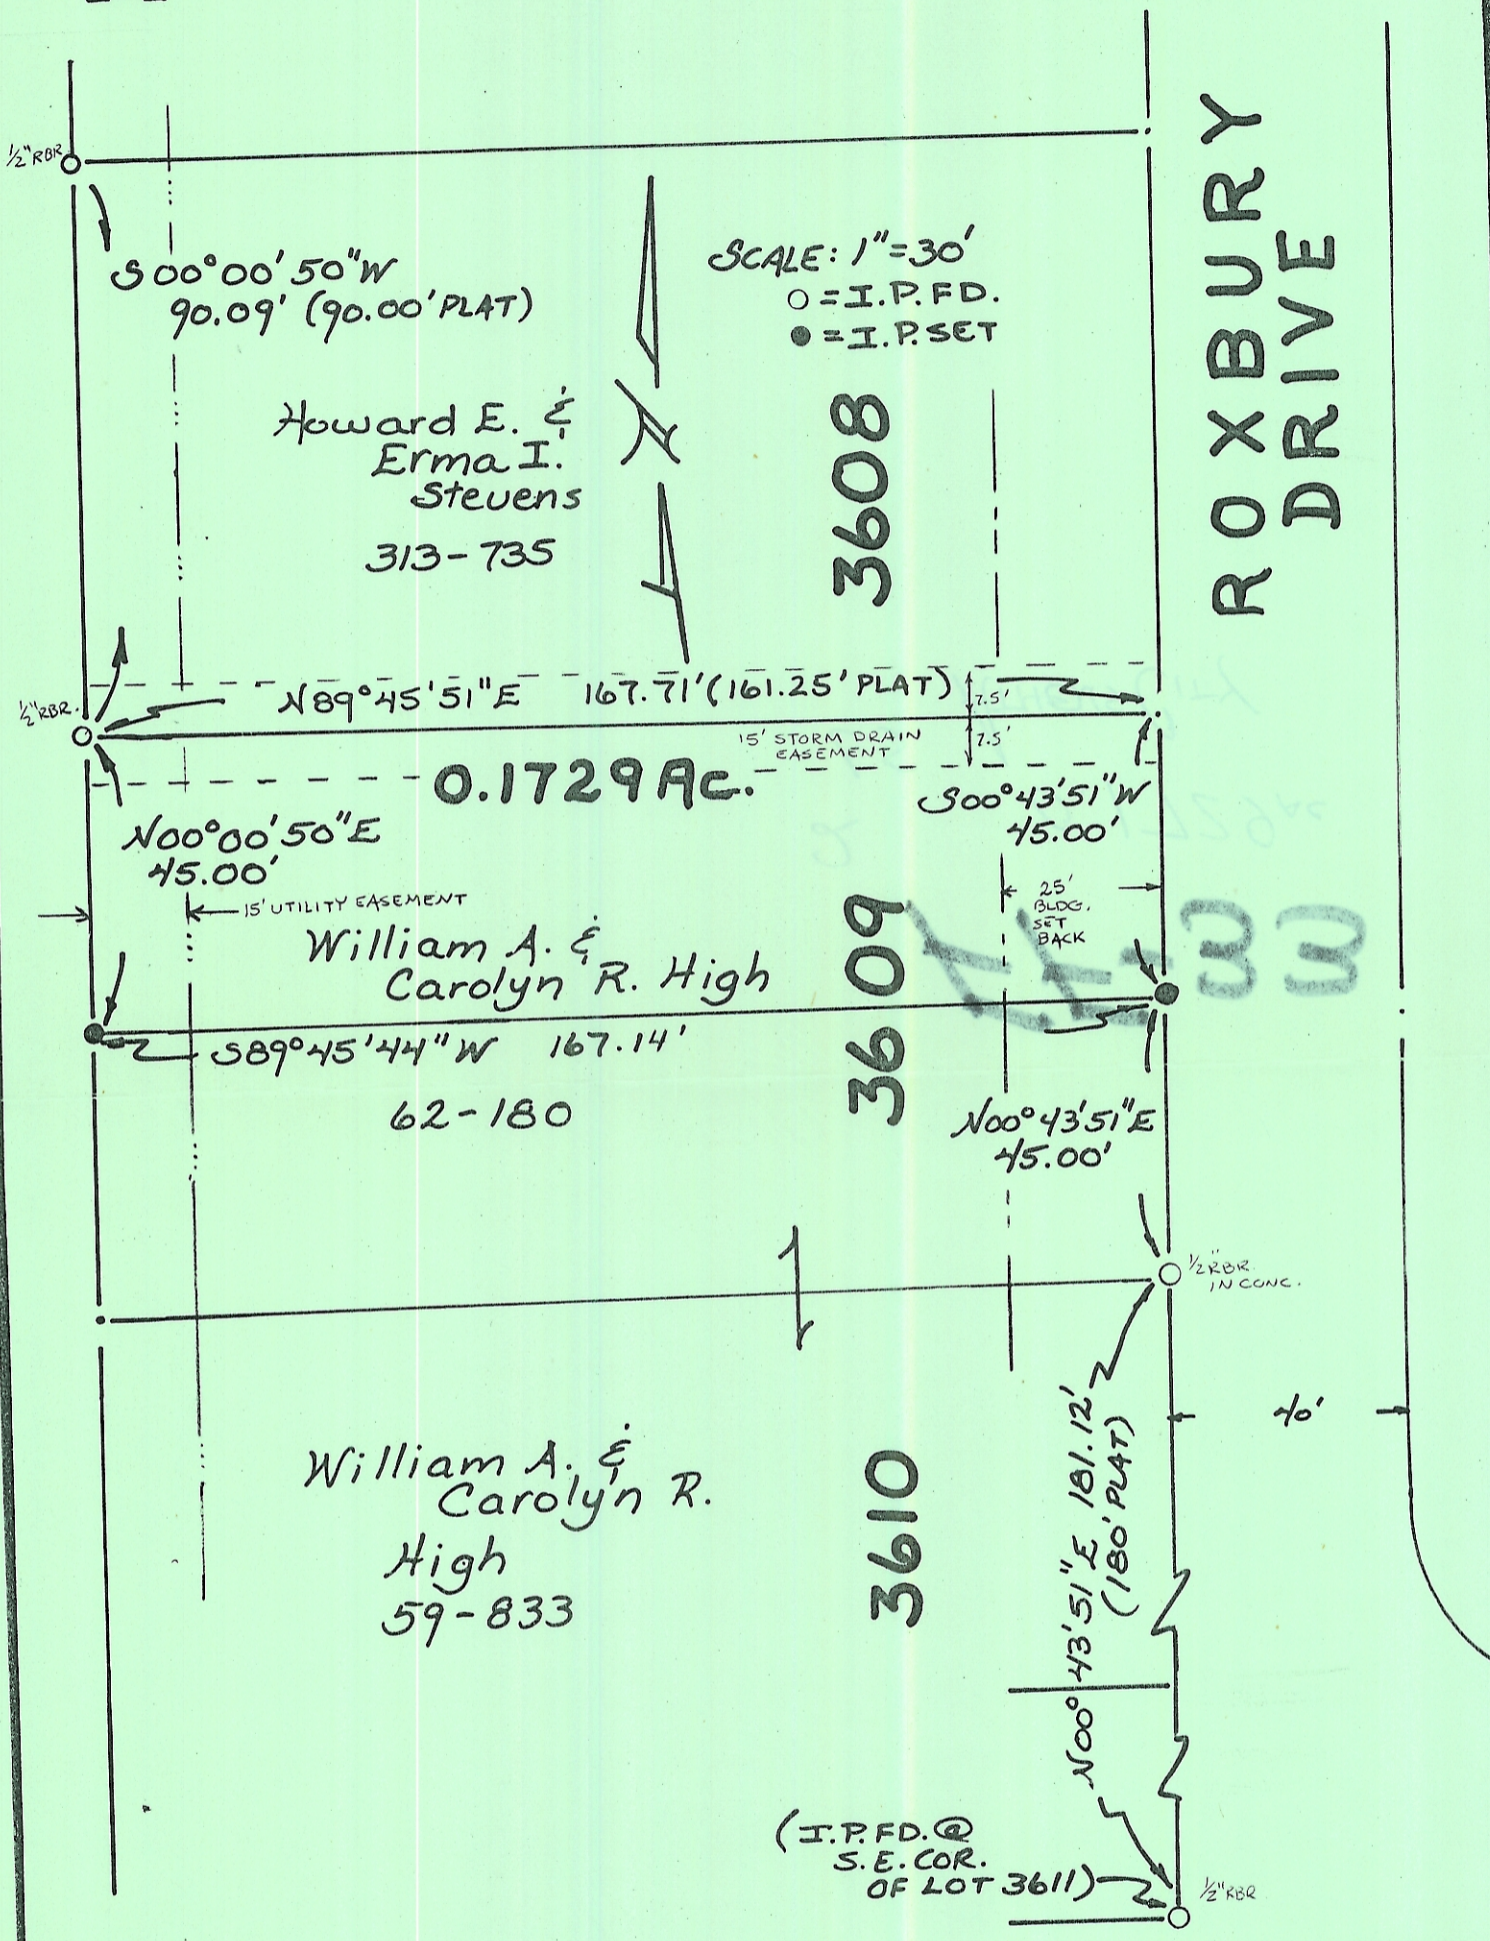

Plat of a 0.1729 Acre Tract Scale 1" = 30'

Surveyed for Mr. Howard Stevens Date 7/25/90

Subdivision Oakmont Subdivision Phase I

Township Athens Section 1 Town 9 Range 14

Corporation Athens City County Athens State Oh.

Leonard F. Swoyer

Leonard F. Swoyer Reg. Prof. Land Surveyor No. 6765