



L31

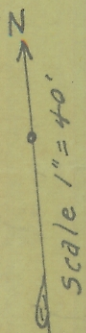

PLAT
 survey of Inlot 779
 Hudson Add. to Athens Ohio

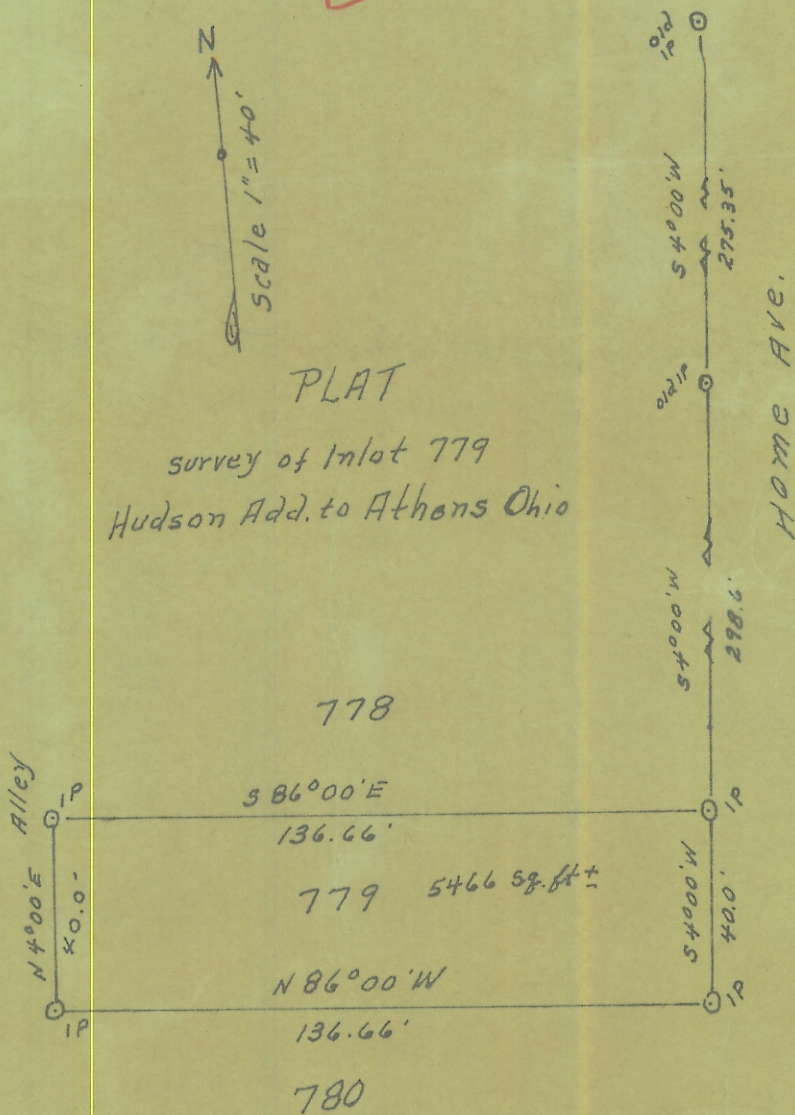

surveyed 7-20-62

by Joe L. Galvin
 Reg. Sur. 1684.

