




# SOUTHEASTERN LAND SURVEYS

LEONARD F. SWOYER  
REGISTERED LAND SURVEYOR

Box 208A  
Route Five  
Athens, Ohio 45701  
614/593-8701

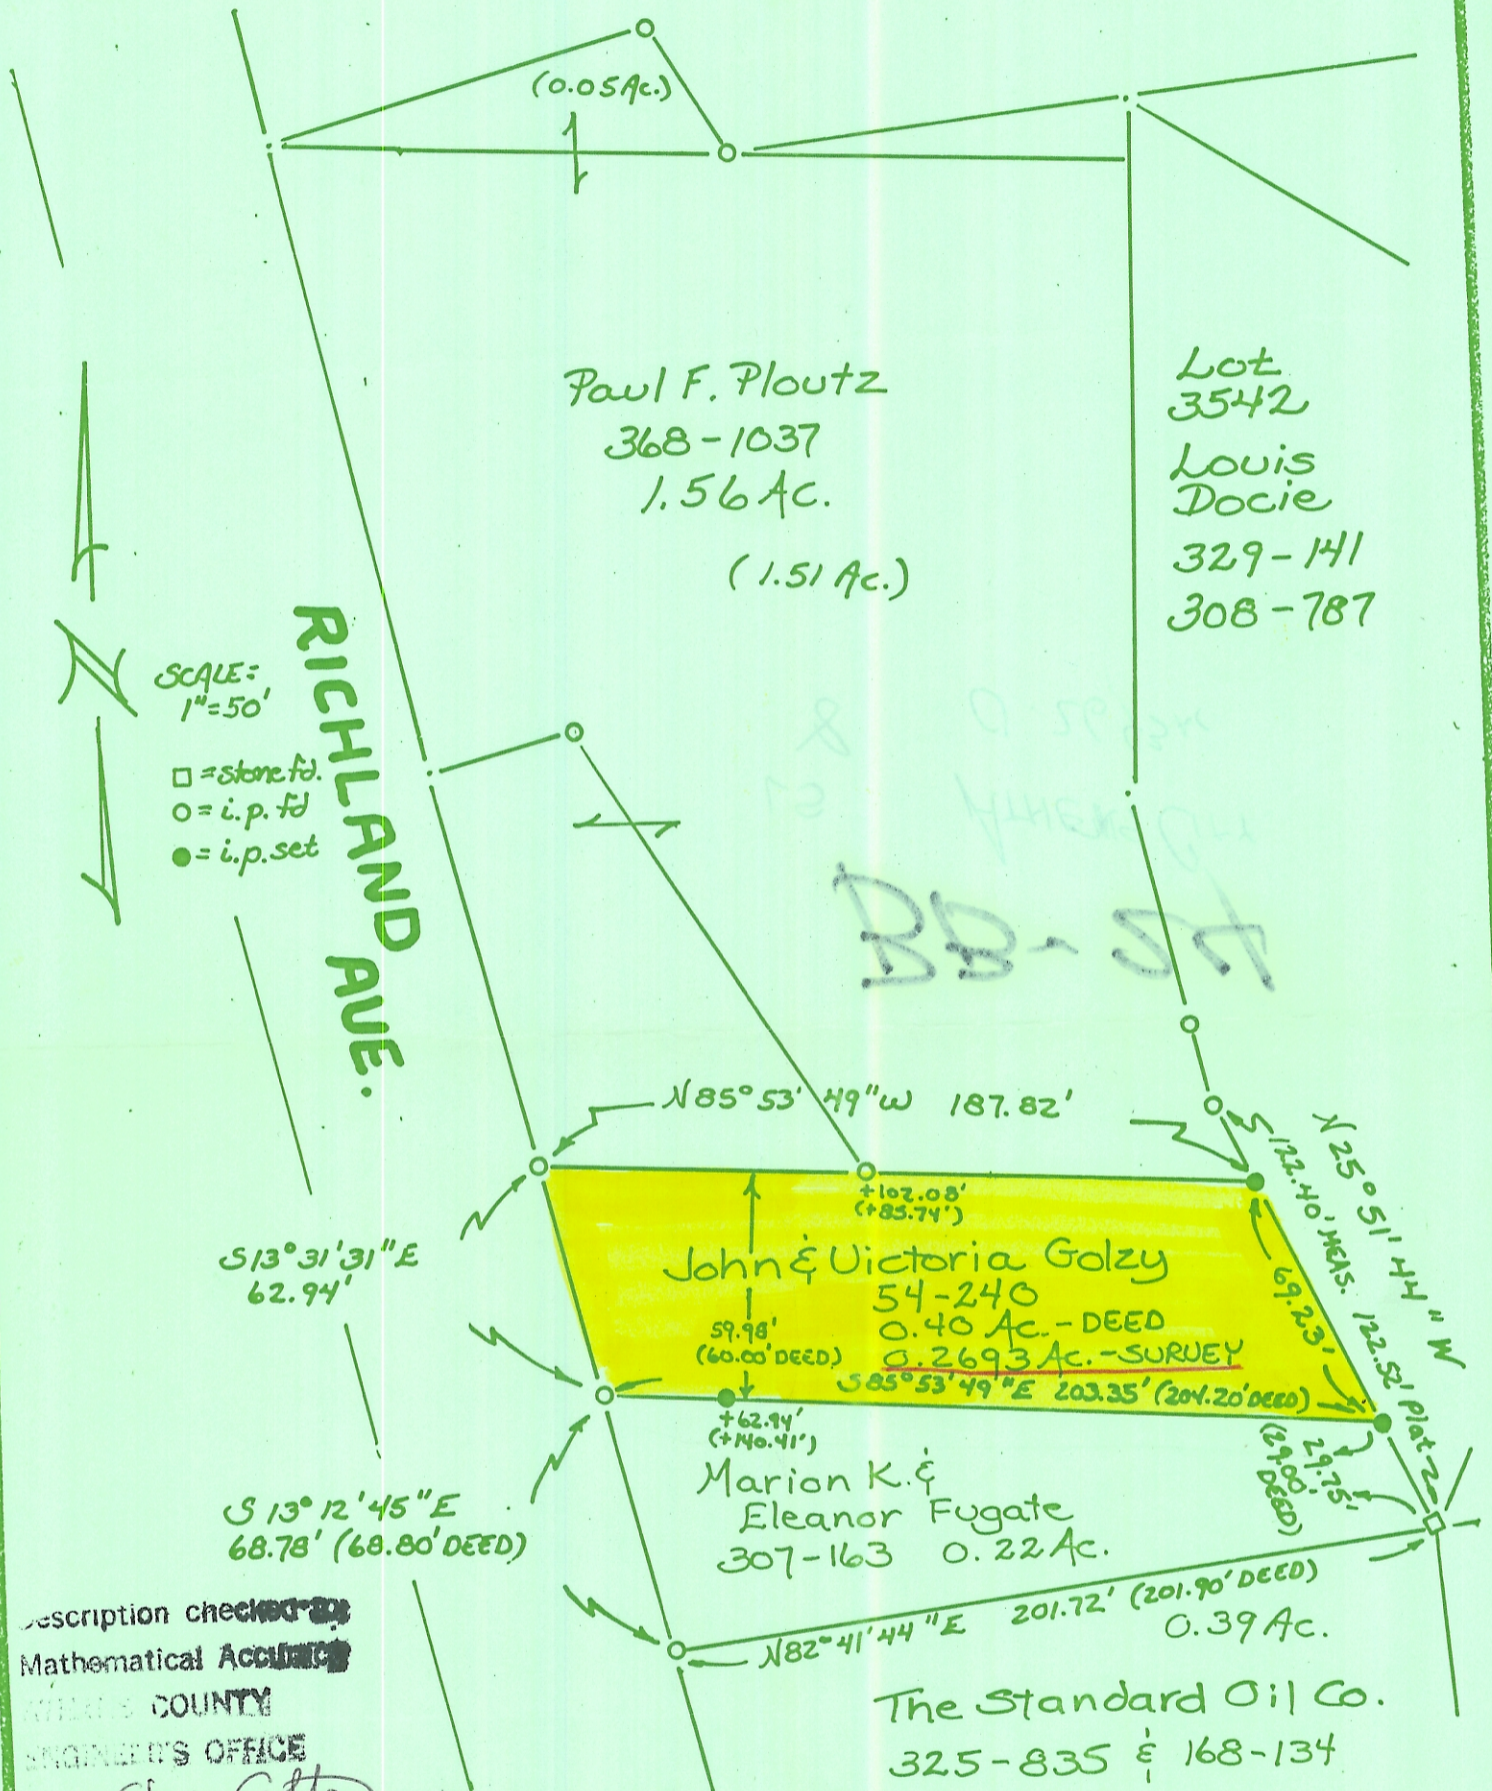

Description checked by  
Mathematical Accuracy  
ATHENS COUNTY  
ENGINEER'S OFFICE  
BY: Chris Cotton  
DATE: 6/8/89

Plat of 0.2693 Acres Scale 1" = 50'

Surveyed for Mr. John Golzy Date 5/3/89

Subdivision F.L.37

Township Athens Section 8 Town 9 Range 14

Corporation City of Athens County Athens State Ohio

Leonard F. Swoyer II

Leonard F. Swoyer II Reg. Prof. Land Surveyor No. 6765