


Gerald W. Dayha, P.S.

Registered Professional
Surveyor No. 5-6139

10916 Pleasanton Road
Athens, OH 45701-9557
740.593.5686 Fax: 740.594.7361
E-mail: jbayha@hughes.net

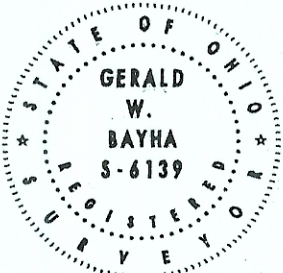

Plat Date:
06.03.08

Job No:
0508-01


By: Chk'd:

Rev:

PLAT OF SURVEY

Being Lots No. 1856, 1858 & 1860
of "Sycamore Hgts. Addn." to the
City of Athens (Env. 199B & 200A),
Sect. 10, T.9.N, R.14.W, Ath. Twp.,
Athens County, Ohio, U.S.A.

EXHIBIT 'B'

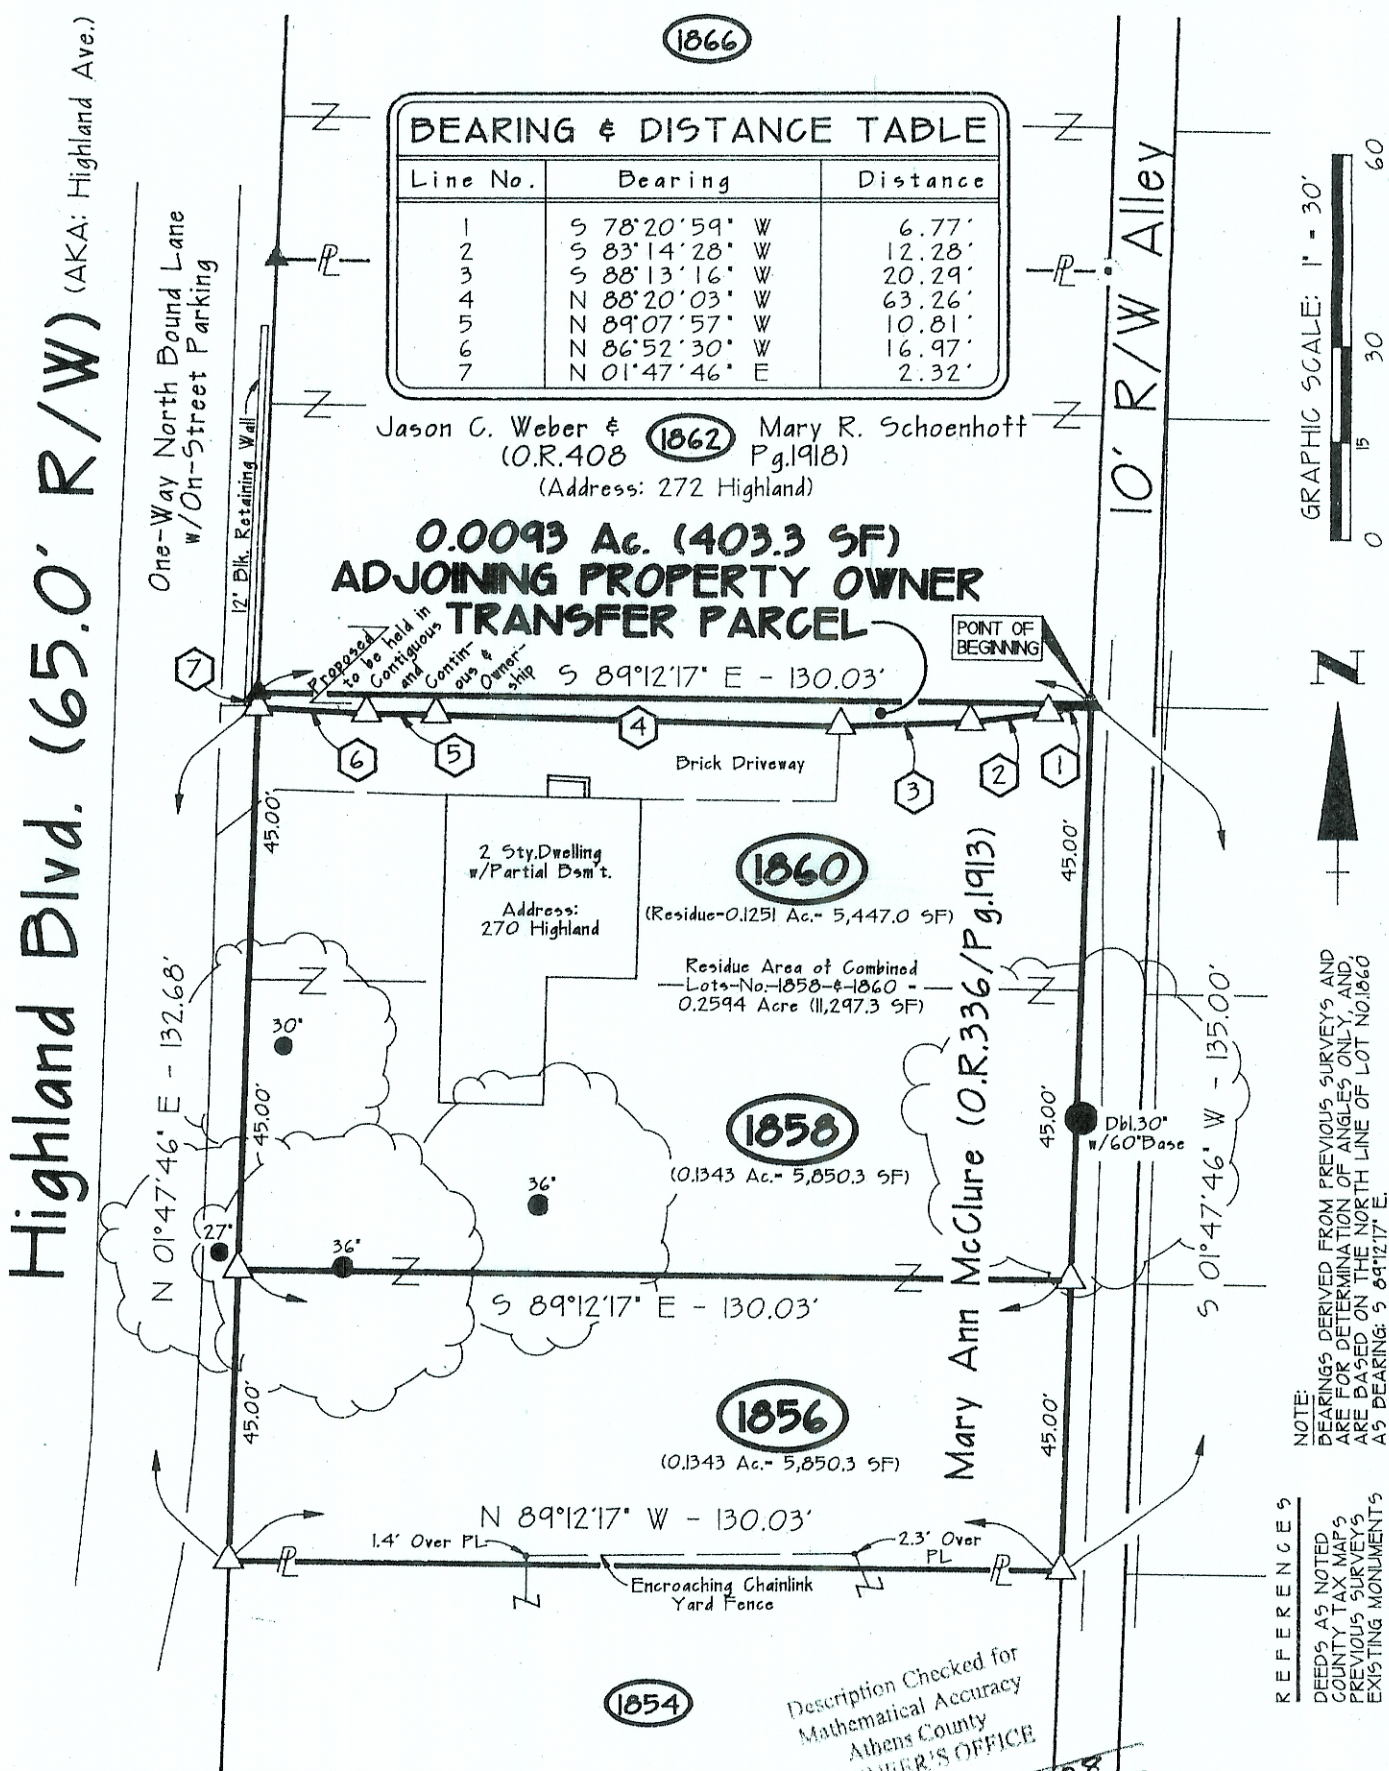

CERTIFICATION OF SURVEYOR:

I hereby certify that this Plat of Survey was prepared from a survey made by me, in May & June, 2008.

By: Gerald W. Dayha, P.S. S-6139
Ohio Registered Professional Surveyor No. 5-6139
Date Signed: 06.03.08

FIELD WORK COMPLETED ON: May 29, 2008

LEGEND	
	5/8" x 30" IRON PIN SET w/I.D. CAP STAMPED "G.W. DAYHA - P.S. 6139"
	3/4" ID x 5' Long Sched. 40 PVC Post Set
	IRON PIN w/CAP FD. MARKED "PS-6805"
	IRON PIPE FD.
	IRON PIN FD.
	DRILL HOLE SET
	POINT