


Sec 1

Sec 1
Athens



PLAT
 of Part of F.L. 2, Section 1, T. 9, R. 14.
 Athens Twp. Athens Co. Ohio.
 Surveyed for James Bolin 9-27-60
 by Joe L. Malvin
 Reg. Sur. 1684.

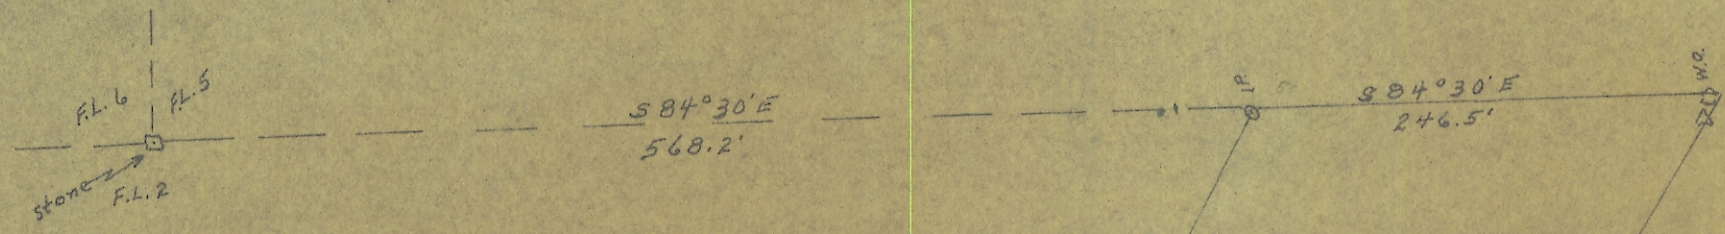