


C. Thomas Smith
Ohio Professional Surveyor
P.O. Box 393
Racine, Ohio 45771
740-949-2524

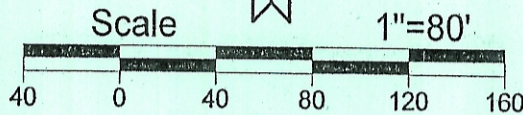

Being a part of Lease Lot 129, Section 27,
Township-9-North, Range-14-West, Athens
Township, Athens County, Ohio.

Note: Bearings are assumed and are for
the determination of angles only.


All iron pins set are 5/8" rebar with
plastic ID cap stamped "CTS-6844"

References
Current tax plats
Previous surveys
Deeds: as noted

Legend

△	Iron pin set
▲	Iron pin found
■	Stone found
○	26" White oak
•	Point

*OK TO TRANSFER
Michael K. Scott, R.S.
3-28-05
ATHENS CITY-COUNTY
HEALTH DEPARTMENT*

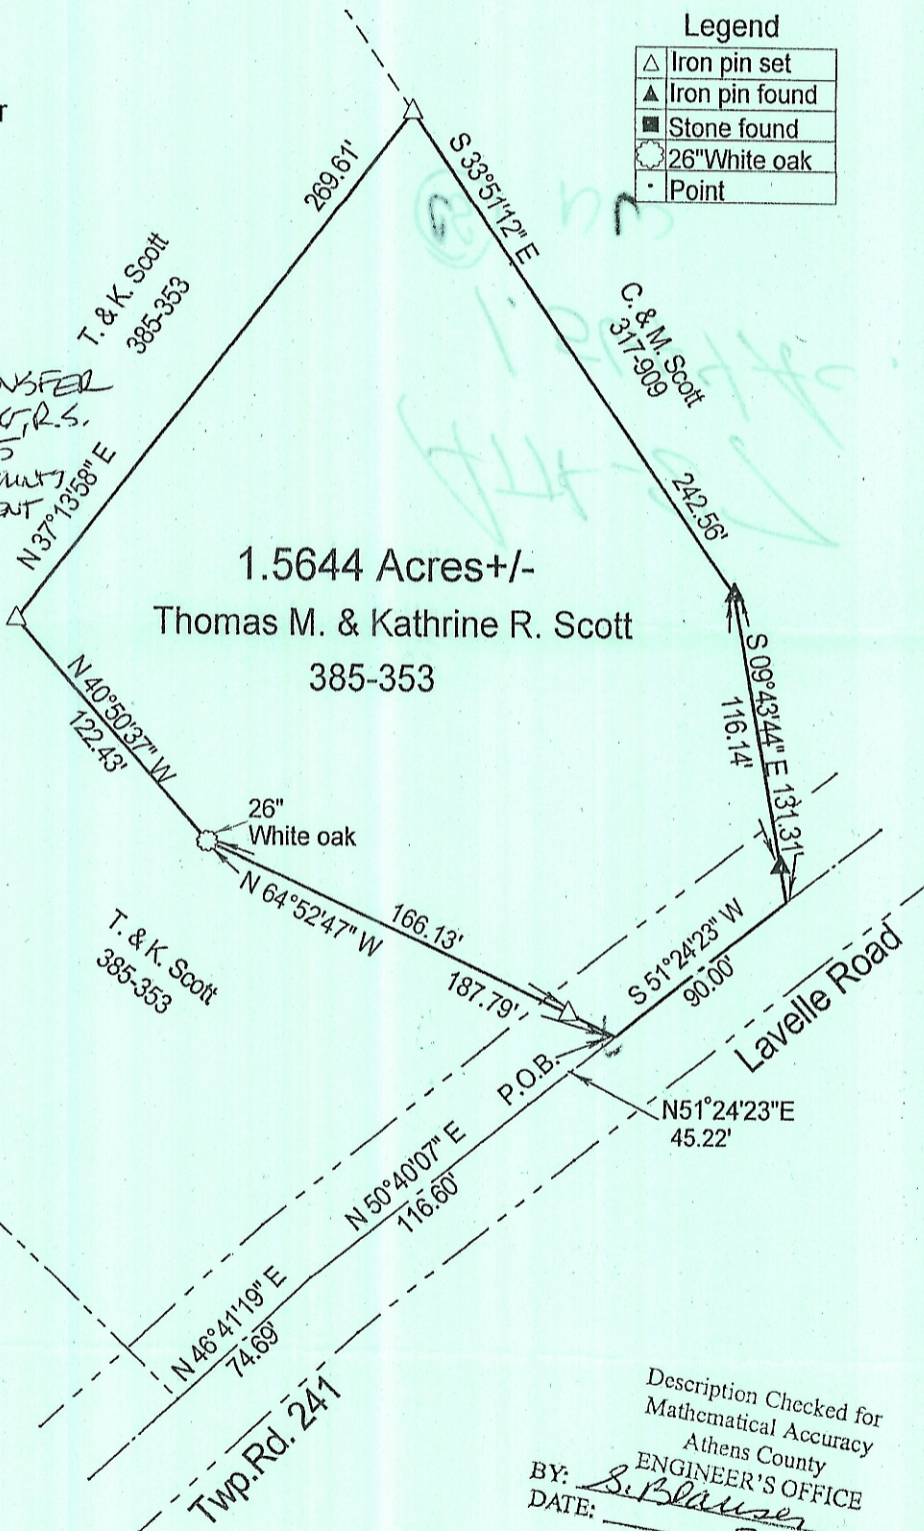

Description Checked for
Mathematical Accuracy
Athens County
ENGINEER'S OFFICE
BY: *S. Blausen*
DATE: *3-22-05*

Plat prepared from an actual survey made on the
18th day of March, 2005 by,

C. T. Smith
Ohio Professional Surveyor

No. 6844