

HAROLD D. WHALEY
23 S. Washington Street
P. O. Box 87
Albany, Ohio 45710

(64-39-3-93)

HAROLD D. ("DALE") WHALEY

REGISTERED SURVEYOR NO. 4986

Albany ATHENS, OHIO 45710

Lots, Farms, Subdivisions and Construction Staking

Ralph C. Frash
3.5605 Acres

Situated in Sec. 11, T. 7 N., E. 12 W., Born Township,
Athens County, Ohio and being more particularly described as
follows:

Beginning at the intersection of U. S. 50 A and C. R. 51,
on the West line of Sec. 11, S. 4° 00' W., 2,580.0 feet from
the Northwest corner of said Section;

Thence along the West line of Section 11, and the center-
line of C. R. 51, N. 4° 00' E. (passing an iron pin at 36.14
feet and an iron pin at 362.49 feet) for a total distance of
583.05 feet to a point;

Thence S. 77° 23' E. (passing an iron pin at 15.88 feet
in the center of the roadway) for a total distance of 249.40
feet to an iron pin;

Thence S. 52° 47' E., 110.92 feet to an iron pin;

Thence S. 9° 29' E., (passing a concrete R/W marker at
184.85 feet and an iron pin at 198.07 feet) for a total distance
of 227.53 feet to a point in the centerline of U. S. 50 A;

Thence along the centerline of U. S. 50 A, S. 60° 06' 35" W.
472.75 feet to the point of beginning, containing 3.5605 Acres
and being subject to all Legal Highway Rights of Way.

Surveyed Aug. 1969 by HAROLD D. WHALEY

Harold D. Whaley
Reg. Surveyor No. 4986

Description checked for
Mathematical Accuracy
ATHENS COUNTY
ENGINEER'S OFFICE


BY: *W. M. Watkins*

DATE: *3/6/79*

Athens Twp., Sec. 11

①

*1st Tr
(59,810.0)*

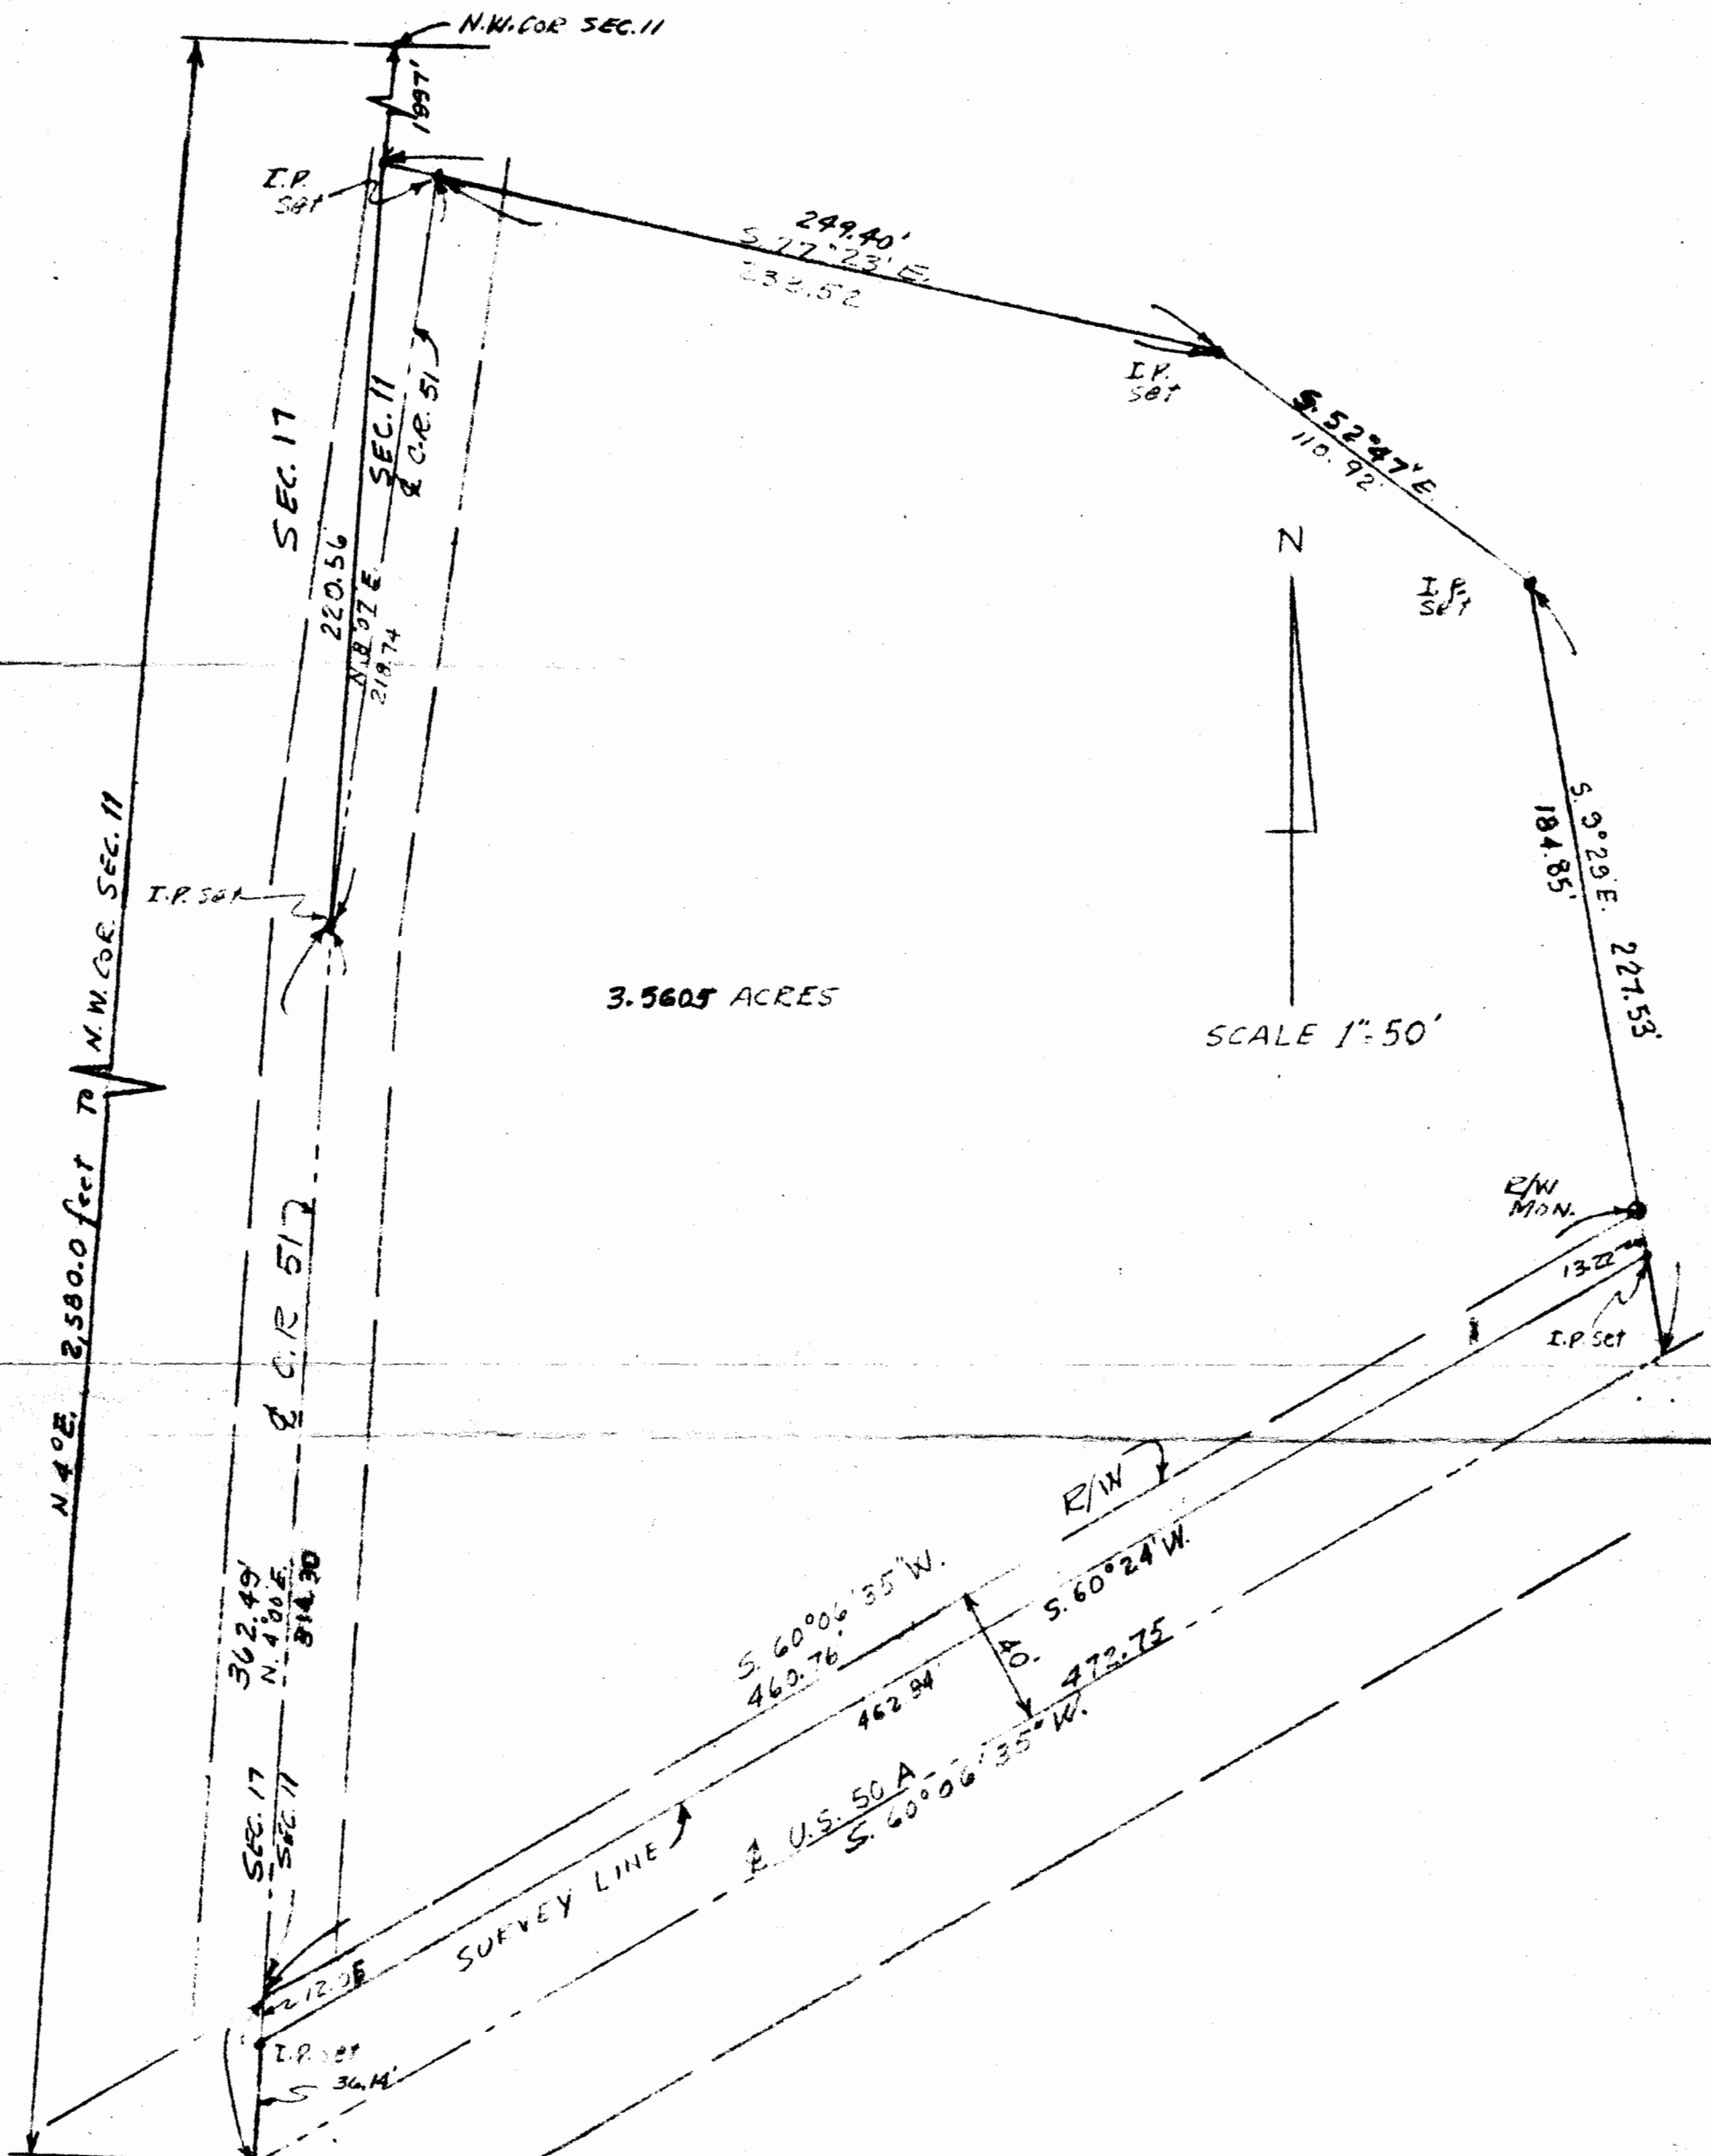

3.5605 ACRES

SCALE 1"=50'

SURVEY OF A 3.5605 ACRES IN SEC. 11, T. 7N, R. 12W
 BERN TOWNSHIP, ATHENS COUNTY, OHIO
 FOR RALPH C. FRASH

SURVEYED AUG. 1969 by HAROLD D. WHALEY
Harold D. Whaley
 REG. SURVEYOR NO. 4986