

## DESCRIPTION FOR DAVID W. BENNETT

Situated in Section 12, Town 7, Range 12, of the Ohio Company's Purchase, Bern Twp., Athens county, Ohio and being more particularly described as follows.

Beginning at an Iron Pin set at a fence corner at the Southwest corner of Section 12; thence North a distance of 328.10 feet along the West line of said Section to an Iron Pin set, thence South 72 deg. 17 min. 40 sec. East a distance of 214.62 feet to the center of Athens county road #51 (Ref.: passing an Iron Pin at a distance of 189.62); thence along the center of C.R.# 51 South 11 deg. 45 min. 26 sec **WEST** a distance of 281.84 feet; thence leaving said road North 84 deg. 54 deg. 30 sec. West a distance of 147.60 feet (Ref.: passing an Iron Pin at a distance of 25 00 feet) to the place of beginning containing 1.244 acres. Surveyed by Raymond Sayers Reg. Surveyor No. S-6301 in May, 1988..

Reference: Being part of a 118.86 acre tract of land owned by Delbert F. Bennett as recorded in Vol. 288 Pg. 547 of the Athens County Deed Records.

Raymond Sayers Reg. Surveyor S-6301  
Rt. 1 Box 188-B  
Chesterhill, Ohio 43728  
Tel. 554-5621

*Raymond D. Sayers*

Description checked for  
Mathematical Accuracy  
ATHENS COUNTY  
ENGINEER'S OFFICE

BY: Bob Endenbeck  
5-18-88

BRN # 12

20


RICHARD L. LEWIS  
270/15

DELBERT F. BENNETT JR

118.86 ACRES

288/547

21

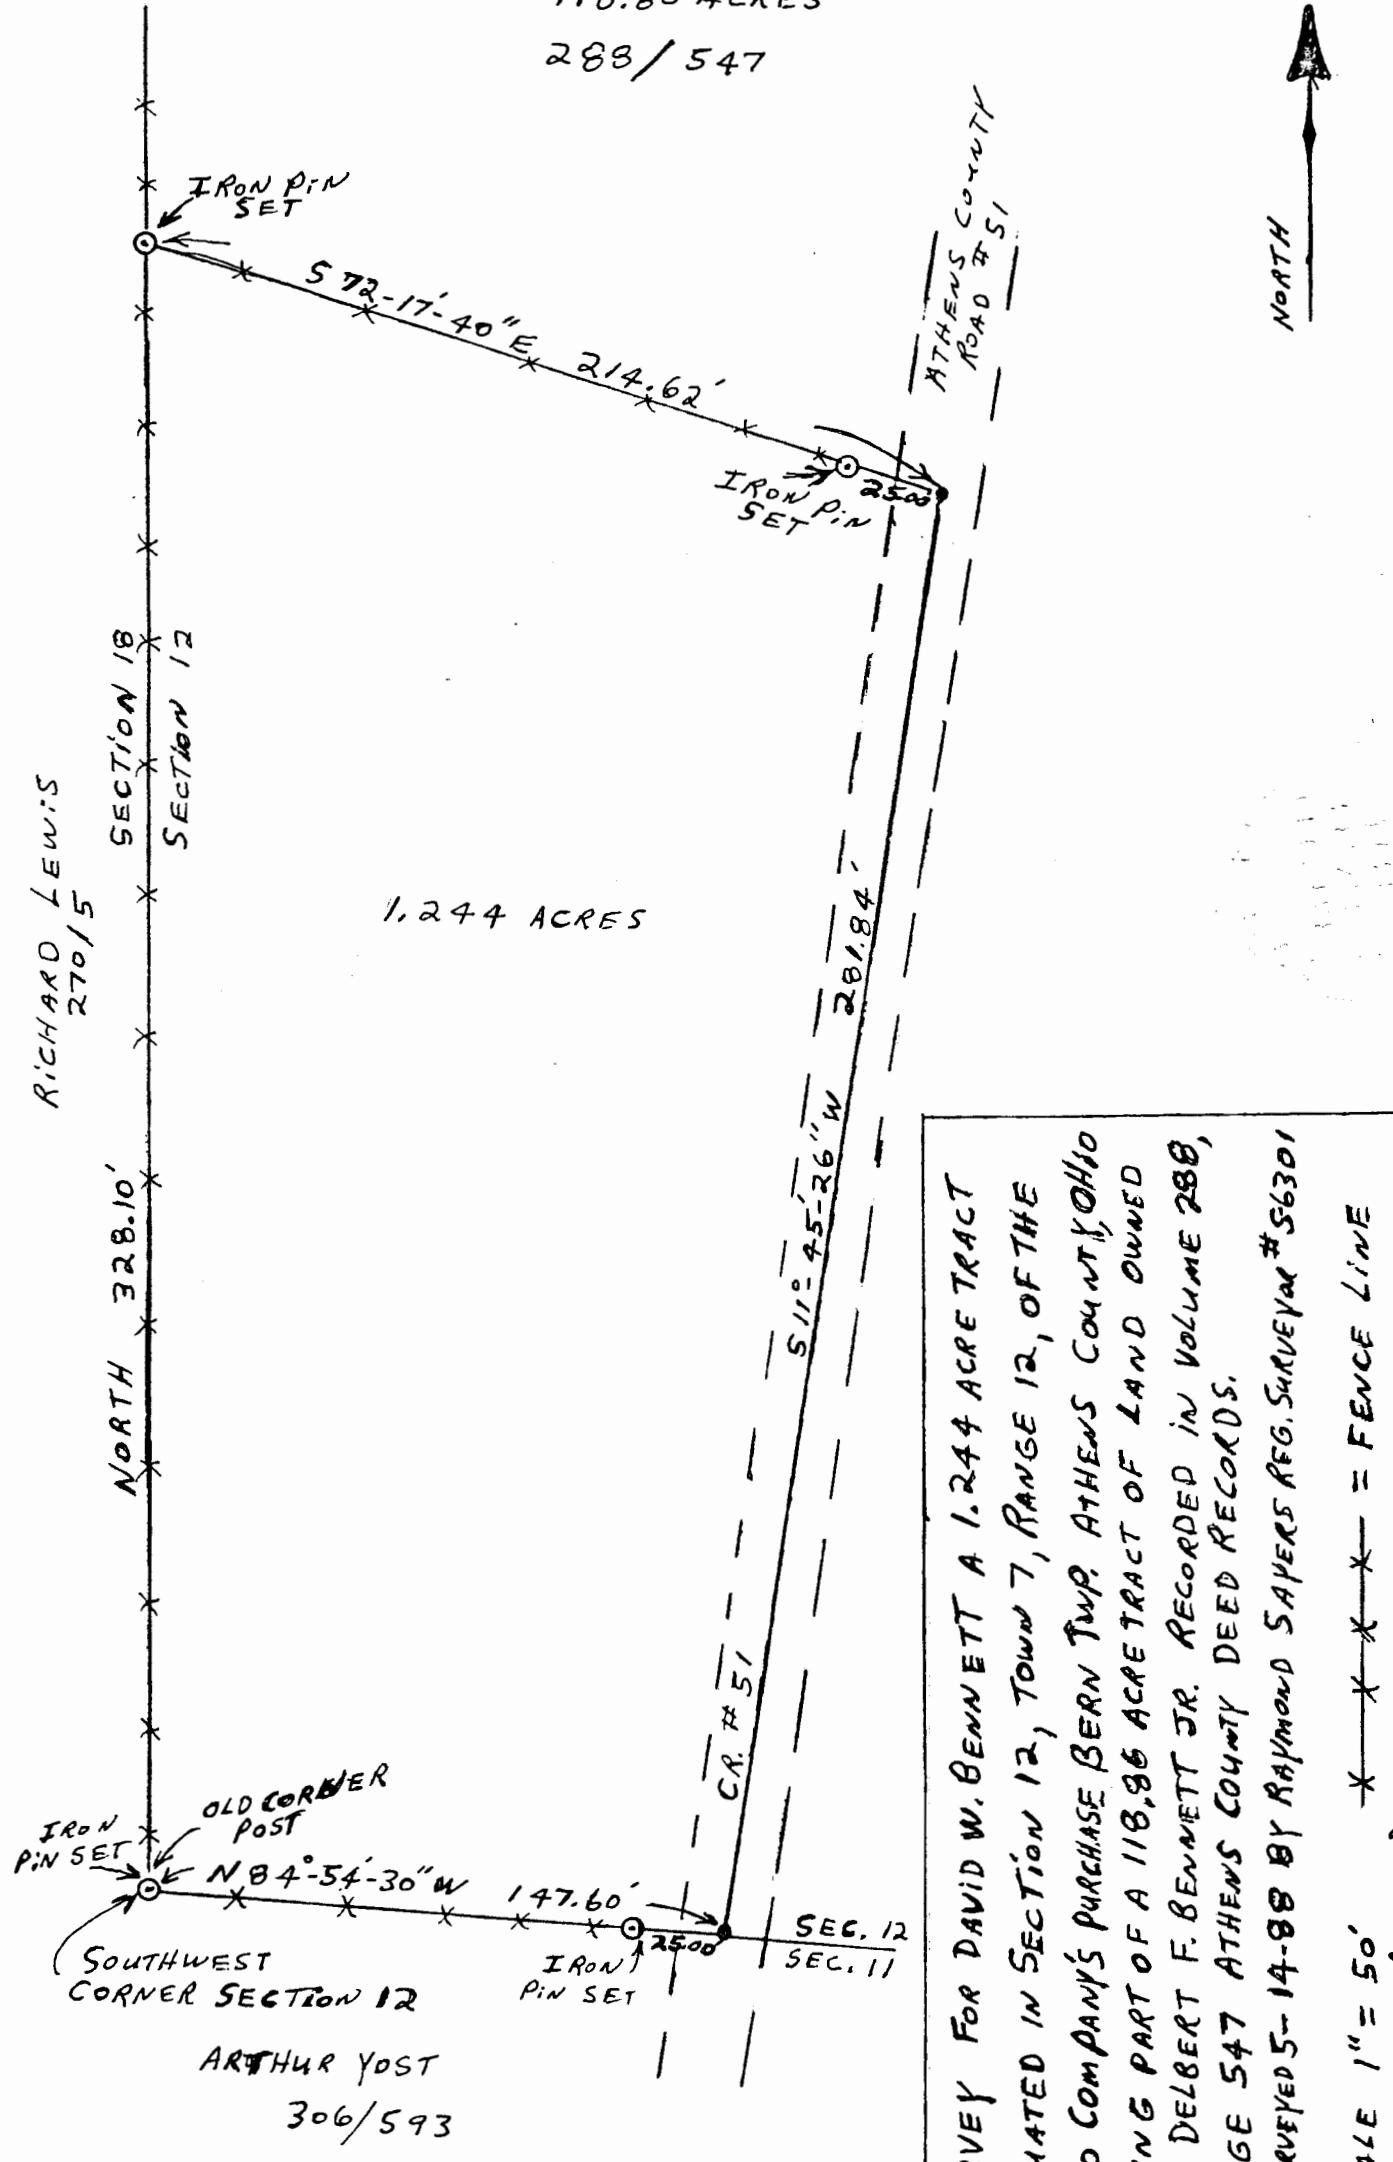

SURVEY FOR DAVID W. BENNETT A 1.244 ACRE TRACT  
SITUATED IN SECTION 12, TOWN 7, RANGE 12, OF THE  
OHIO COMPANY'S PURCHASE BEARN TWP. ATHENS COUNTY, OHIO  
BEING PART OF A 118.86 ACRE TRACT OF LAND OWNED  
BY DELBERT F. BENNETT JR. RECORDED IN VOLUME 288,  
PAGE 547 ATHENS COUNTY DEED RECORDS.  
SURVEYED 5-14-88 BY RAYMOND SAWERS REG. SURVEYOR #56301

Raymond D. Sowers