






# SOUTHEASTERN LAND SURVEYS

LEONARD F. SWOYER  
REGISTERED PROFESSIONAL LAND SURVEYOR

3428 Pleasant Hill Road  
Athens, Ohio 45701  
614/593-8701

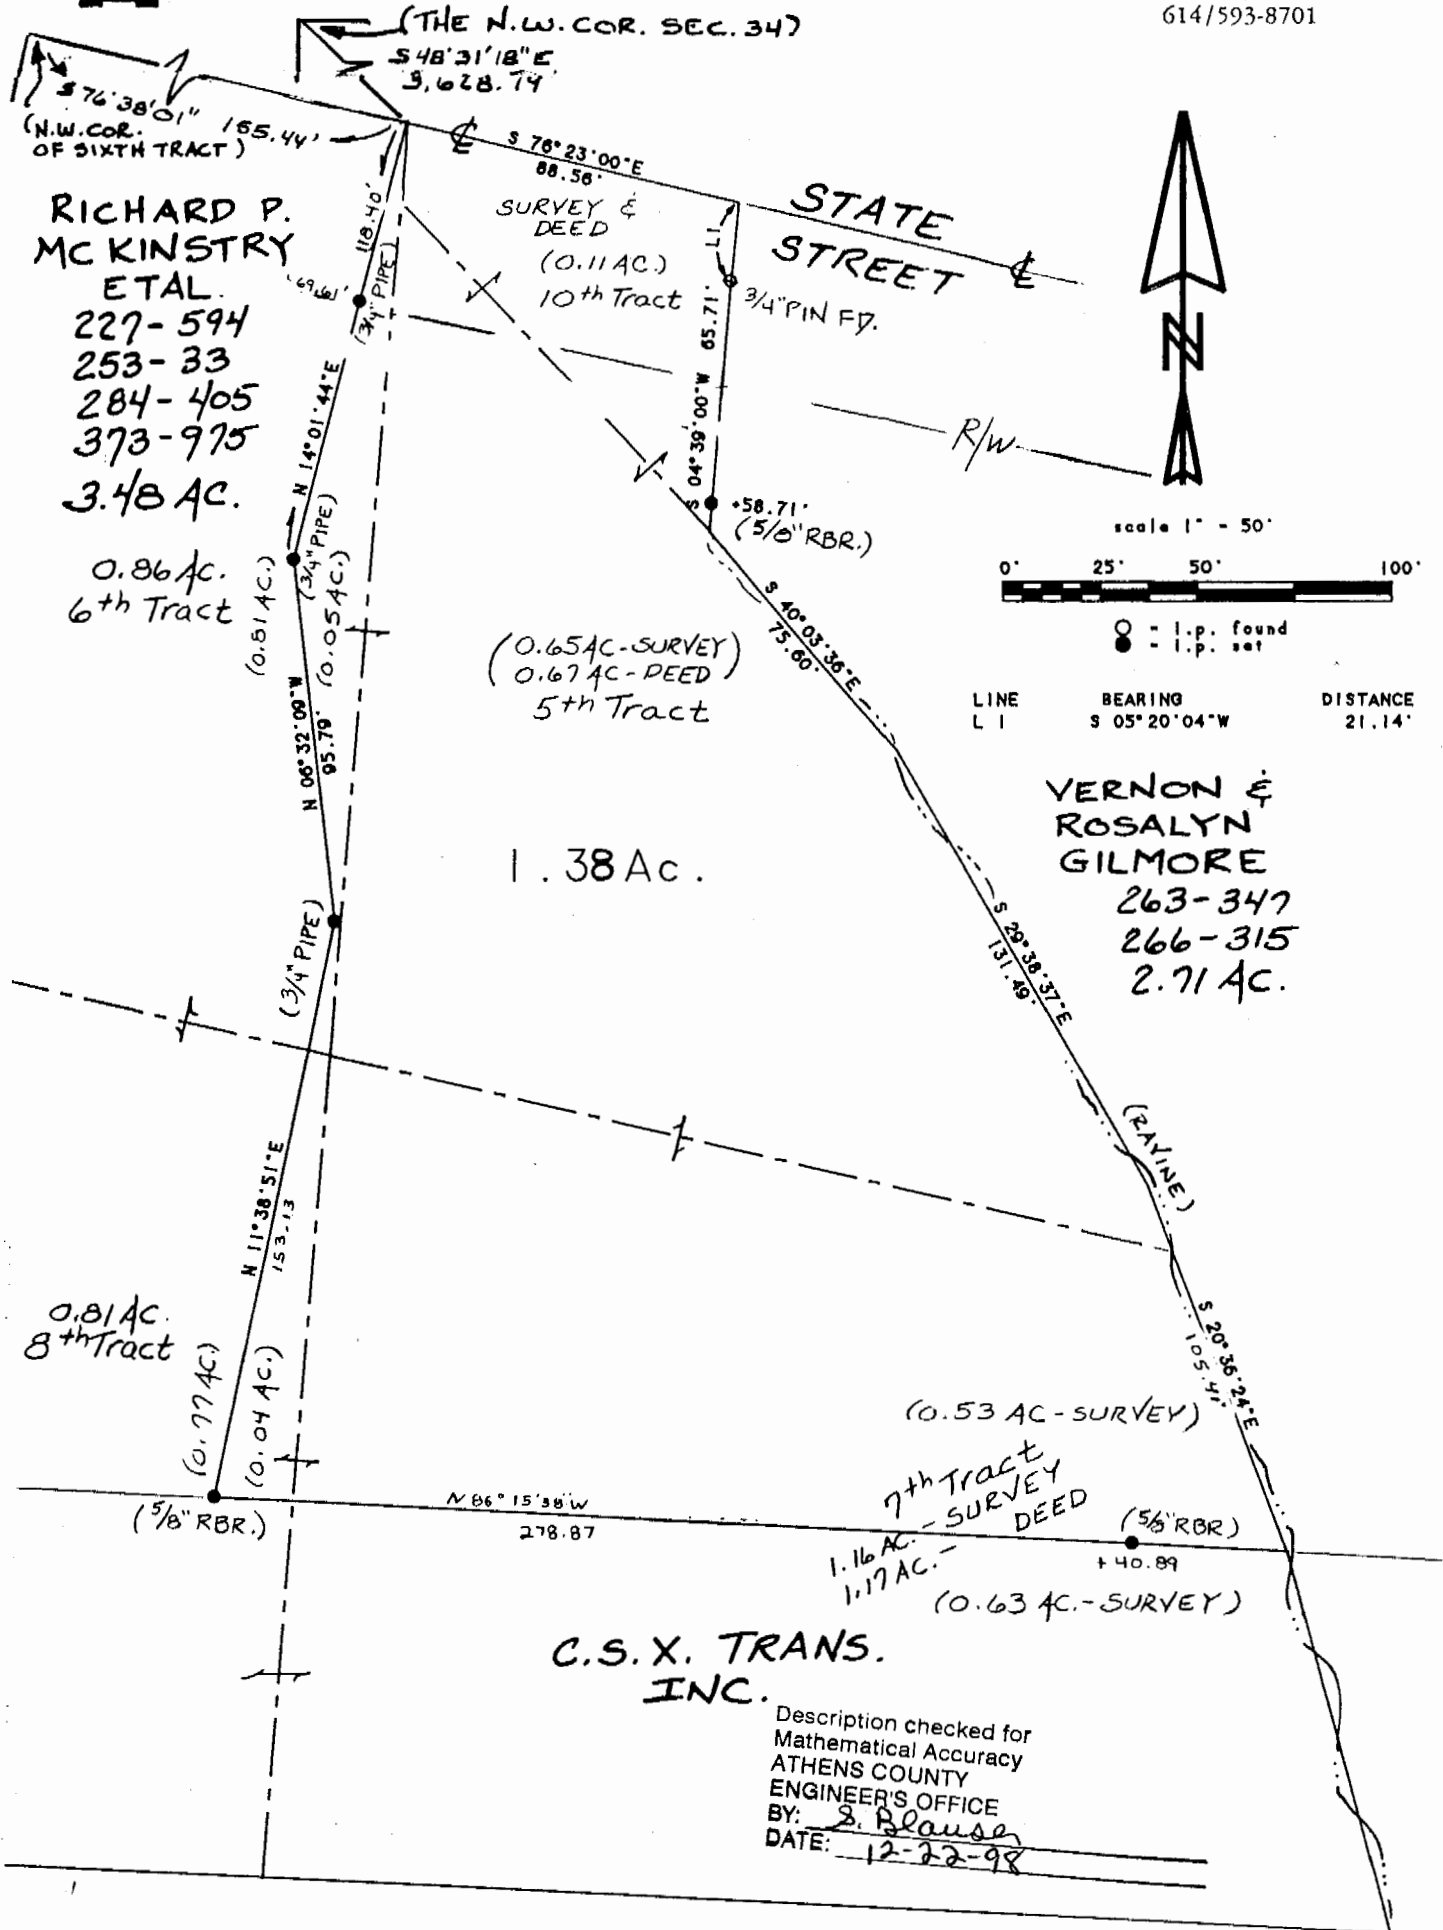

VERNON &  
ROSALYN  
GILMORE  
263-347  
266-315  
2.71 AC.

RICHARD P.  
MCKINSTRY  
ETAL.  
227-594  
253-33  
284-405  
373-975  
3.48 AC.  
  
0.86 AC.  
6th Tract

(0.65 AC - SURVEY)  
(0.67 AC - DEED)  
5th Tract  
  
1.38 AC.

0.81 AC.  
8th Tract

(0.53 AC - SURVEY)  
7th Tract  
SURVEY  
DEED  
1.16 AC.  
1.17 AC.  
(0.63 AC - SURVEY)

C.S.X. TRANS.  
INC.

Description checked for  
Mathematical Accuracy  
ATHENS COUNTY  
ENGINEER'S OFFICE  
BY: S. Blouse  
DATE: 12-22-98

Plat of Survey of a 1.38 Acre Tract \_\_\_\_\_ Scale 1" = 50'

Surveyed for Richard Mc Kinstry \_\_\_\_\_ Date 2/21/94

Subdivision \_\_\_\_\_

Township Canaan \_\_\_\_\_ Section 34 \_\_\_\_\_ Town 5 Range 13

Corporation Athens City \_\_\_\_\_ County Athens \_\_\_\_\_ State Ohio

Leonard F. Swoyer Jr.  
Leonard F. Swoyer Jr. Reg. Prof. Land Surveyor No. 6765

REV. 7/27/94  
REV. 12/22/98

79

CAN#34