

HIGHLAND SURVEYING
80 FAYETTE STREET
NELSONVILLE OHIO 45764
614-753-1264

Description of a 0.676 acre tract

Situate in Section 2, T-5, R-12, Carthage Township, Athens County, State of Ohio and being a part of a 60.00 acre tract as recorded in Vol. 1, page 122 of the Official Records of Athens County and being more particularly described as follows:

Beginning at a stone found that bears South 40°53'West, 3235.22 feet(calc.) from the Northeast corner of section 2

Thence along a fenceline South 7°45'40"West, 135.93 feet to an iron pin set

Thence along a fenceline North 69°16'34"East, 240.18 feet to an iron pin set in said fenceline

Thence leaving said fenceline North 7°01'43"West, 125.98 feet to a point in the center of Township road 119(passing an iron pin set at 105.19 feet)

Thence along the centerline of said road South 76°00'57"West, 192.66 feet to a point

Thence leaving said road South 7°45'40"West, 29.04 feet to the point of beginning and containing 0.676 acres.

Subject to all Easements and Rights of Way of Record

Bearings are to an assumed meridian and are used to denote angular relationships only


Kenneth E. Highland S-7581



Description checked for
Mathematical Accuracy
ATHENS COUNTY
ENGINEER'S OFFICE


BY: Gregoria King
DATE: 6-1-95

Carthage Twp. # 2

66

HIGHLAND SURVEYING

REGISTERED PROFESSIONAL LAND SURVEYOR

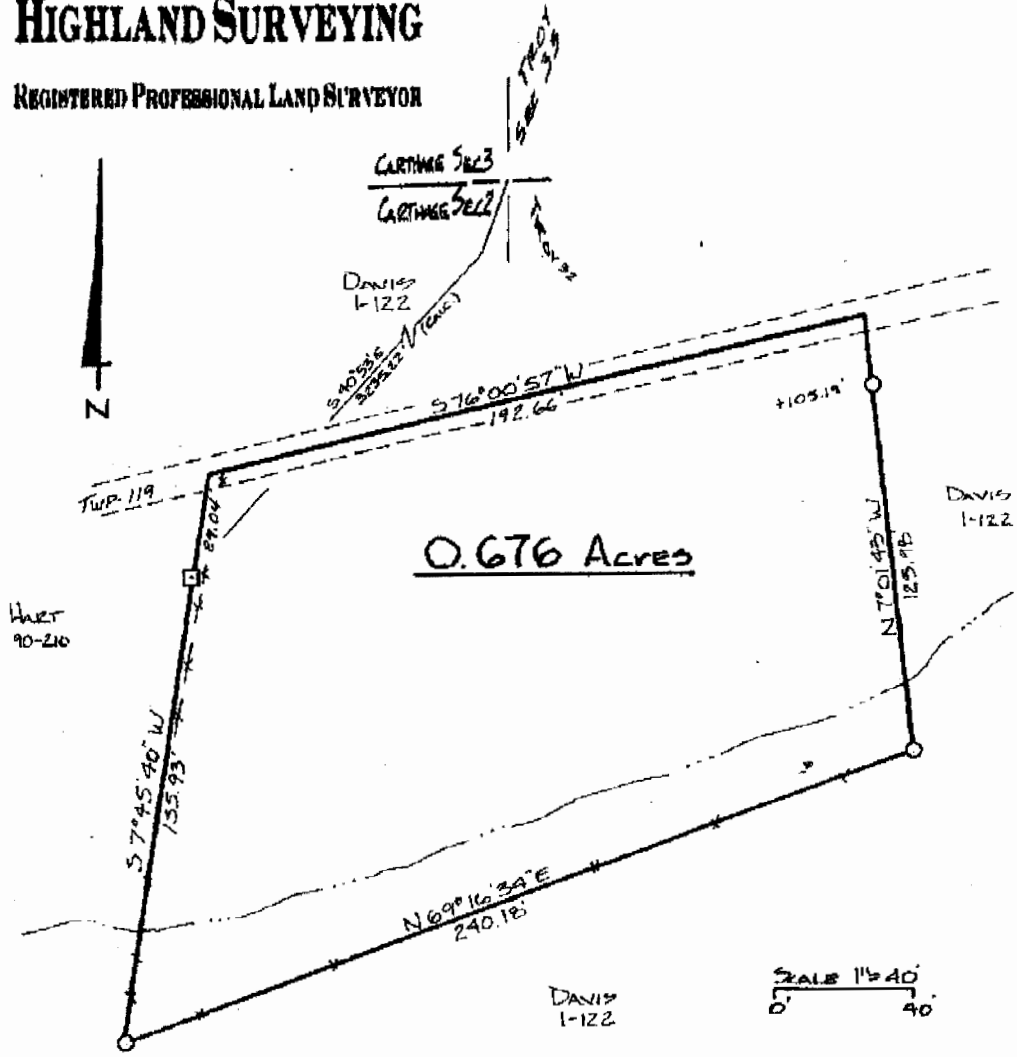

Acres
90-210

0.676 Acres

SCALE 1"=40'
0' 40'

O = Iron Pin Set
□ = Stone Found

PLAT of JURNEY OF A 0.676 ACRE TRACT
 SURVEYED for JENIE DAVIS
 SUBDIVISION _____
 TOWNSHIP CARTHAGE SECTION 2 TOWN 5 RANGE 12
 CORPORATION _____ COUNTY ATWELL'S STATE OHIO
 SCALE 1"= 40 DATE MAY 1995

KENNETH E. HIGHLAND
 80 FAYETTE STREET
 NELSONVILLE, OHIO 45764
 614-753-1264

Kenneth E. Highland
 Kenneth E. Highland S-7581

