

CANTER

SURVEYING & MAPPING

Rt. 2, Box 139A Glouster, OH 45732 [614] 767-2359 Description checked for Mathematical Accuracy ATHENS COUNTY ENGINEER'S OFFICE R. J. Melson BY:
DATE: 7-15-93

Situate in Fraction Section 17 (Auditors Tax Plat Section 22), Town 5, Range 12, Ohio Company Purchase, Carthage Township, Athens County, Ohio. Being a part of the Neoma. M Beisner parcel as recorded in Vol. 385, Pg. 613, Athens County Deed Records and further described as follows:

<u>Point-of-Beginning</u> being an iron pipe found in Twp. Rd. #108, said Point-of-Beginning being N54 43 06 W 1335.8 feet of the southeast corner of Fraction Section 17 (reference: survey of May 1982 by Greg Wright, P.S., copy of survey on file in mapping office of Athens County Auditor);

Thence from this Point-of-Beginning S89 59 28 W 1594.64 feet along the north line of G. and S. Bond parcel as described in Vol. 57, Pg. 500, Official Records, to an iron pin (reference: iron pipe and cap found at 20.00 feet, iron pin and cap set at 366.70 feet, and an iron pipe and cap found S52 30 55 W 79.99 feet);

Thence along the lines of J. C. Holliday 115.0 acre parcel described in Vol. 21, Pg. 123, Official Records, the following two courses:

N52 30 45 W 515.10 feet to an iron pin, N40 36 41 W 76.33 feet to an iron pin;

Thence N89 59 14 E 1485.30 feet along the south line of N. M. and C. W. Walker parcel described in Vol. 378, Pg. 377, Deed Records, to an iron pin and cap set;

Thence S28 25 00 E 365.63 feet to an iron pin and cap set;

Thence N89 59 28 E 375.13 feet to an iron pin and cap set in Twp. Rd. 108 (reference: iron pin found N20 26 13 W 99.26 feet);

Thence S 20 26 13 E 53.36 feet along said Twp. Rd. 108 to the Point-of-Beginning.

Containing 12.091 acres as surveyed 06-26-1992 by Robert C. Canter, P. S. 7226.

Plat of said survey is attached herewith and made a part thereof.

Subject to all legal easements, leases and rights-of-way.

Basis of Bearings: South line of 14.887 acre Beisner parcel being

Carthage 17

N89 59 28 E as described by survey of May 1982 by Greg Wright, P.S. Bearings are used to denote angular relationships only.

Iron pins set are $5/8" \times 30"$ rebar with plastic cap stamped "Canter P.S. 7226".



Rt. 2, Box 139A Glouster, OH 45732 [614] 767-2359

> Situate in Fraction Section 17 (Auditors Tax Plat Section 22), Town 5, Range 12, Ohio Company Purchase, Carthage Township, Athens County, Ohio. Being the remainder of the Neoma. M Beisner parcel as recorded in Vol. 385, Pg. 613, Athens County Deed Records and further described as follows:

Point-of-Beginning being an iron pin and cap set in Twp. Rd. #108, said Point-of-Beginning being N54 43 06 W 1335.8 feet, thence N20 26 13 W 53.36 feet from the southeast corner of Fraction Section 17 (reference: survey of May 1982 by Greg Wright, P.S., copy of survey on file in mapping office of Athens County Auditor);

Thence from this Point-of-Beginning S89 59 28 W 375.13 feet to an iron pin and cap set;

Thence N28 25 00 W 365.63 feet to an iron pin and cap set in the south line of N. M and C. W. Walker as described in Vol. 378, Pg. 377, Deed Records;

Thence N89 59 14 E 366.85 feet along said south line to a point in Twp. Rd. 108 (reference: iron pipe and cap found at 346.85 feet);

Thence along Twp. Rd. #108 the next two courses, S32 51 13 E 272.11 feet to an iron pin found; S20 26 13 E 99.26 feet to the Point-of-Beginning.

Containing 2.80 acres as surveyed 06-26-1992 by Robert C. Canter, P. S. 7226.

Plat of said survey is attached herewith and made a part thereof.

Subject to all legal easements, leases and rights-of-way.

Basis of Bearings: South line of 14.887 acre Beisner parcel being N89 59 28 E as described by survey of May 1982 by Greg Wright, P.S. Bearings are used to denote angular relationships only.

Iron pins set are 5/8" x 30" rebar with plastic cap stamped "Canter P.S. 7226".


Description chacked for Mathematical Accuracy ATHENS COUNTY ENGINEER'S OFFICE BY:

DATE:


R.J. Nelson

18

PLAT of SURVEY

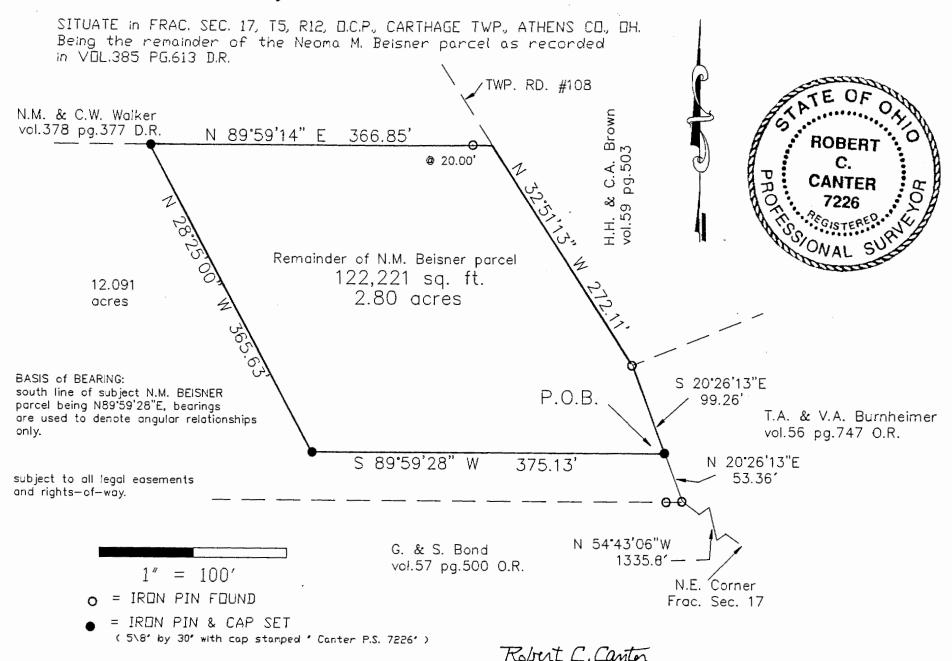

surveyed 6-26-1992 by ROBERT C. CANTER, P.S. #7226

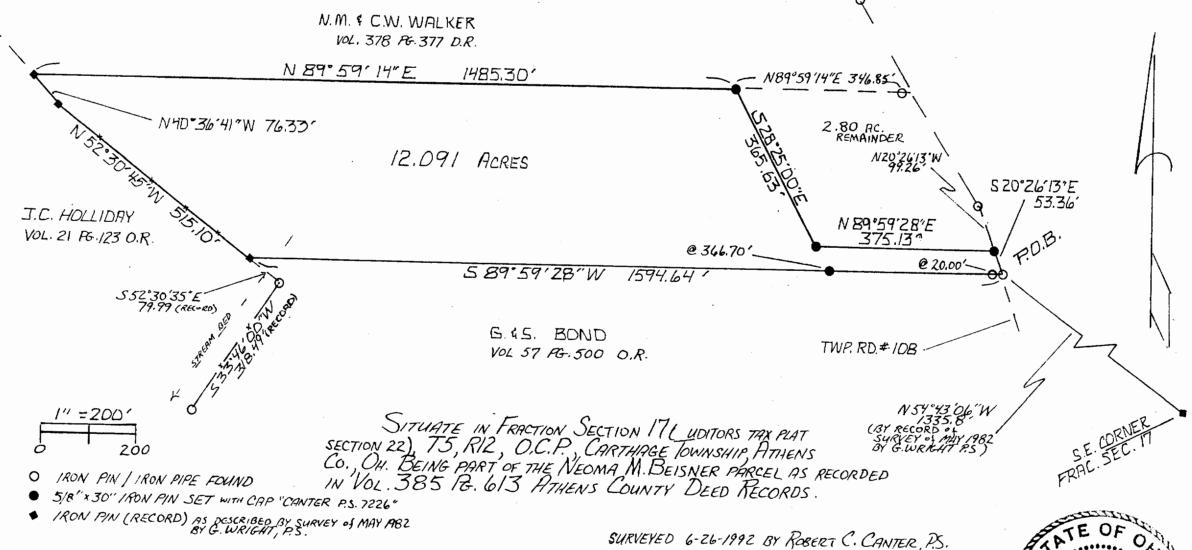

SUBJECT TO ALL LEGAL ERSEMENTS, LEASES AND RIGHTS - 0 - WAY. BASIS of BEARINGS: SOUTH LINE of 14.887 AC. BEISNER PARCEL BEING N89"59"28"E. BEARINGS ARE USED TO DENOTE ANGULAR RELATIONSHIPS ONLY.

SURVEYED 6-26-1992 BY ROBERT C. CANTER, P.S.

Robert C. Cantes P.S. 7226

