

Sec 20


Sec 20
Dover

0.28ac
CHANCEY

of a part of
R.L. 342 Section 20 T.10, R.14,
Dover Twp. Athens Co. Ohio.

Surveyed for Carl Willis 6-2-62
by Joe L. Galvin
Reg. Sur. 1684.

R# 204-597 P

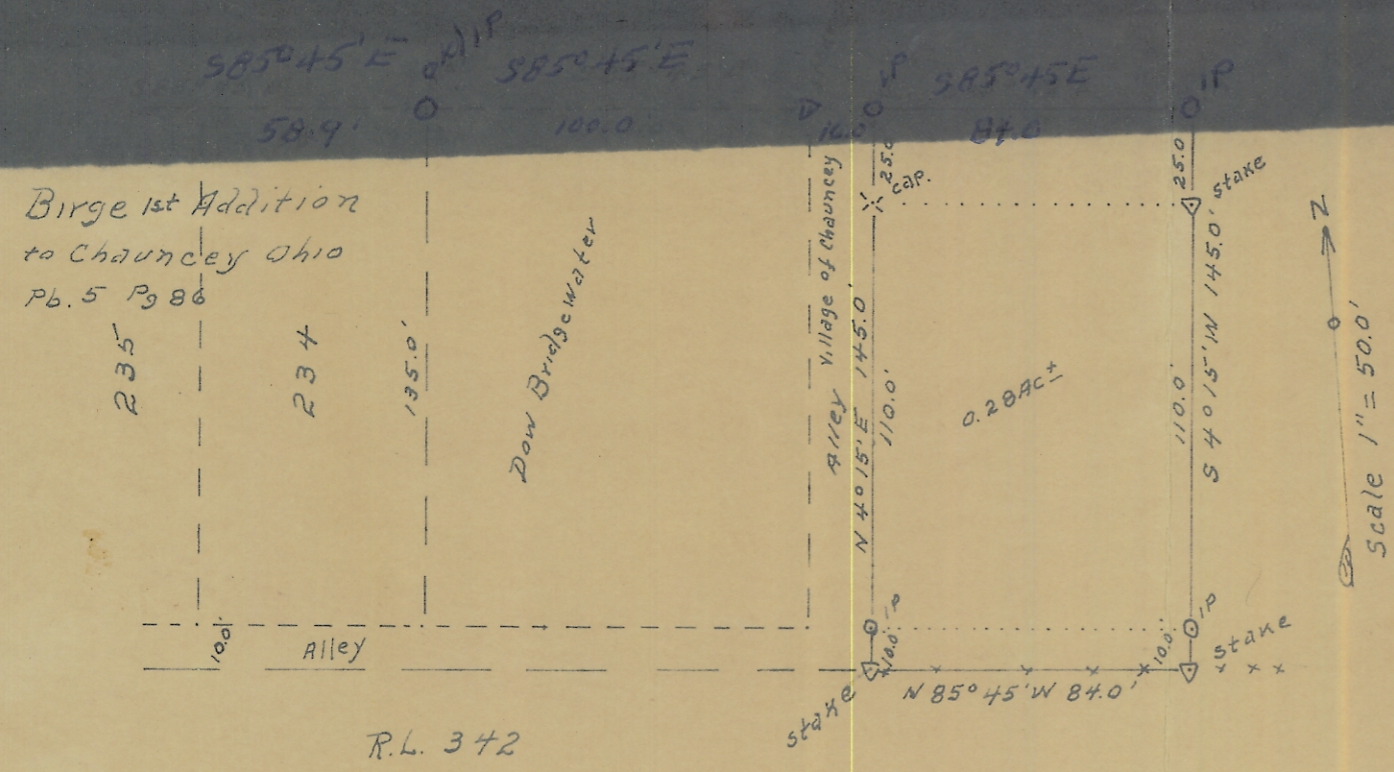

R.L. 342